


TOWNSHIP 40 S, RANGE 9 W, W. M.

North

RECEIVED  
NOV 18 1940  
STATE ENGINEER  
SALEM, OREGON

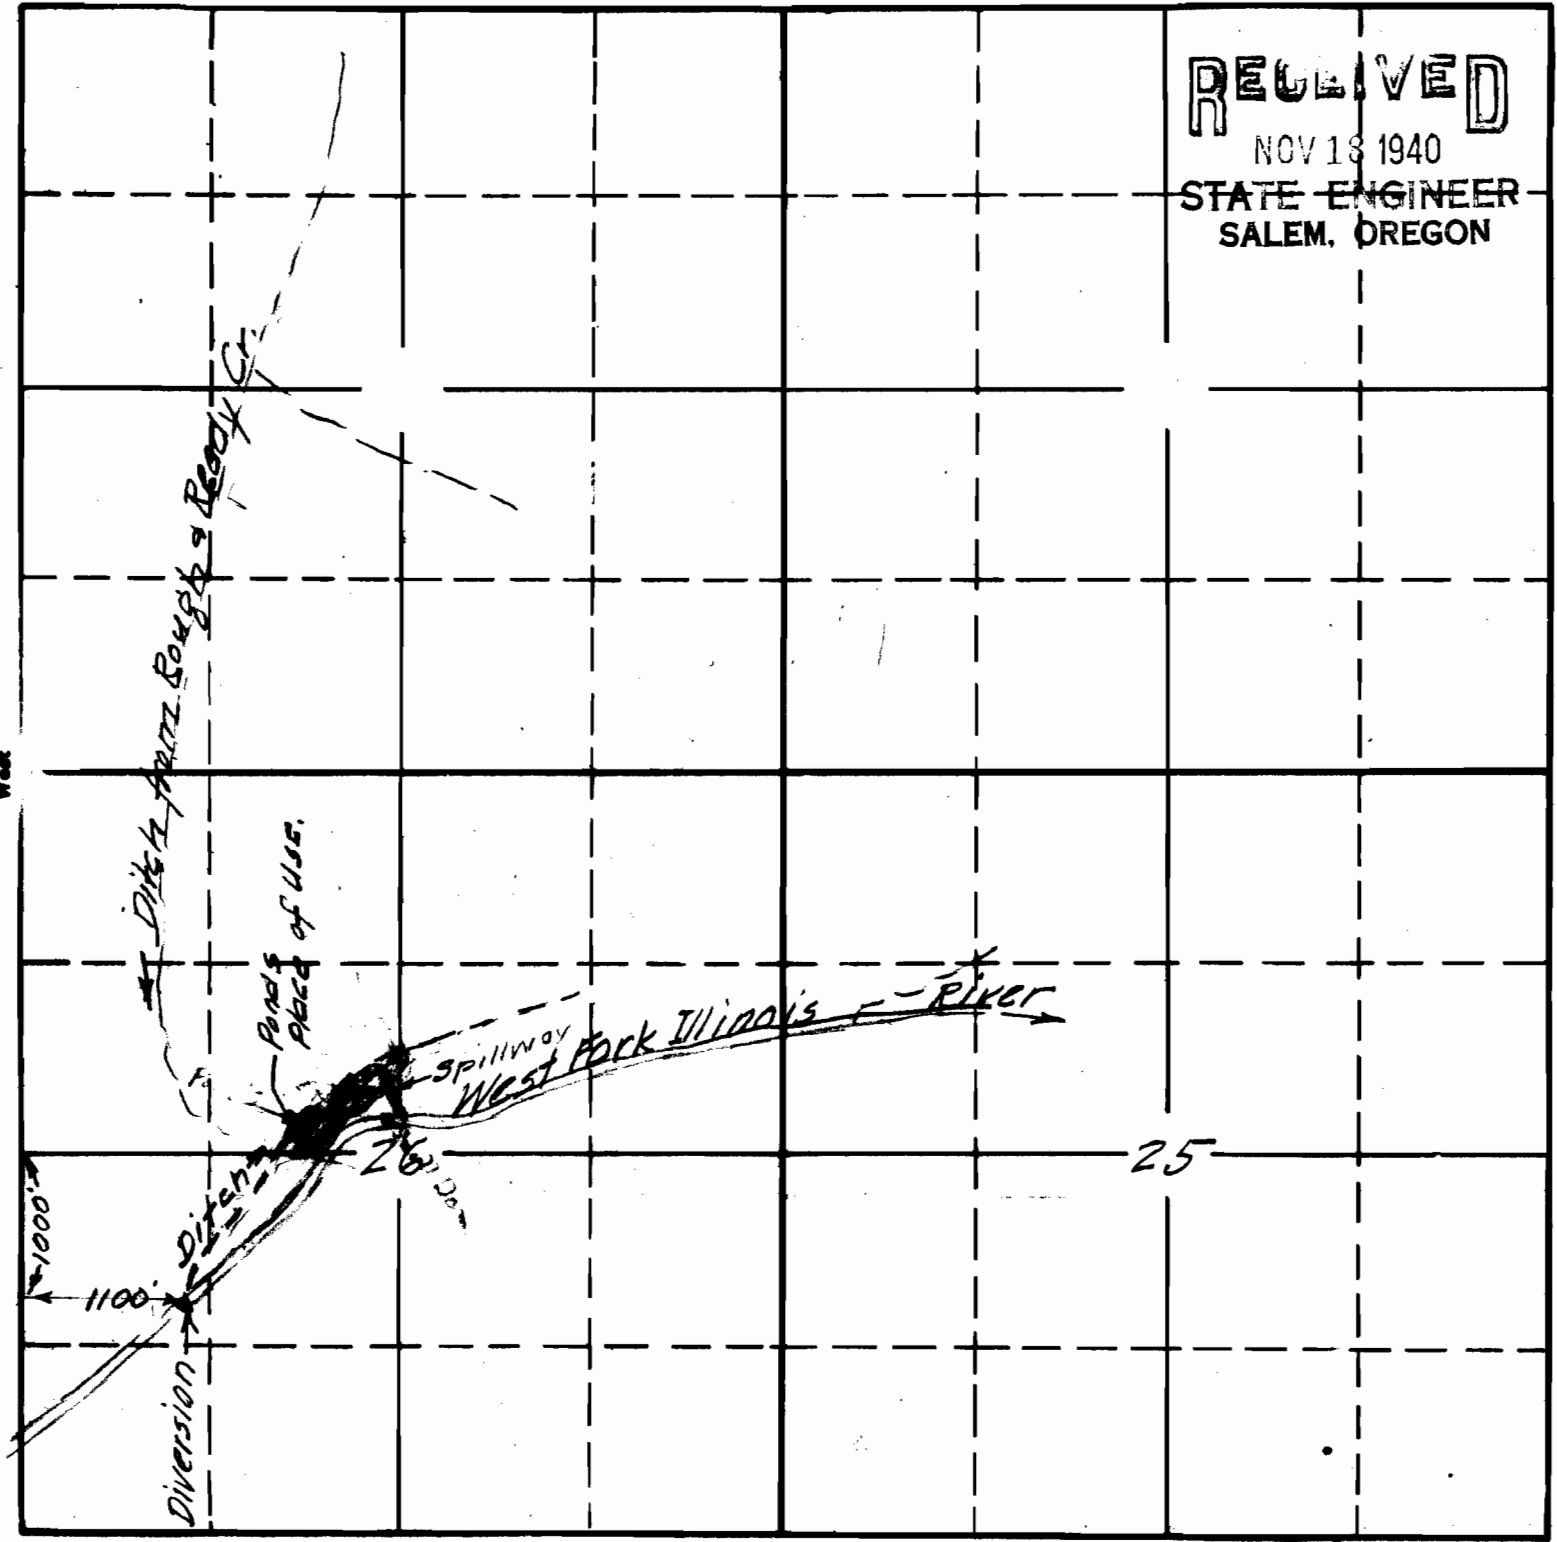

South

19089 DC  
15-56 A

Paul R. Schneider  
Nov. 1940

APPLICATION No. 19089  
PERMIT No. 14680

LONE Mt Valley Fish Hatchery.

O'Brien, Oregon