


SECTION

TOWNSHIP 30 S, RANGE 2 W, W. M.

North

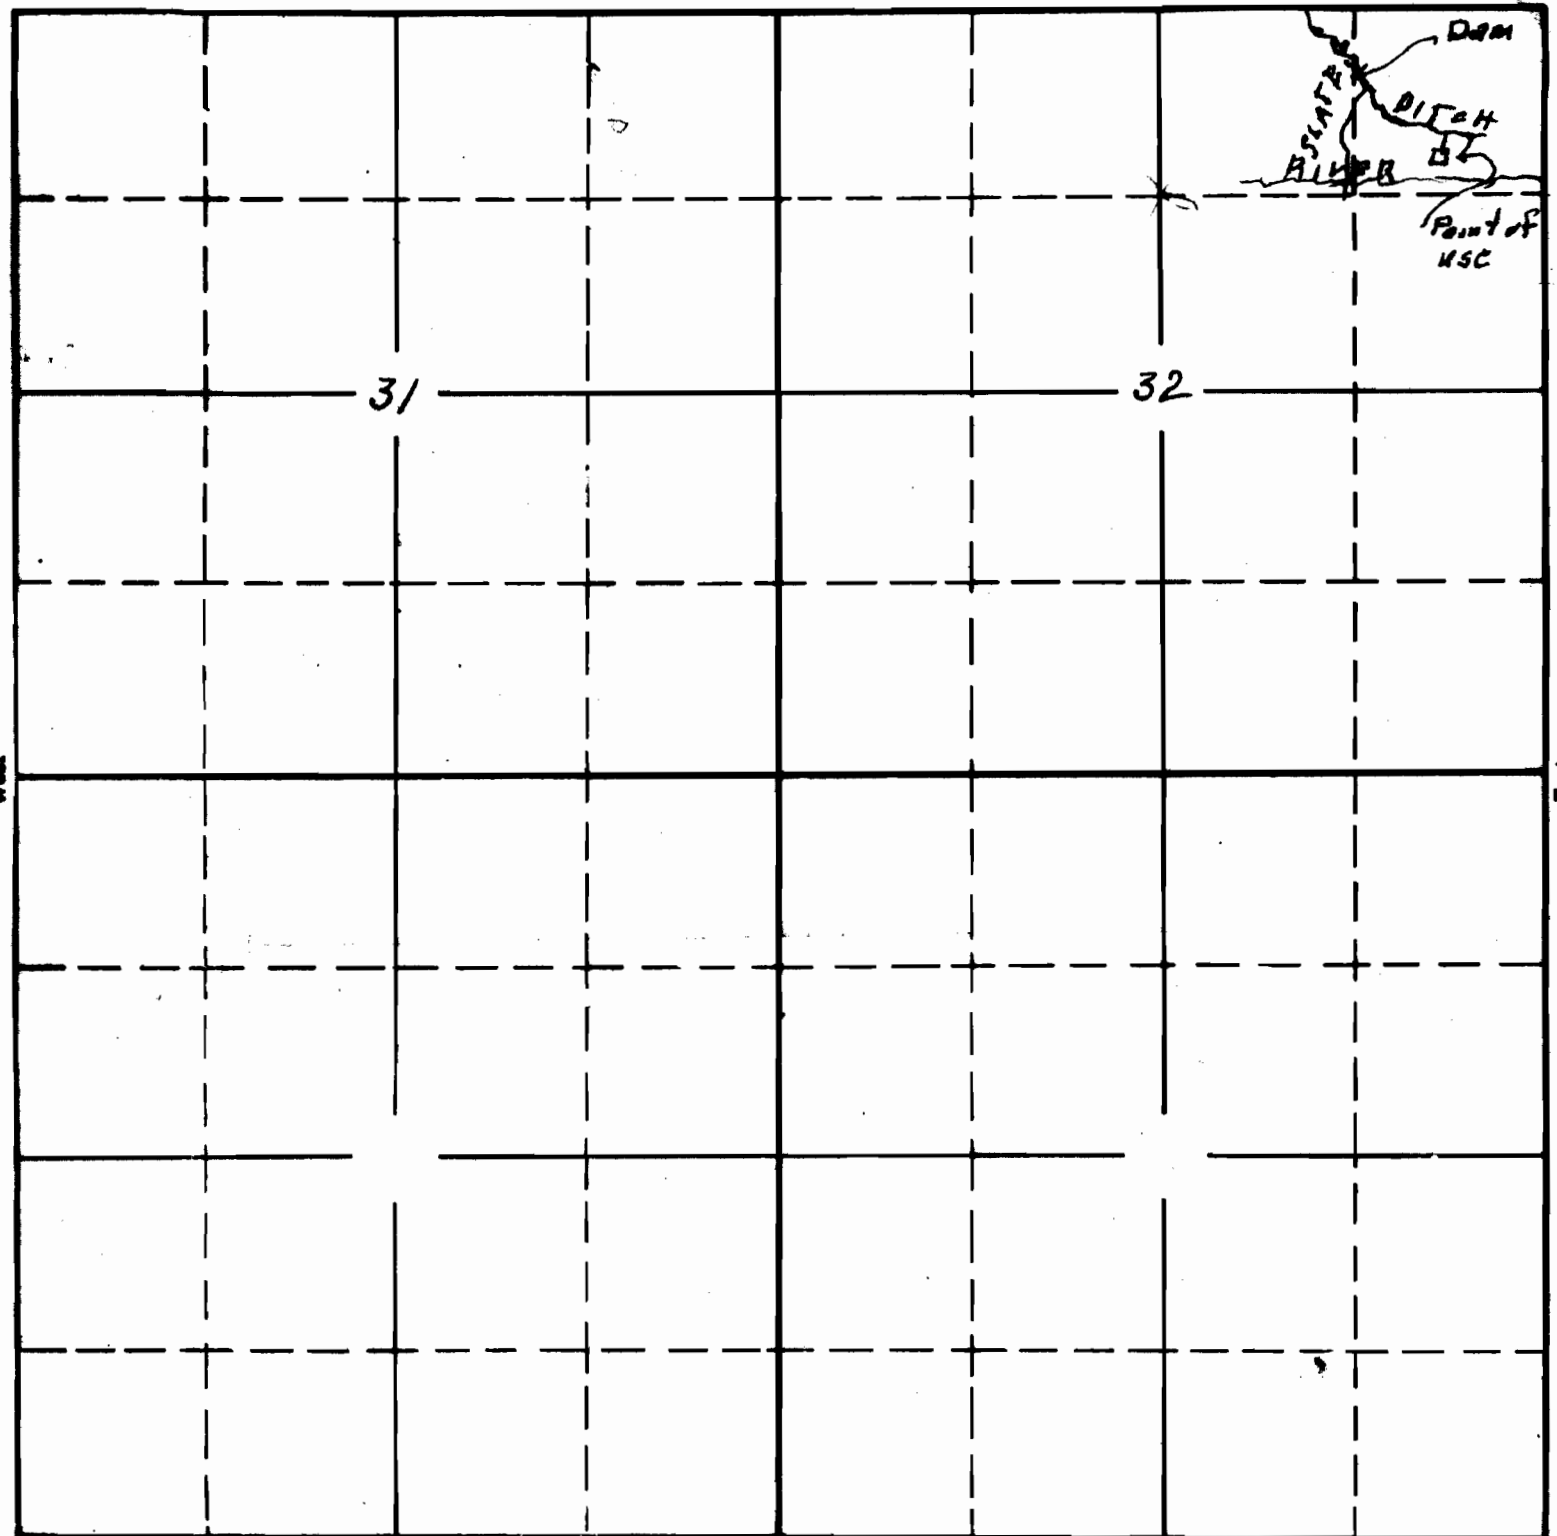

South

19186 OK
16-36

APPLICATION No. 19186

PERMIT No. 14783

RECEIVED


MAR 4 1941

STATE ENGINEER
SALEM OREGON

SECTION

TOWNSHIP 30S, RANGE 2W, W. M.

North

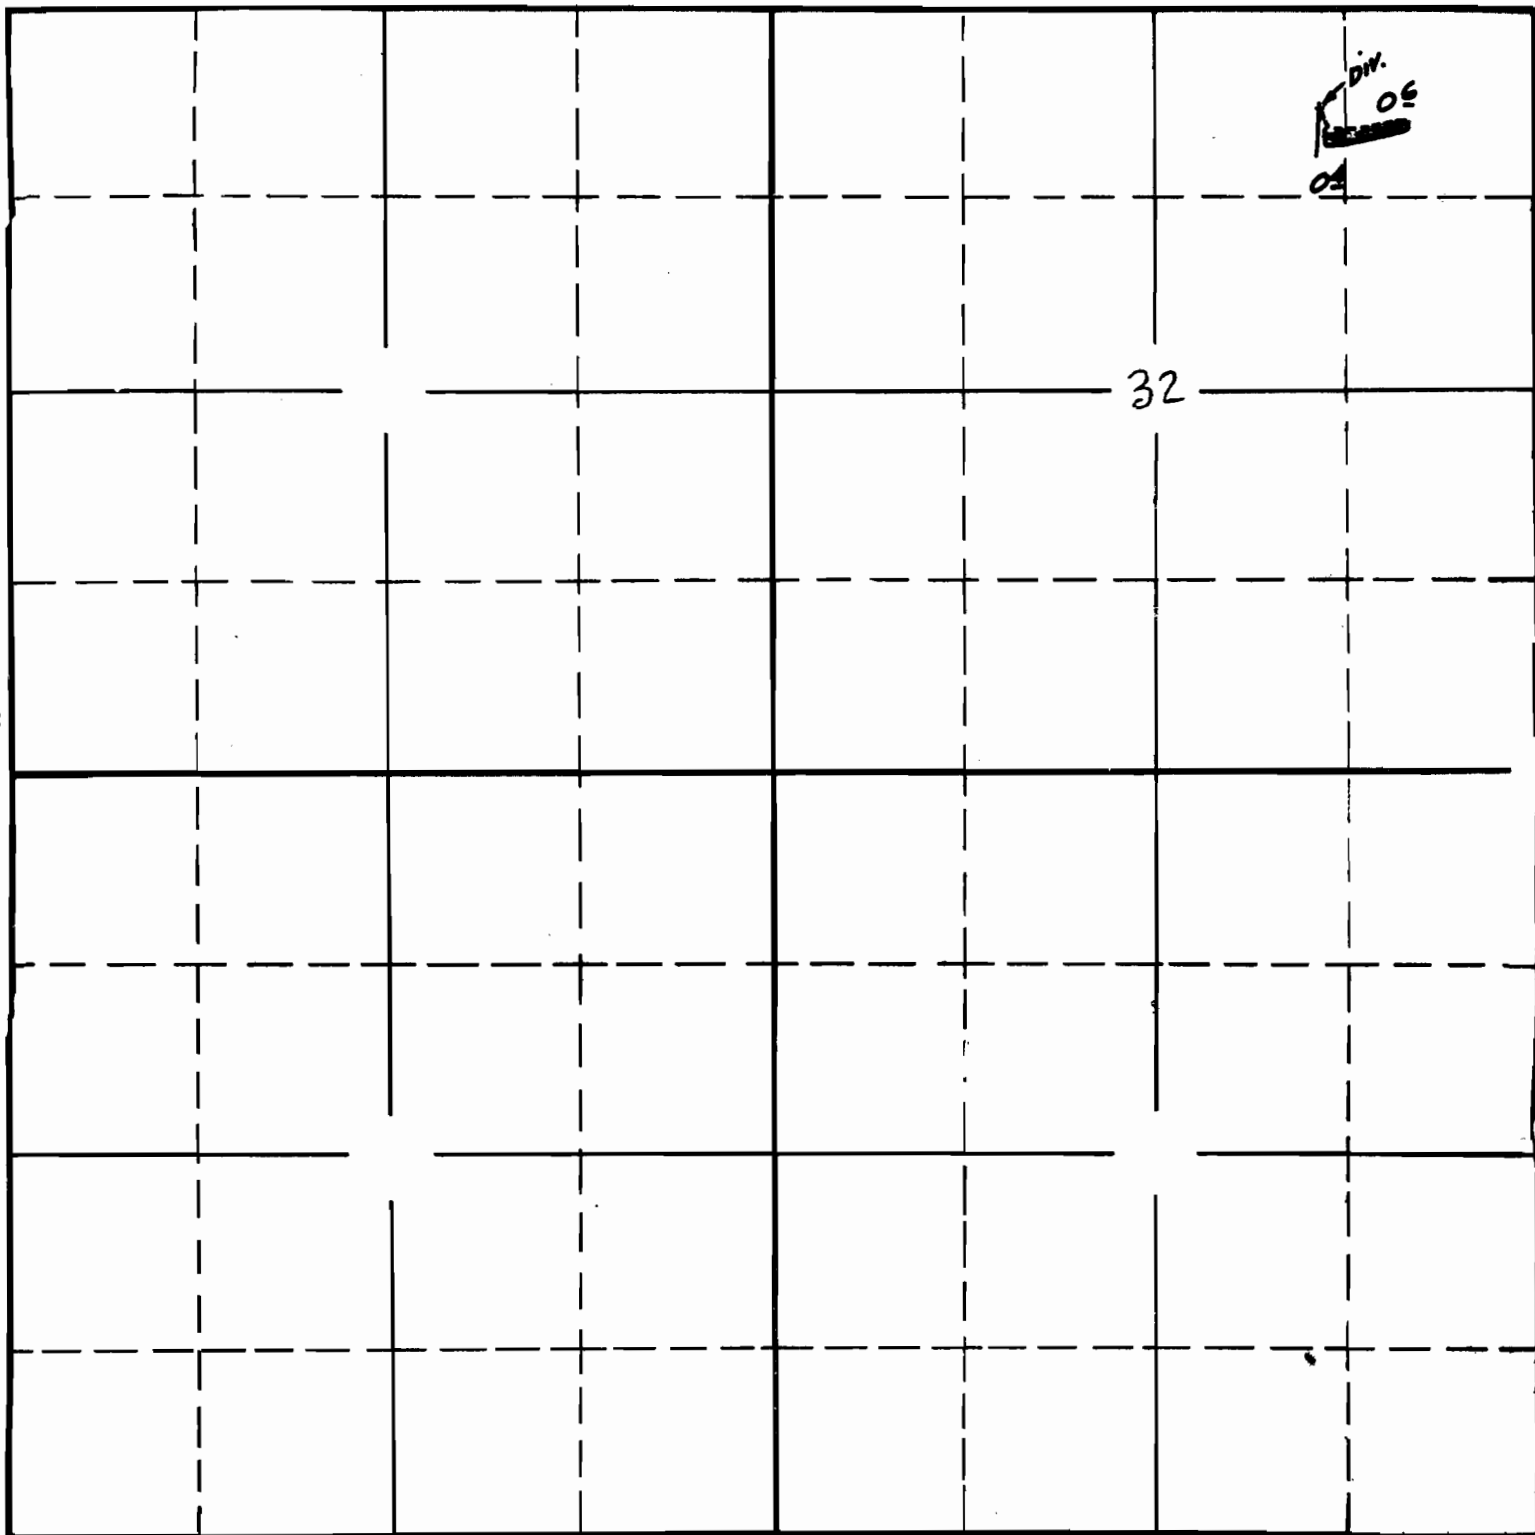

Div. 05
05

32

West

South

Surveyed June 10, 1941
C.A.B.

APPLICATION No. 19186
PERMIT No. 14783