


SECTION

Permit: S 17043
Volume: 6A
Strm: BLACK CANYON CR
Trib: APPLGATE R
Priority: 6/06/46

TOWNSHIP 37 S, RANGE 5 N

North

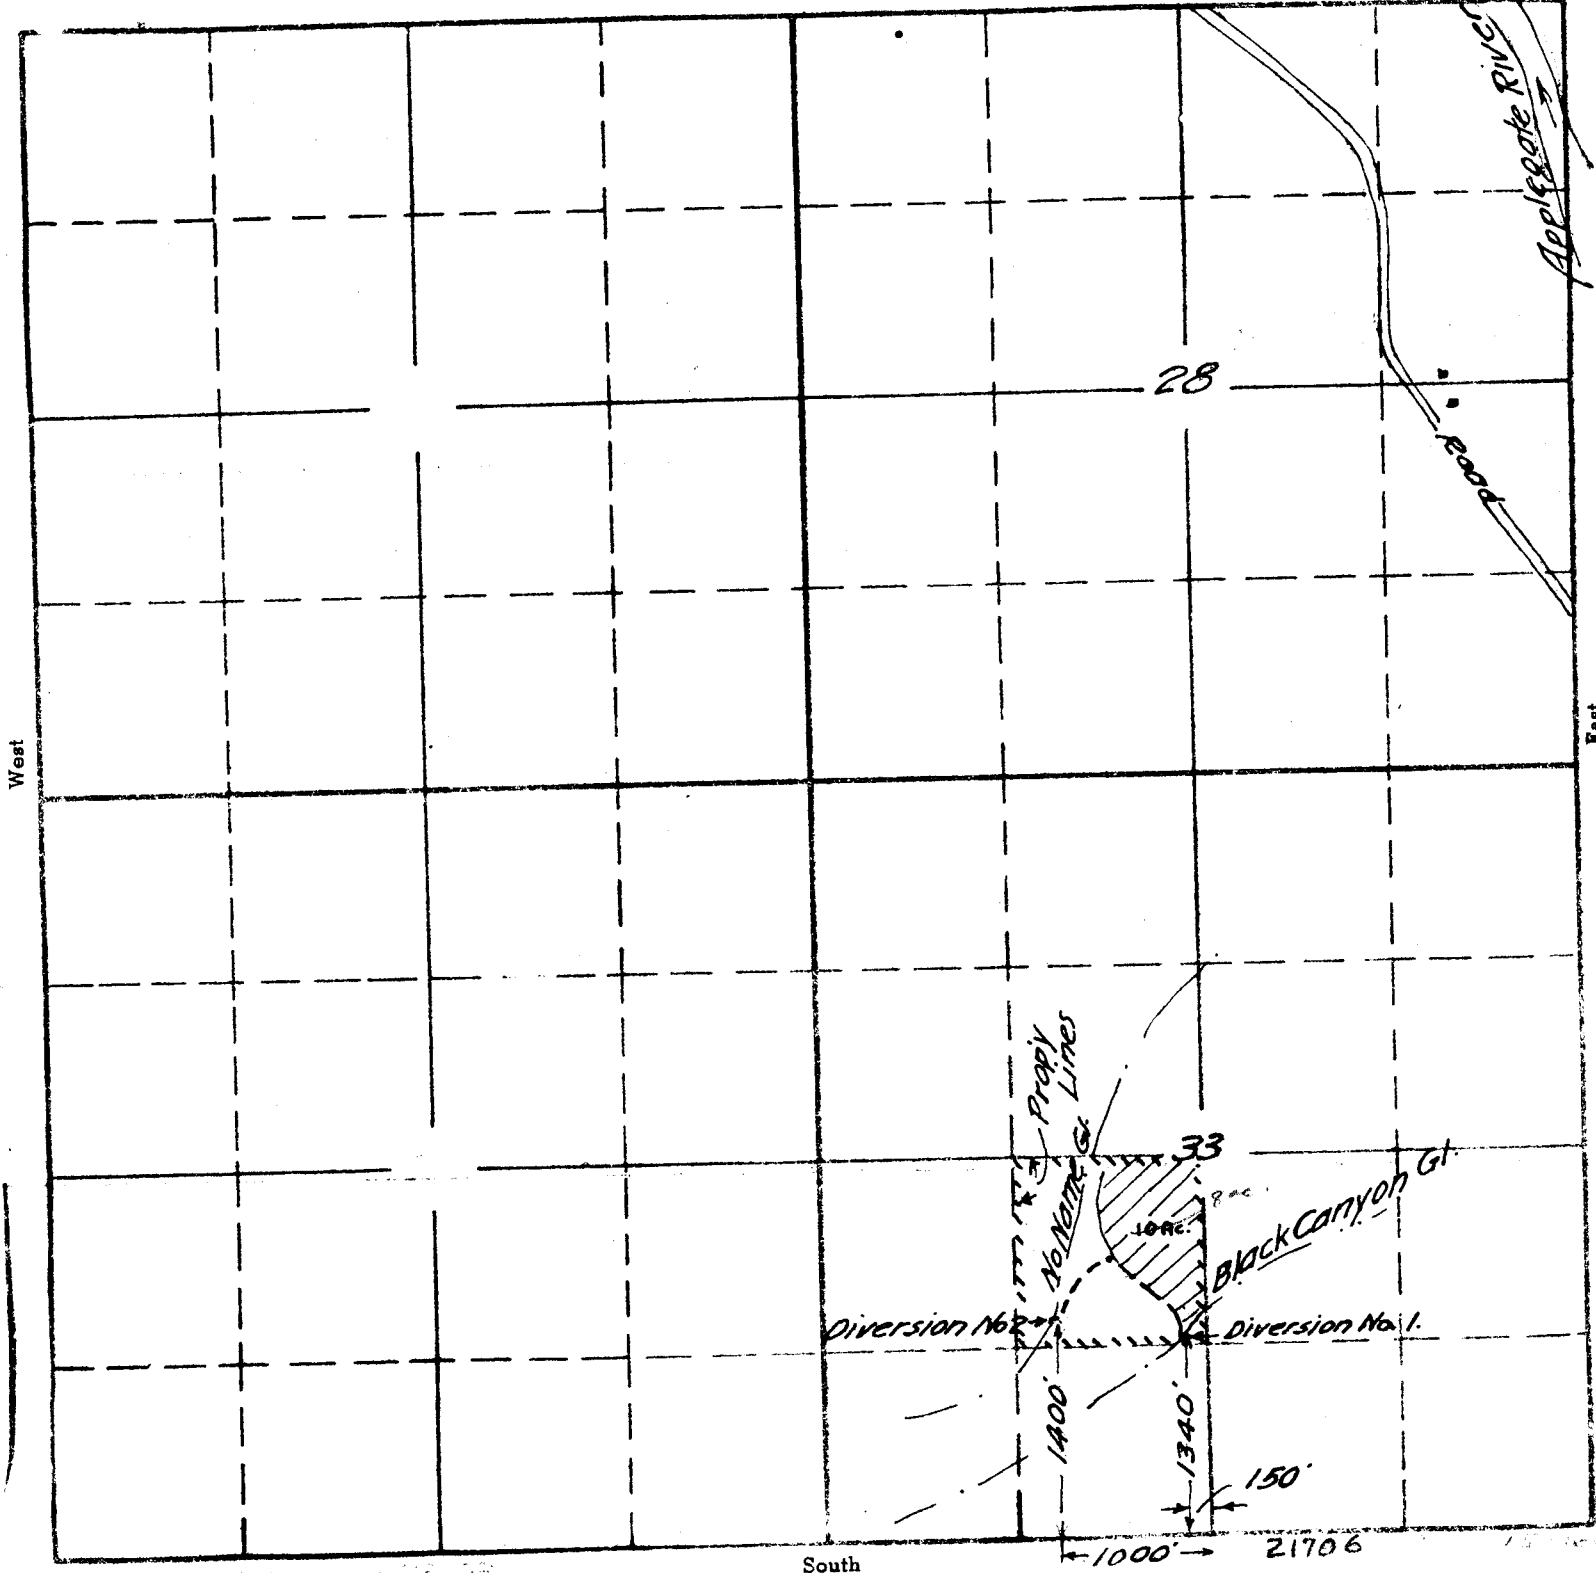

South

George W. Harrison
June 1946

APPLICATION No. 21706
PERMIT No. 17043