


SECTION

9

TOWNSHIP 33 S., RANGE 10 W., W. M.

North

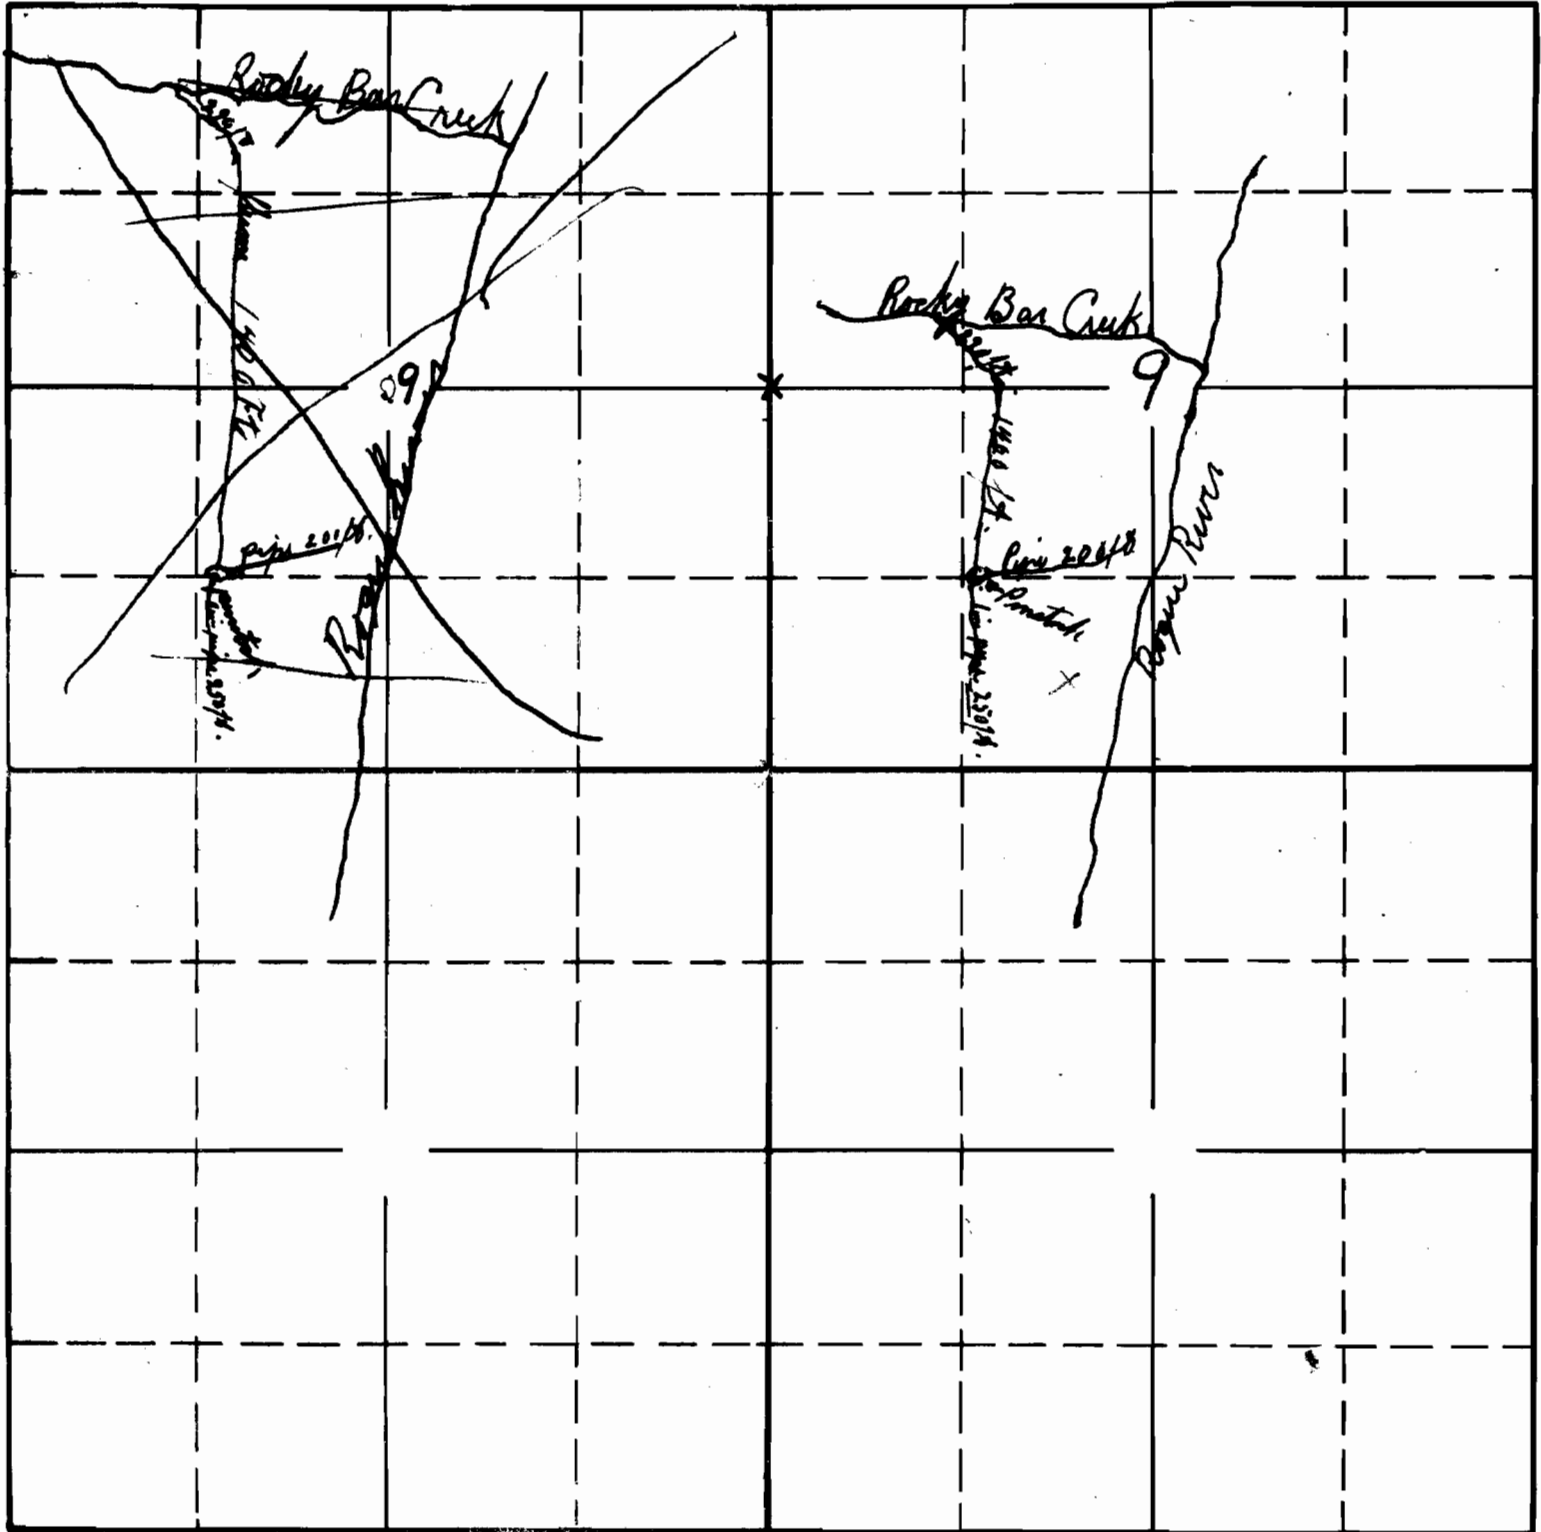

RECEIVED

MAR 7 1941

STATE ENGINEER
SALEM, OREGON

RECEIVED

MAR 18 1941

STATE ENGINEER
SALEM, OREGON

South

19194 or
15-78

APPLICATION No. 19194

PERMIT No. 14790