


SECTION

35

Spring #3

TOWNSHIP 17S, RANGE 4W, W. M.

North

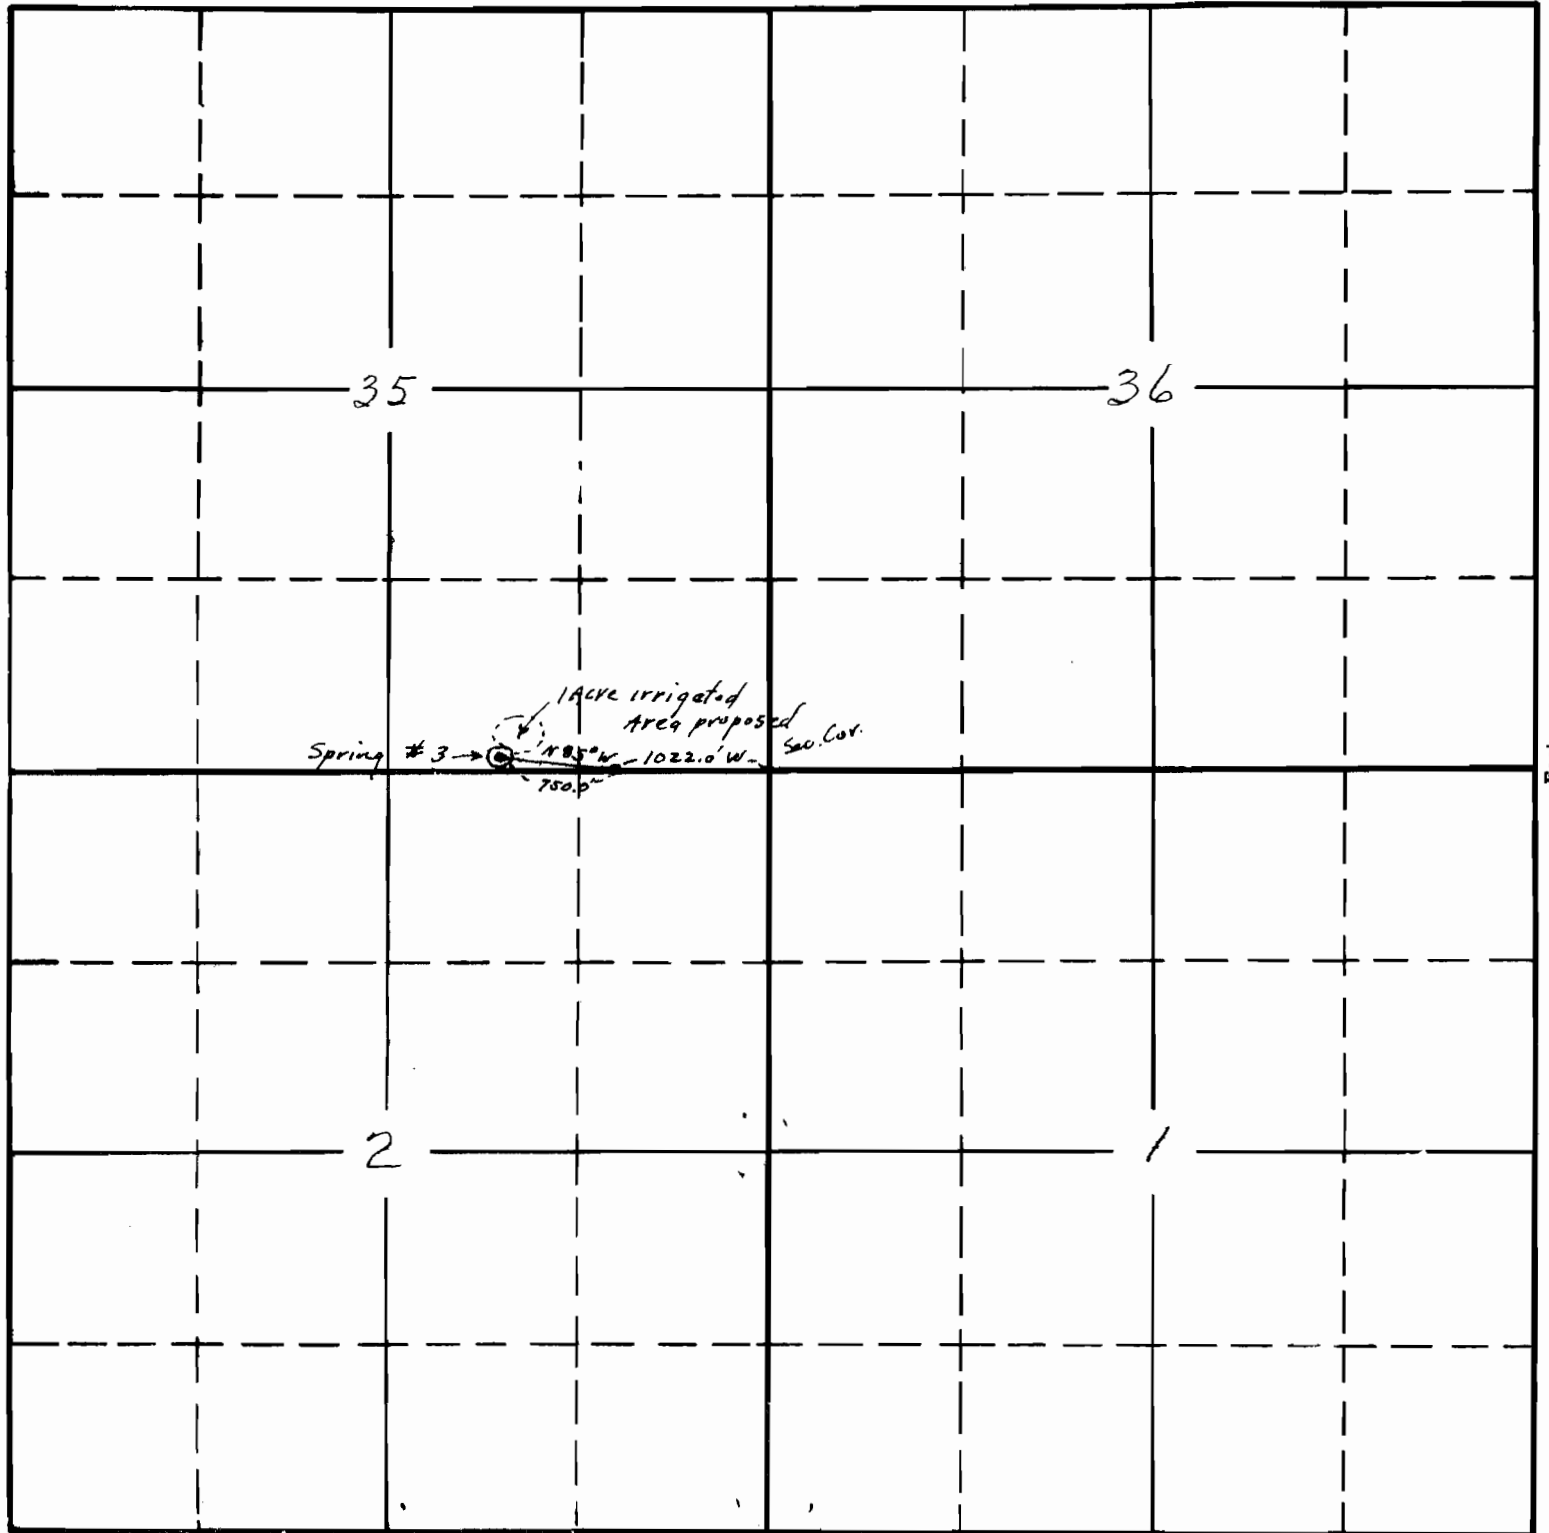

South

19195 OK  
 2-14  
 APPLICATION No. 19195  
 PERMIT No. 14791