


SECTION

2

Spring #1.

TOWNSHIP 185, RANGE 4W., W. M.

North

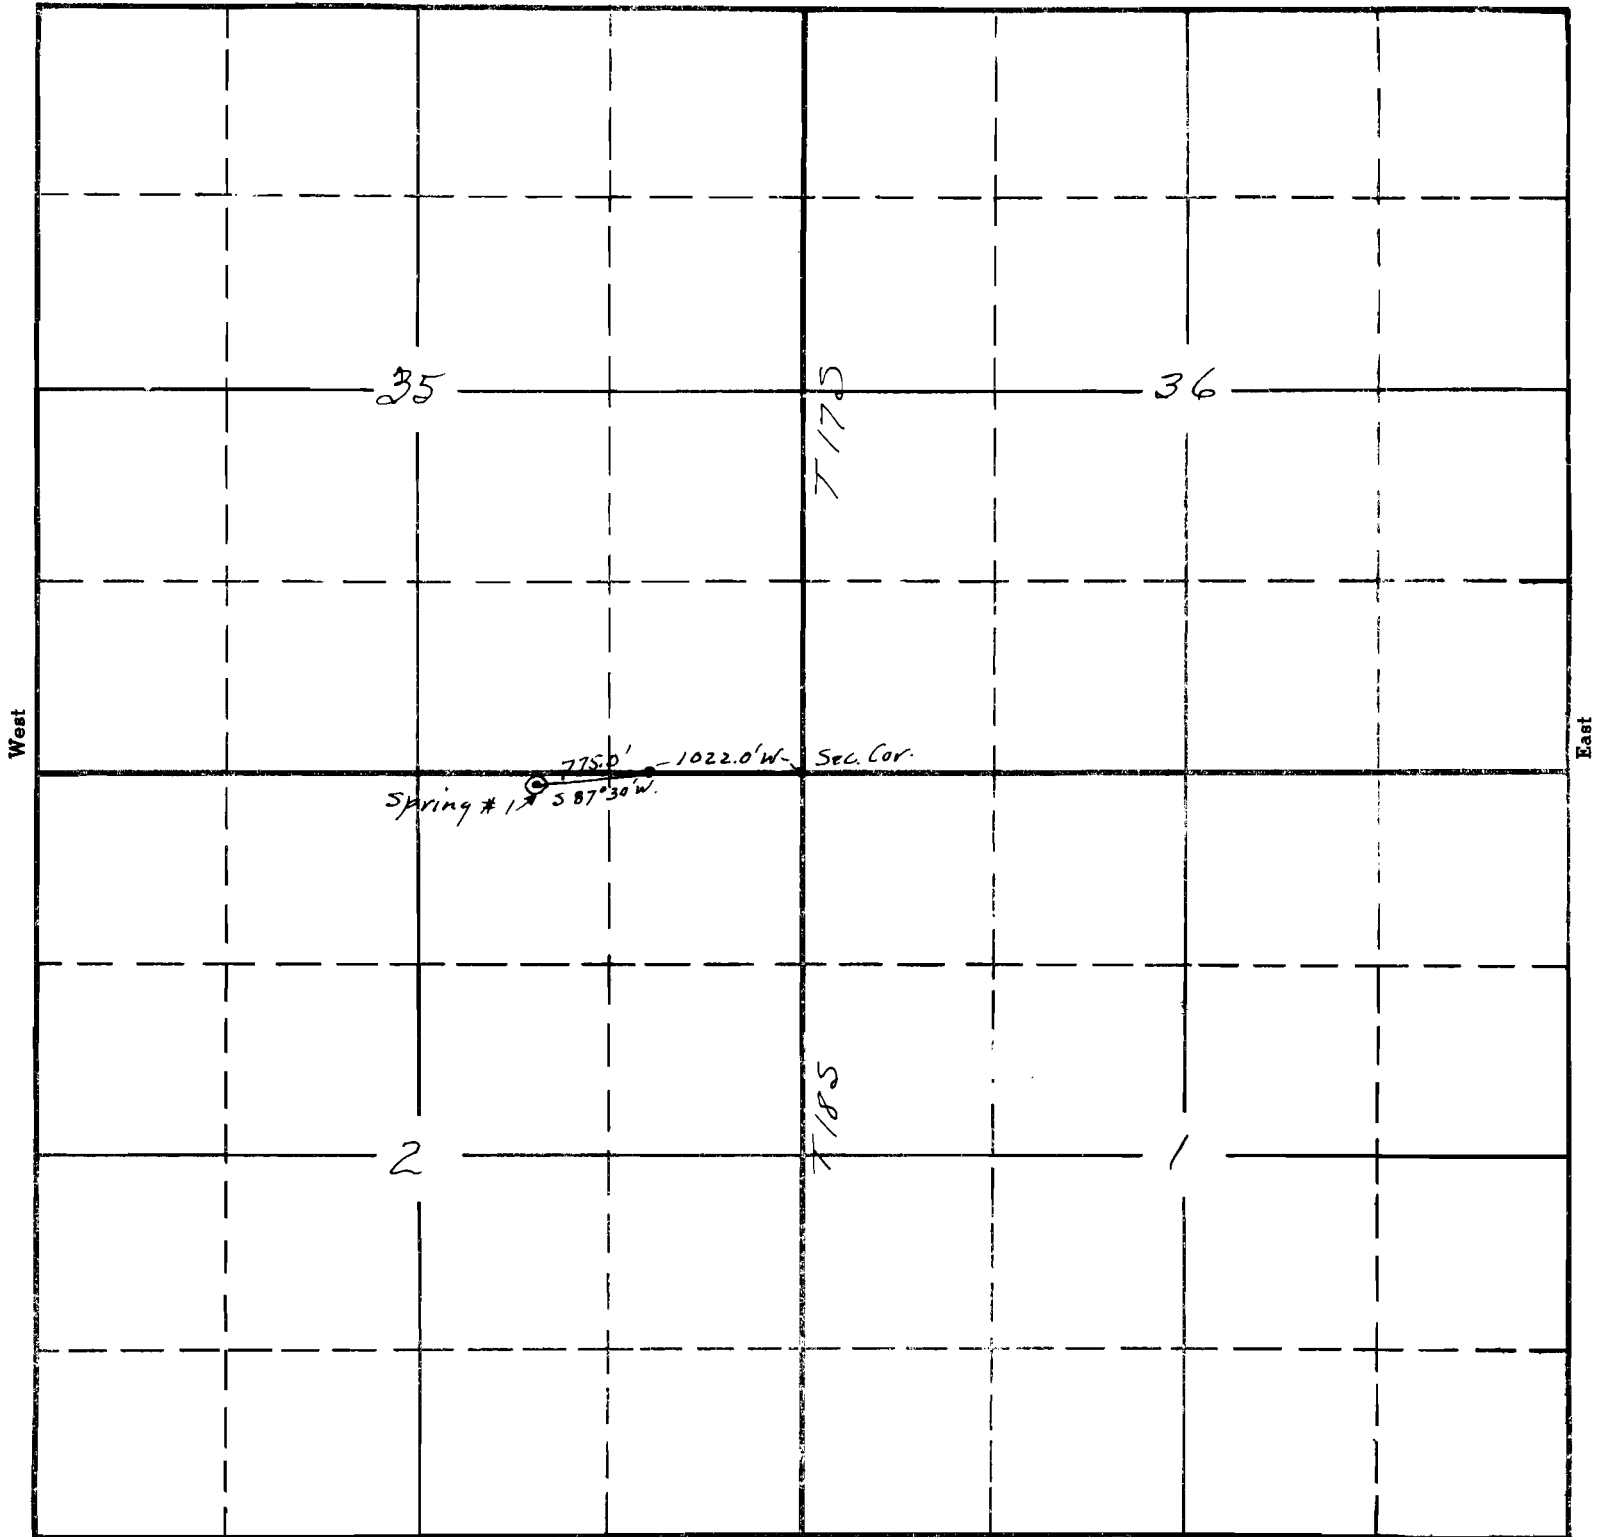

South

19196

APPLICATION No. 19196

PERMIT No. 14792

