

T.18S, R.8E, SECTION 32 X = NW CORNER, Section 32

BEND (U.S. 97) 32 MI.

S-8685D


7.5

1:62 500

596

47'30" 597

598

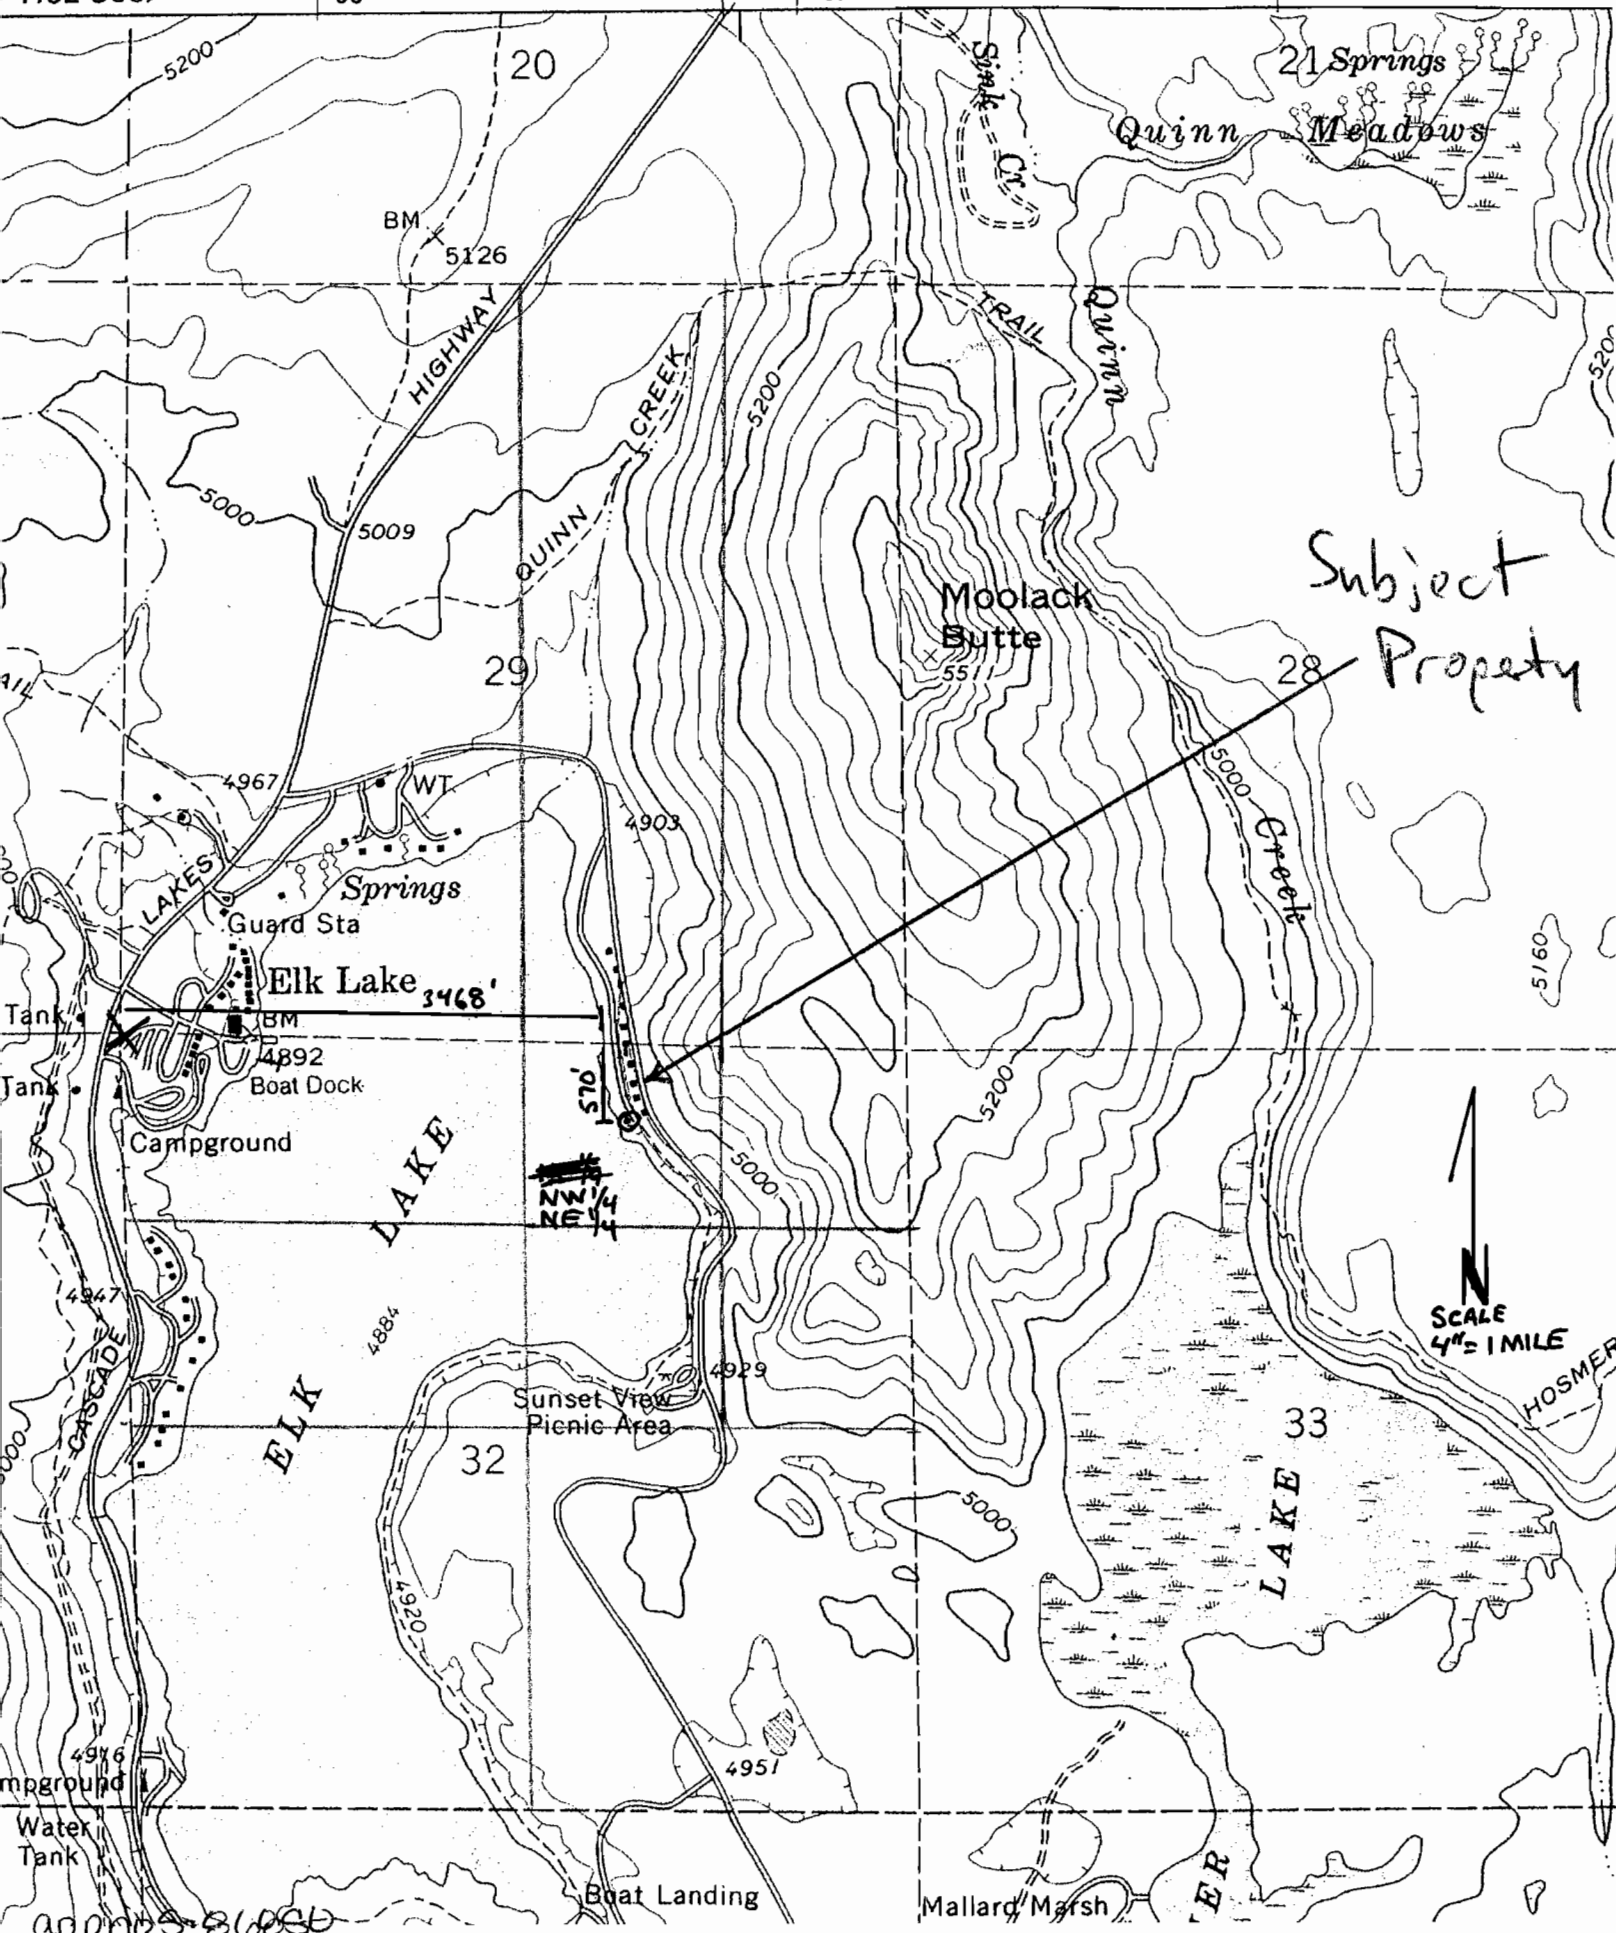

approx 86000