


SECTION

TOWNSHIP 96 S, RANGE 6 W, W. M.

North

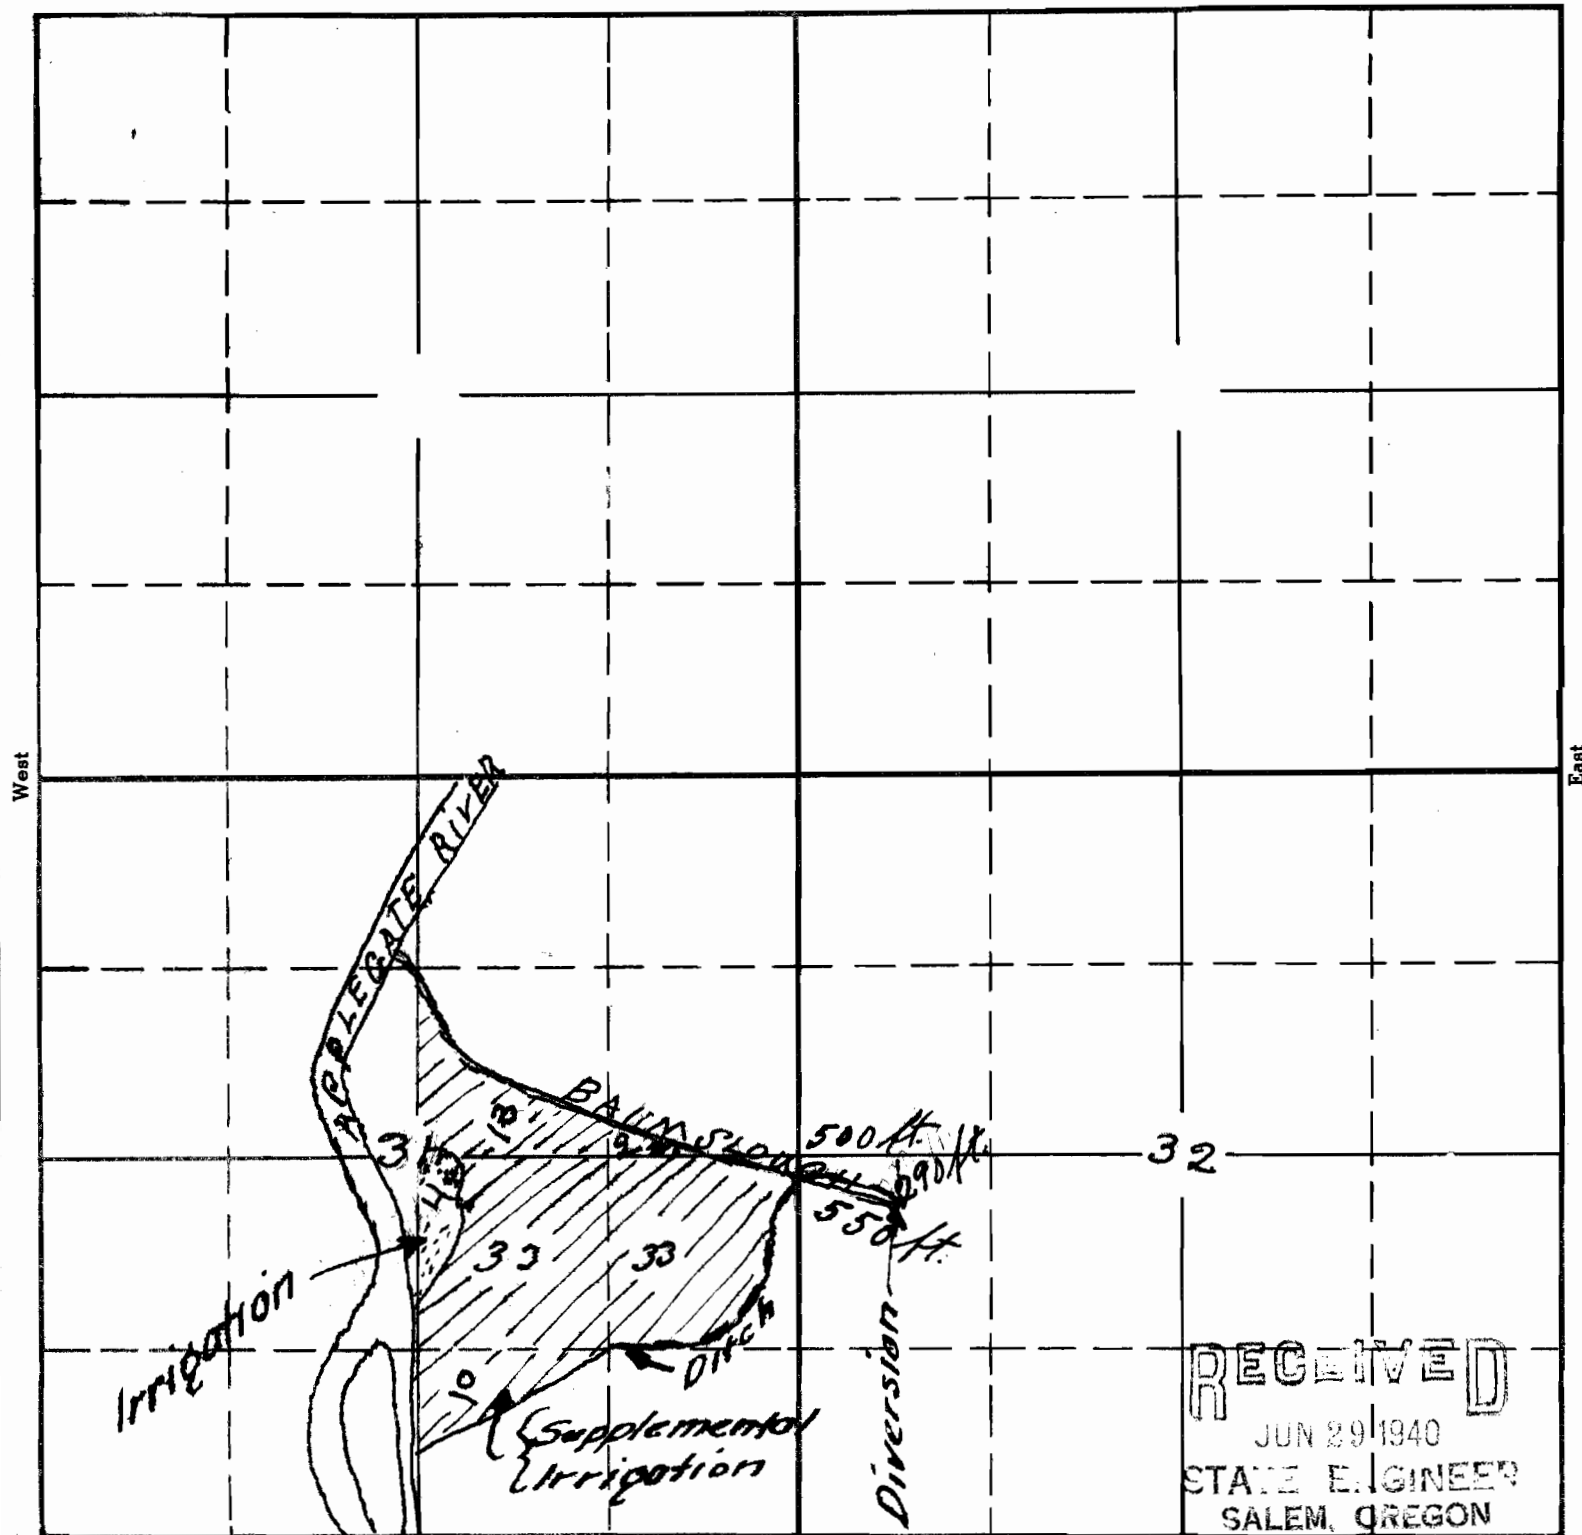

South

RECEIVED
 JUN 29 1940
 STATE ENGINEER
 SALEM, OREGON

18819 OC
 15-16 A
 APPLICATION No. 18819
 PERMIT No. 14841

June 1940