


SECTION

TOWNSHIP 32 S, RANGE 3 E, W. M.

North

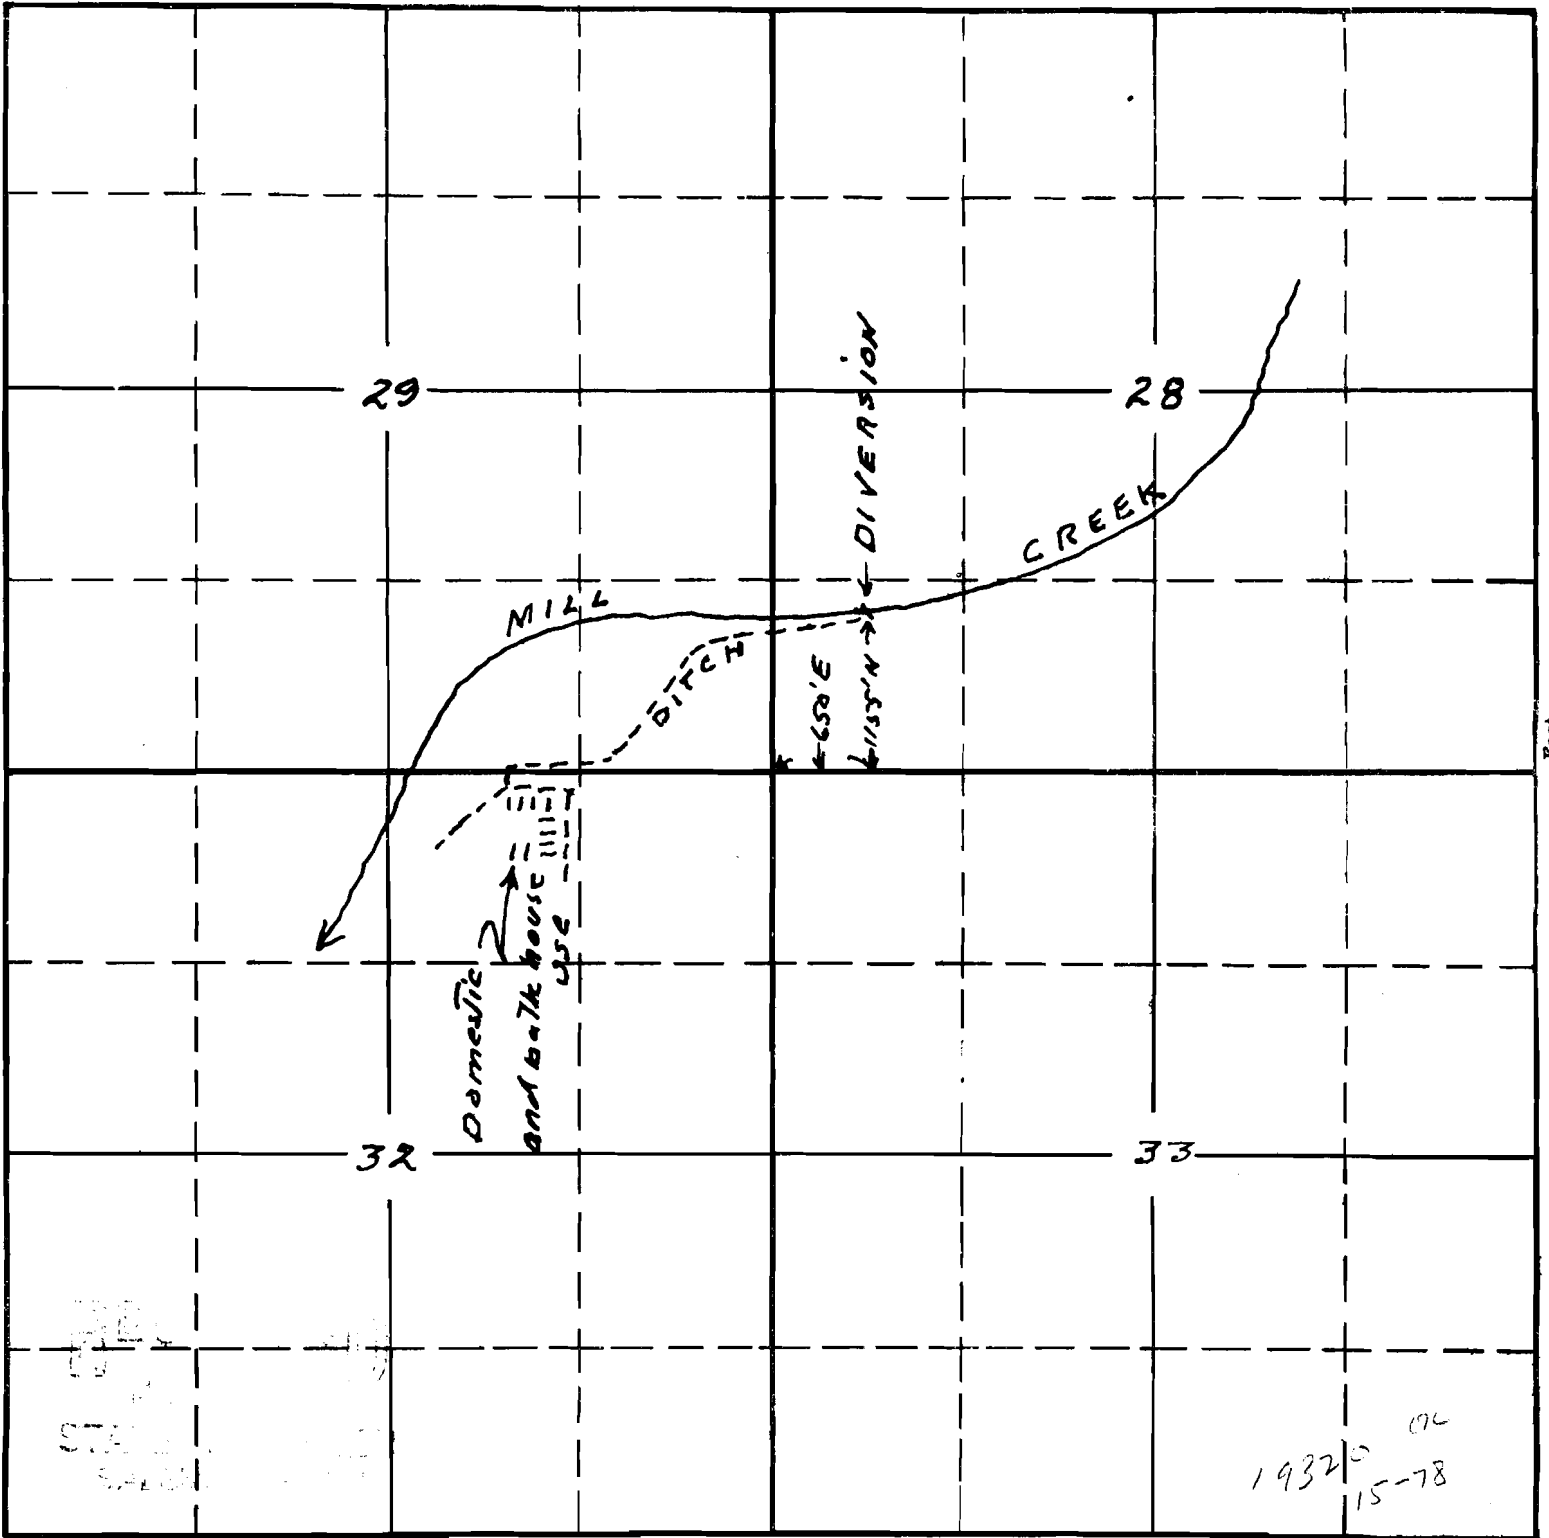

Sketch to accompany application of Francis P Selters for use of Mill Creek for domestic and bath house purposes

APPLICATION No. 19320
PERMIT No. 14902

This office 5/12/41 *Almond*