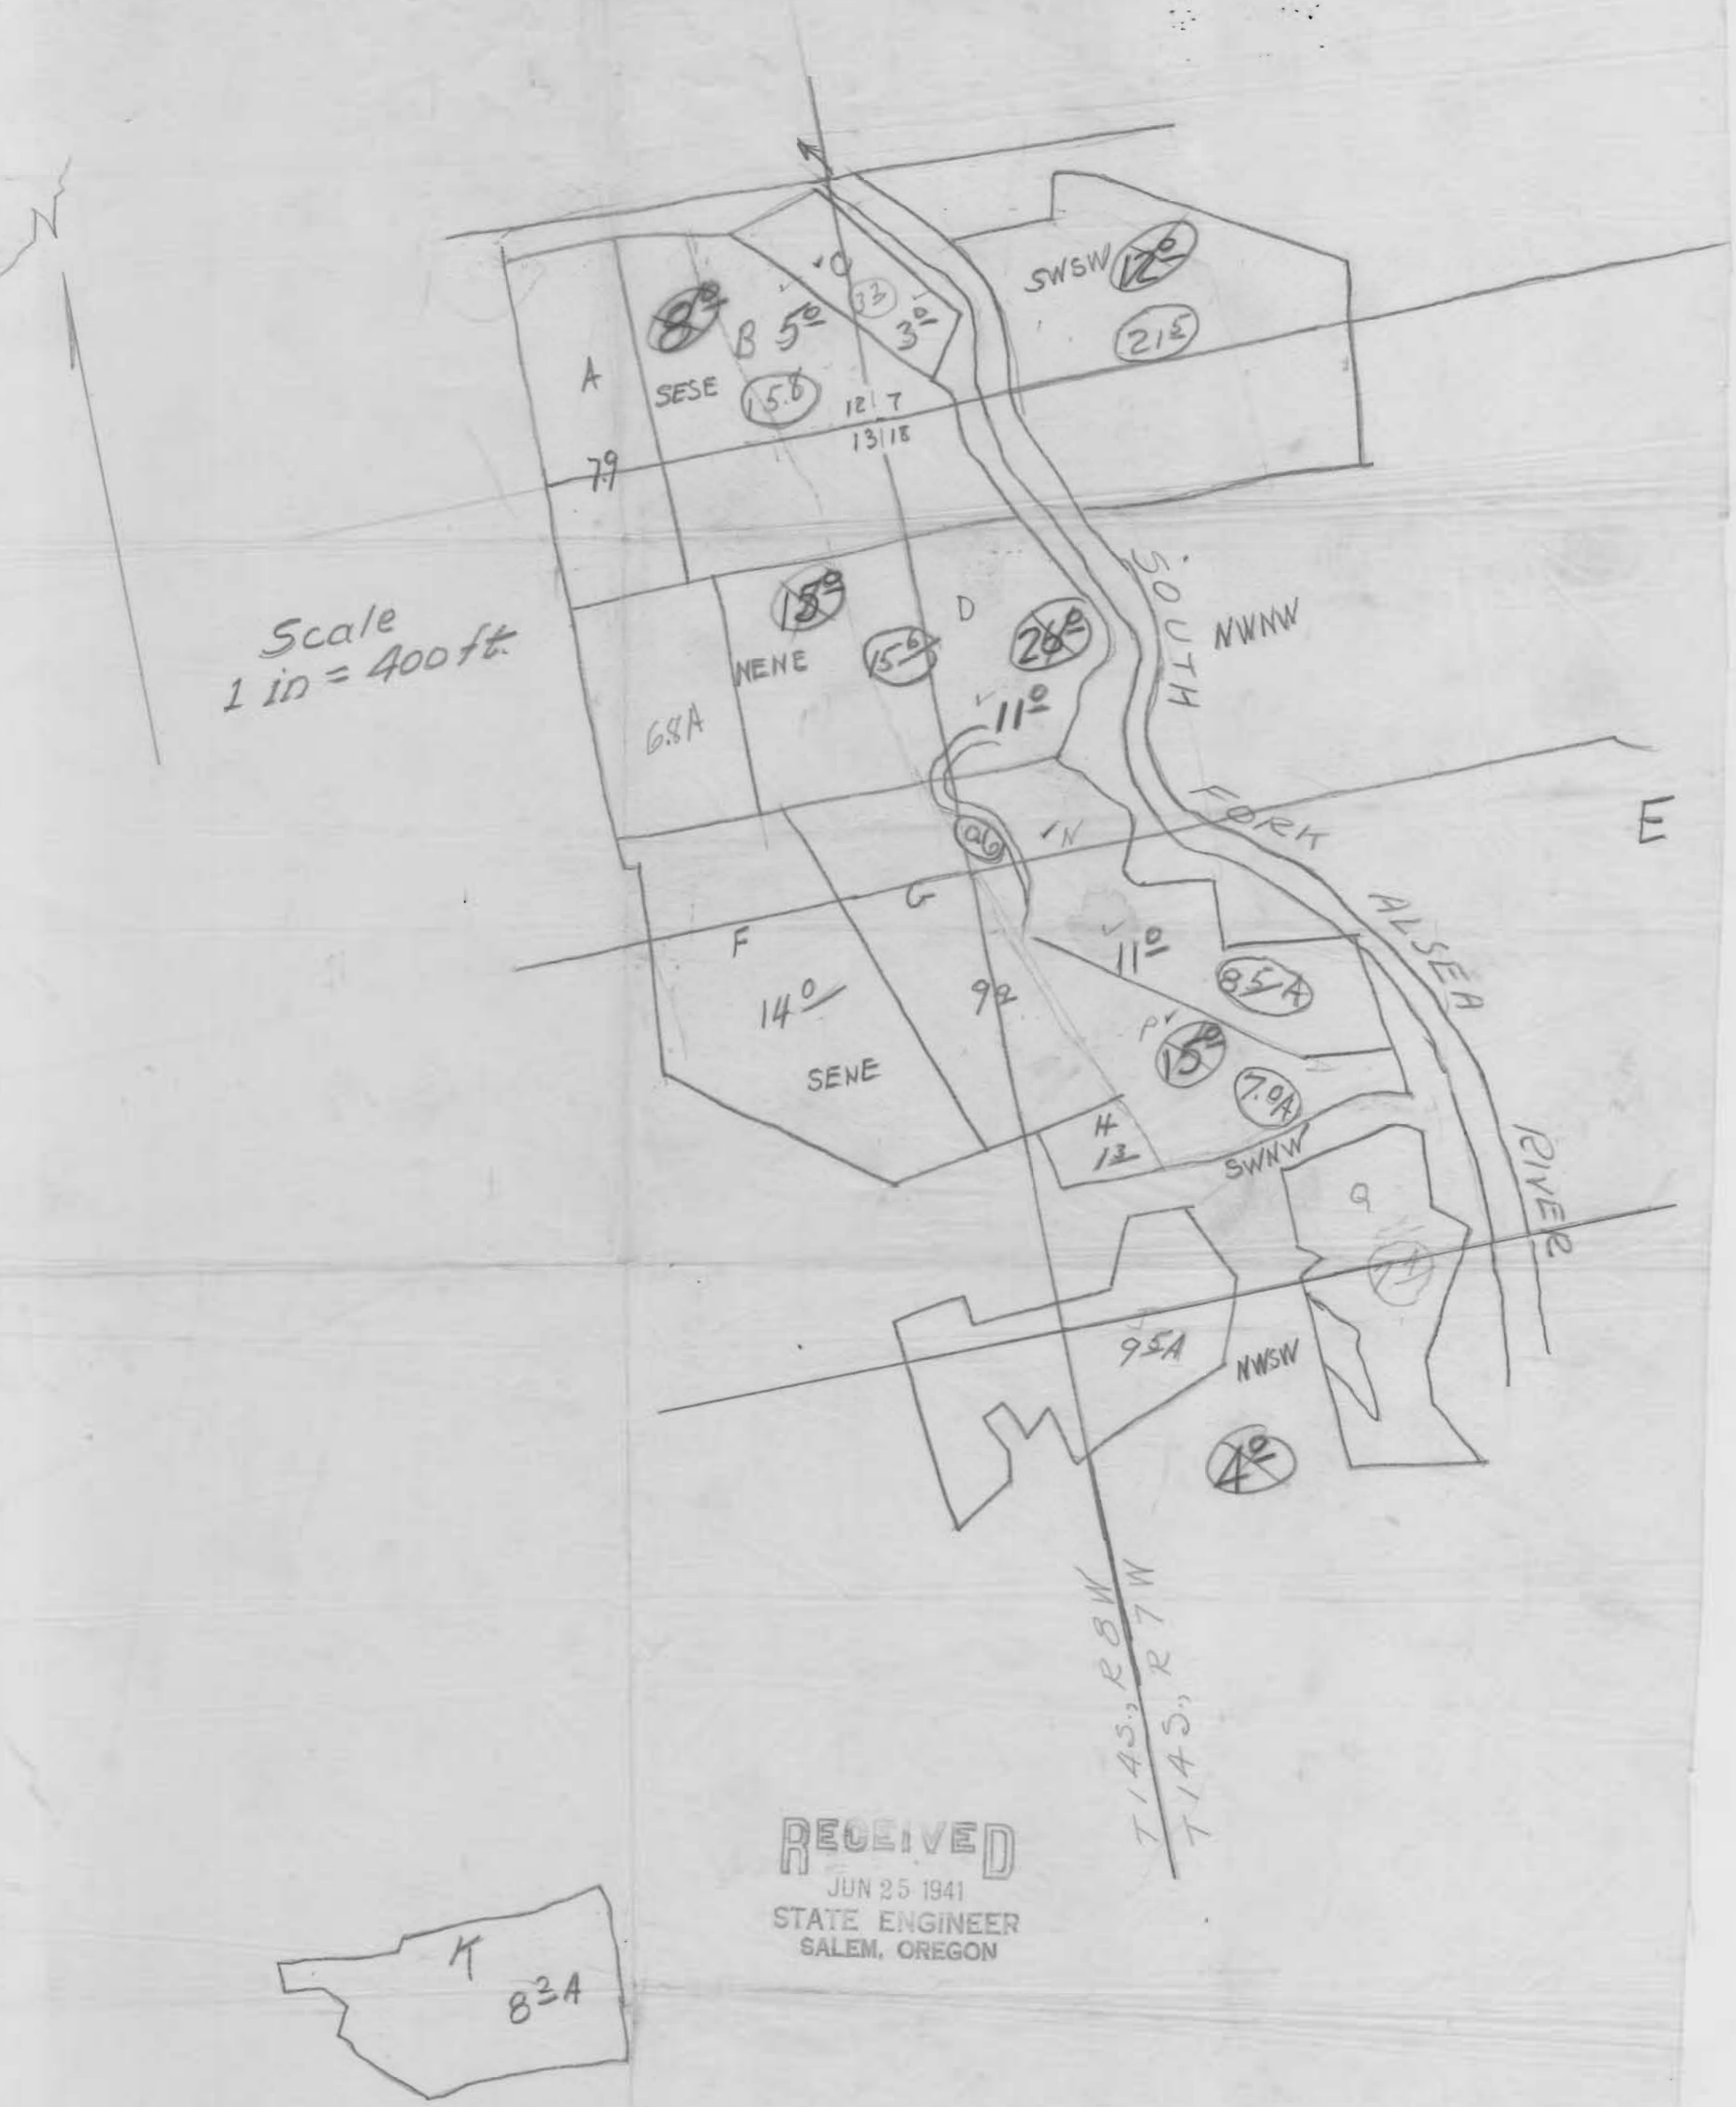

RECEIVED
JUN 25 1941
STATE ENGINEER
SALEM, OREGON

19322 OC 18-11

Application No. 19322
Permit No. 14920