


TOWNSHIP 37 S, RANGE 4 W, W. M.

North

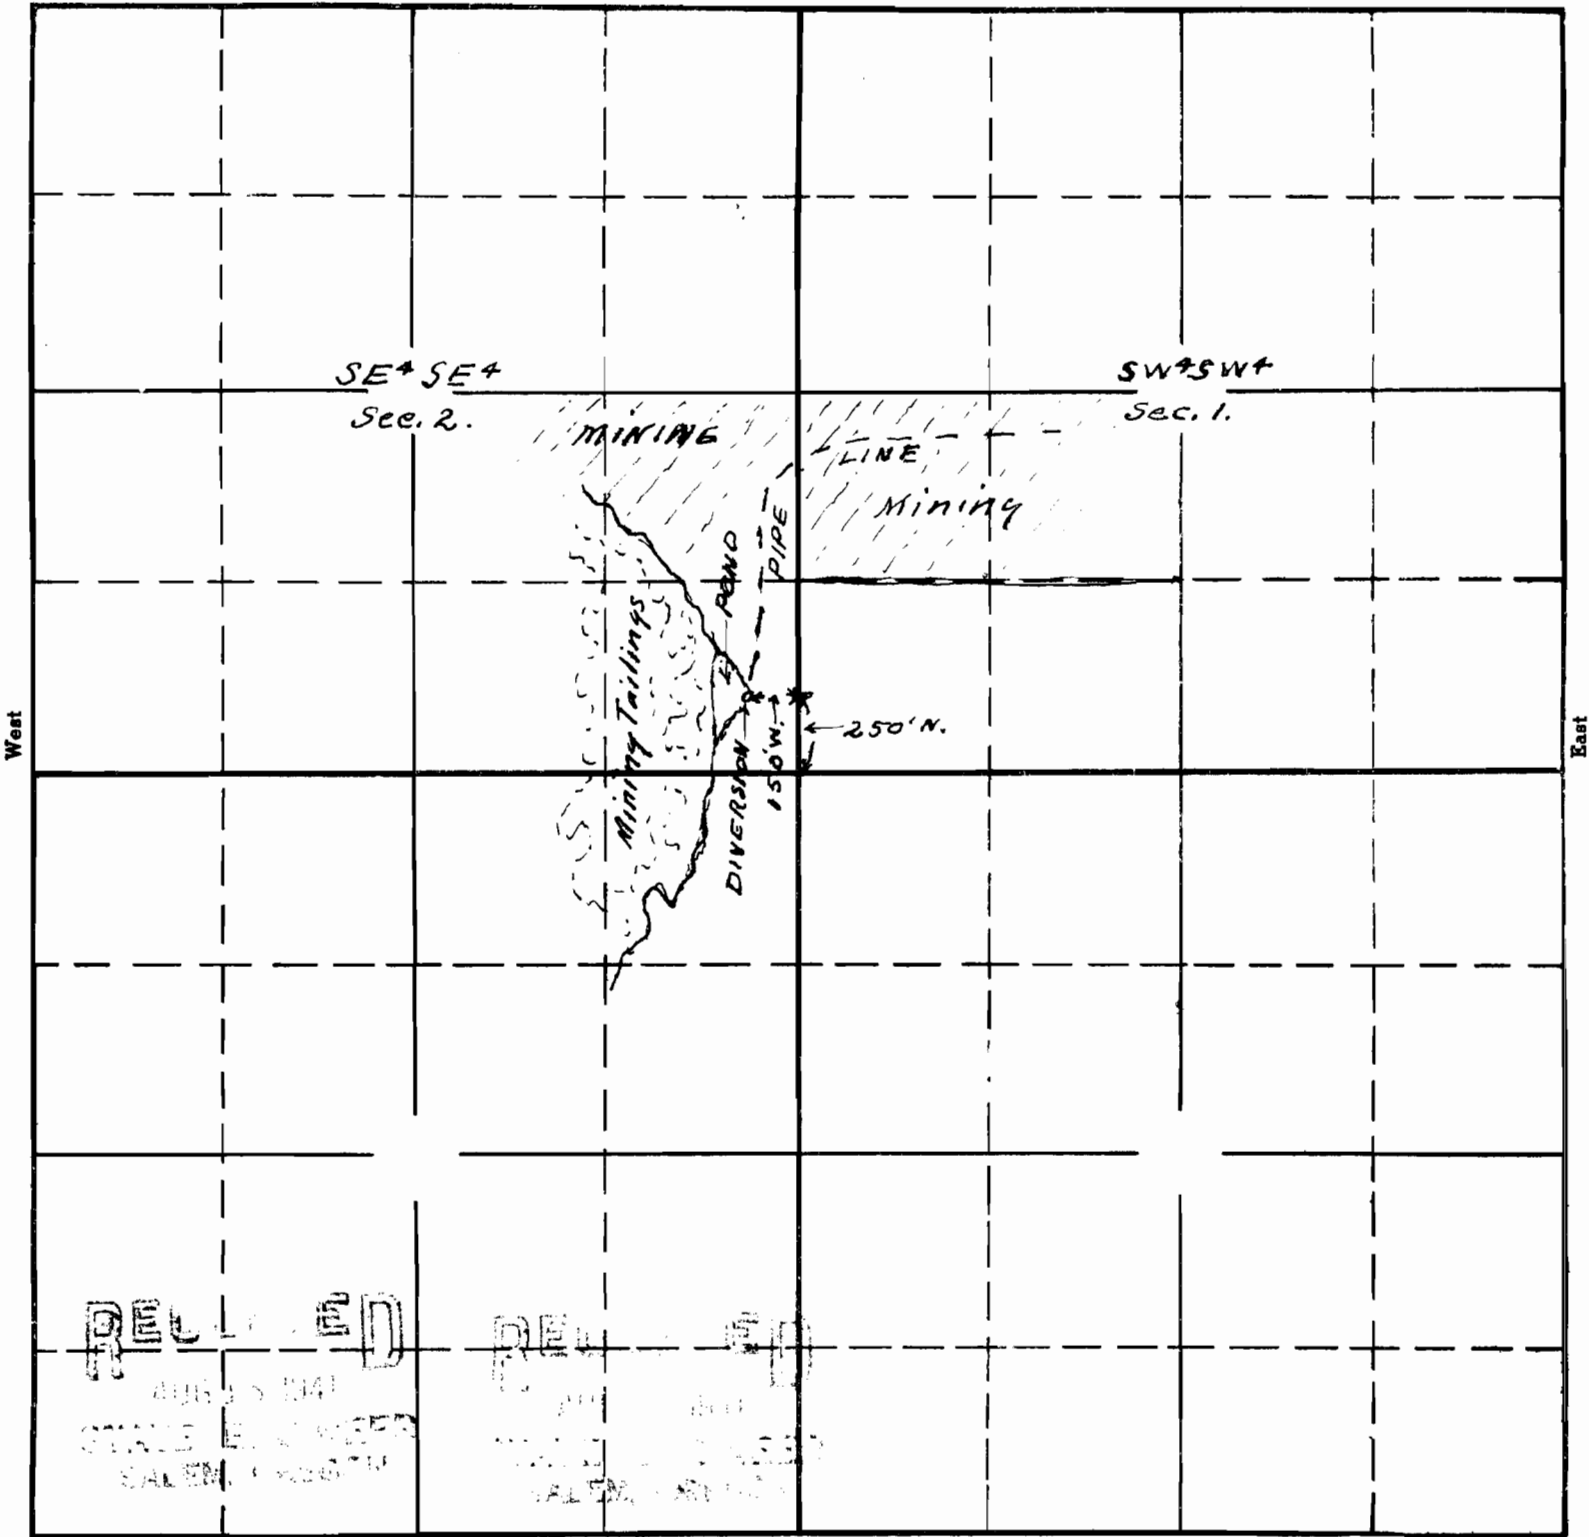

Sketch to accompany application <sup>South</sup> of  
 R.E. and Abbie L M<sup>o</sup> Manus  
 for use of seepage and natural flow  
 of Foots Creek for mining & domestic  
 use

19471 MG  
 15-78  
 APPLICATION No. 19471  
 PERMIT No. 15054

This office 5/15/44