


SECTION

3

TOWNSHIP 1 S , RANGE 3 W , W. M.

North

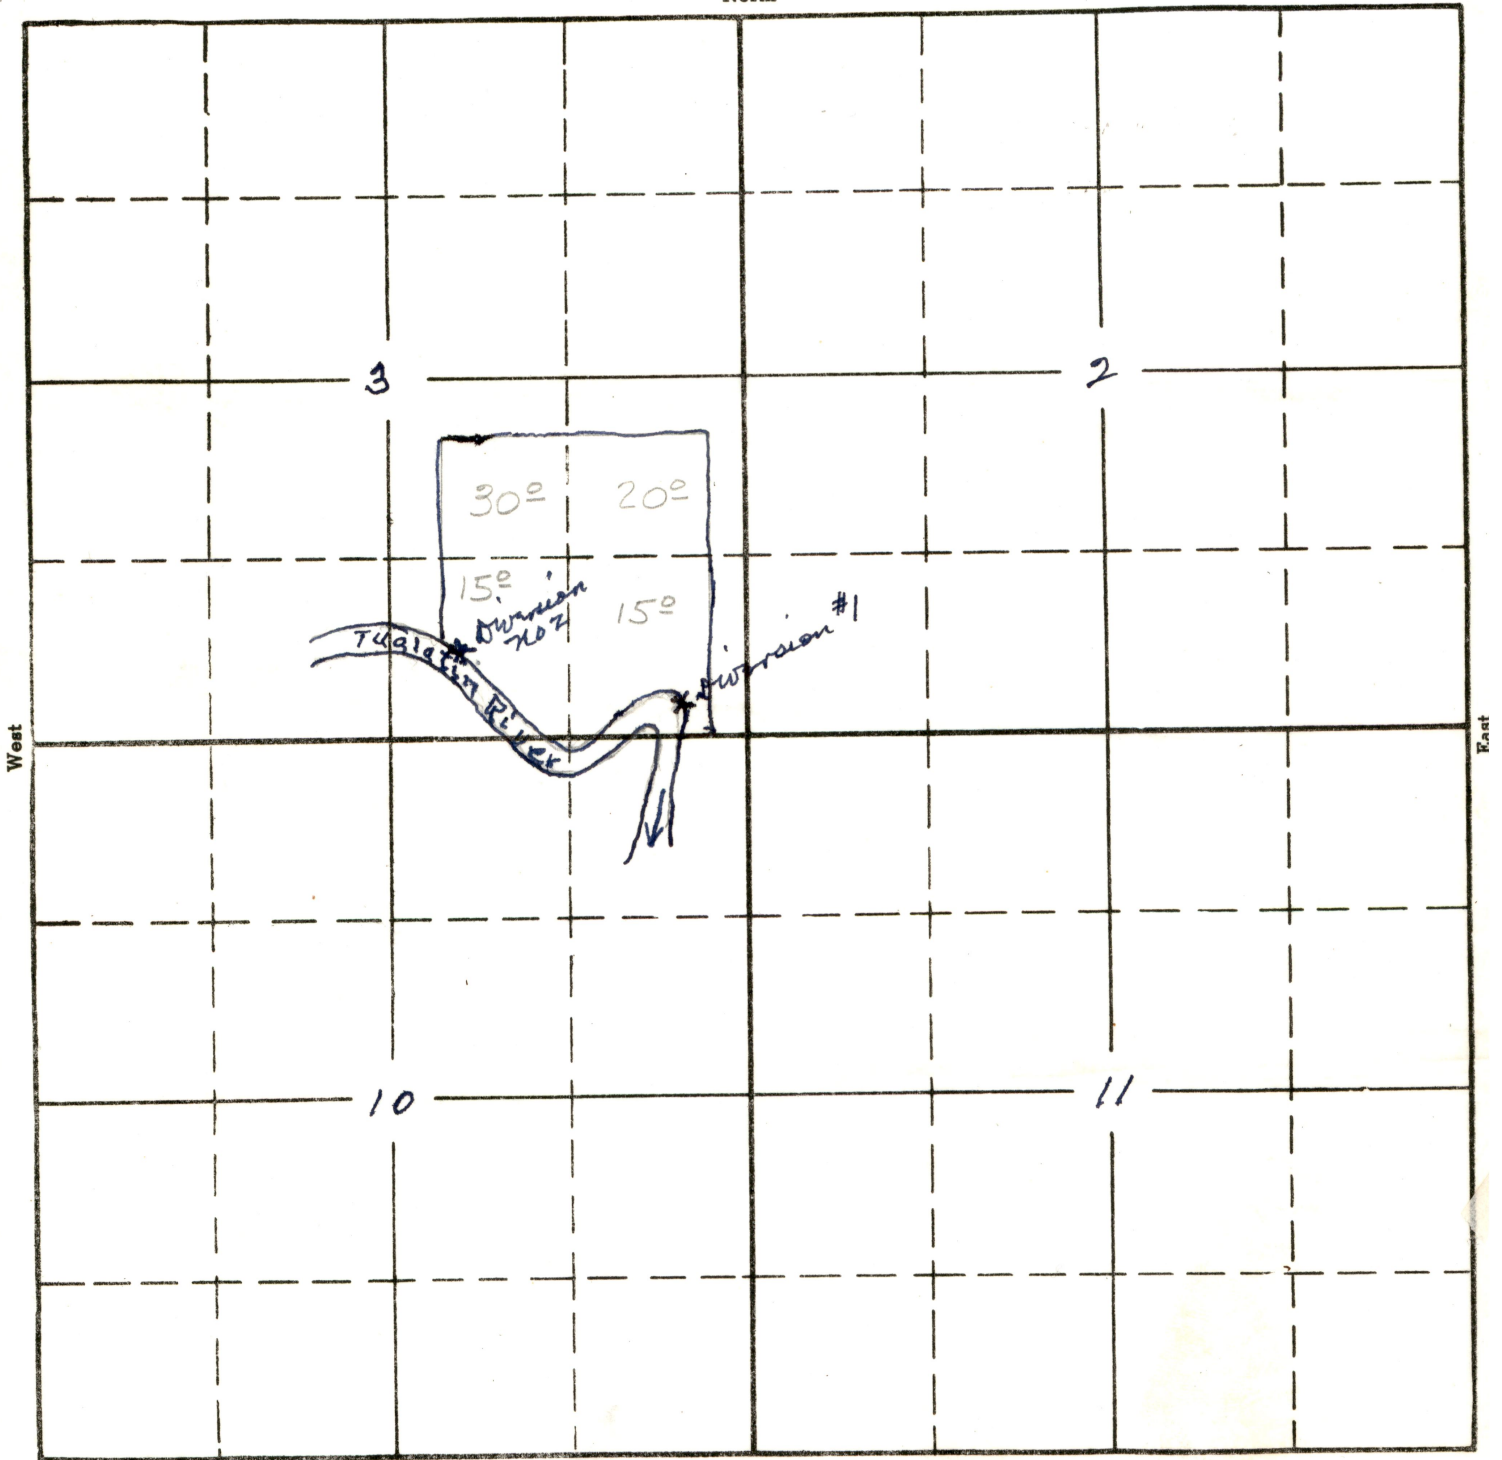

West

East

South

RECEIVED

AUG 15 1941

STATE ENGINEER
SALEM, OREGON

19475 OC
2-54A

APPLICATION No. 19475

PERMIT No. 15058