


SECTION

19  
Jackson Co

TOWNSHIP 37<sup>S</sup>, RANGE 4<sup>W</sup>, W. M.

RECEIVED  
OCT 19 1941  
STATE ENGINEER  
SALEM, OREGON

North

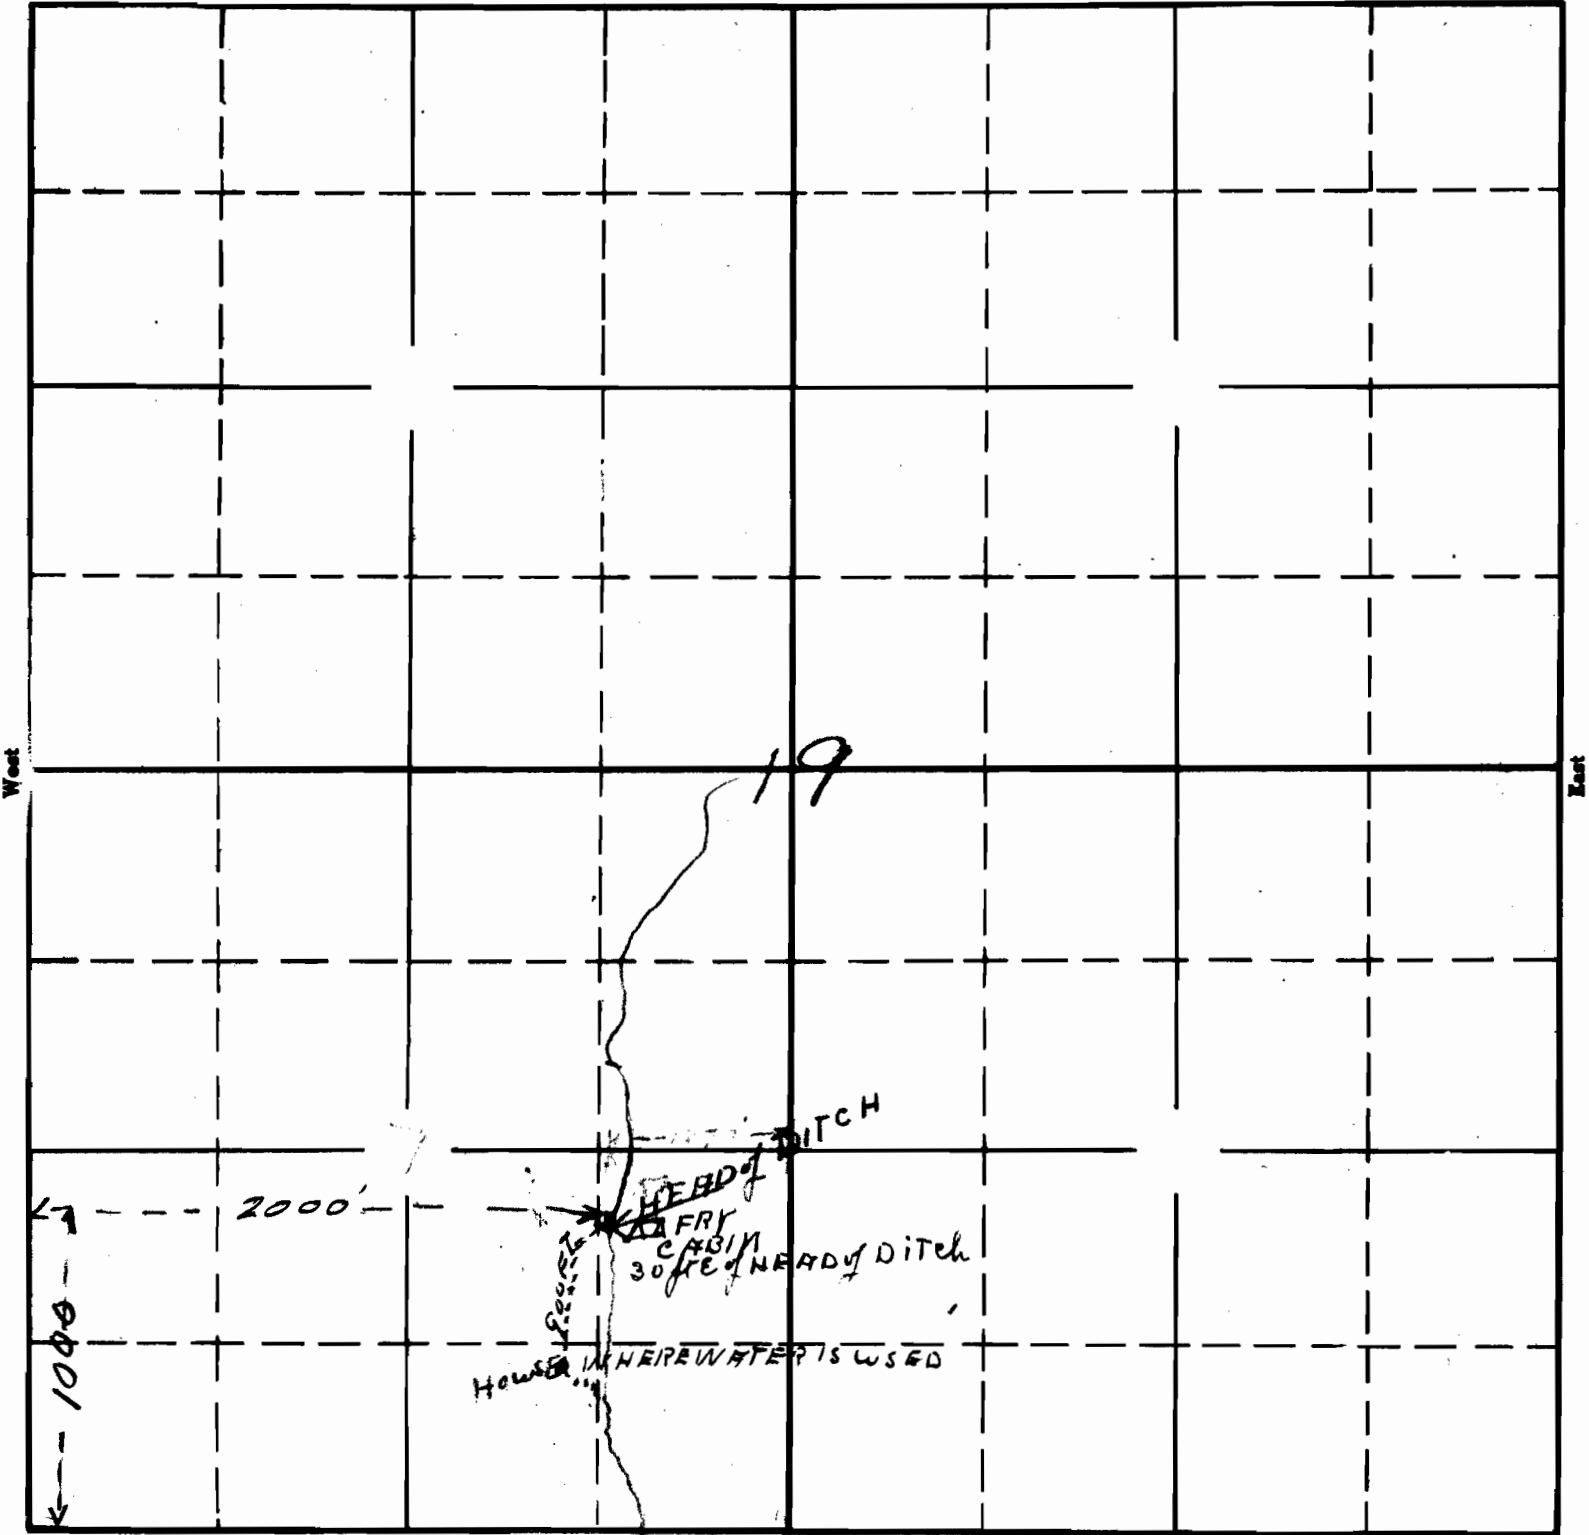

South

Munier Creek

19515 OC  
15-16 A  
APPLICATION No. 19515-  
PERMIT No. 15078