

SECTION


17 + 20

Scale 16 IN. (?)

1 MILE.

TOWNSHIP 32 S, RANGE 4 W, W. M.

North

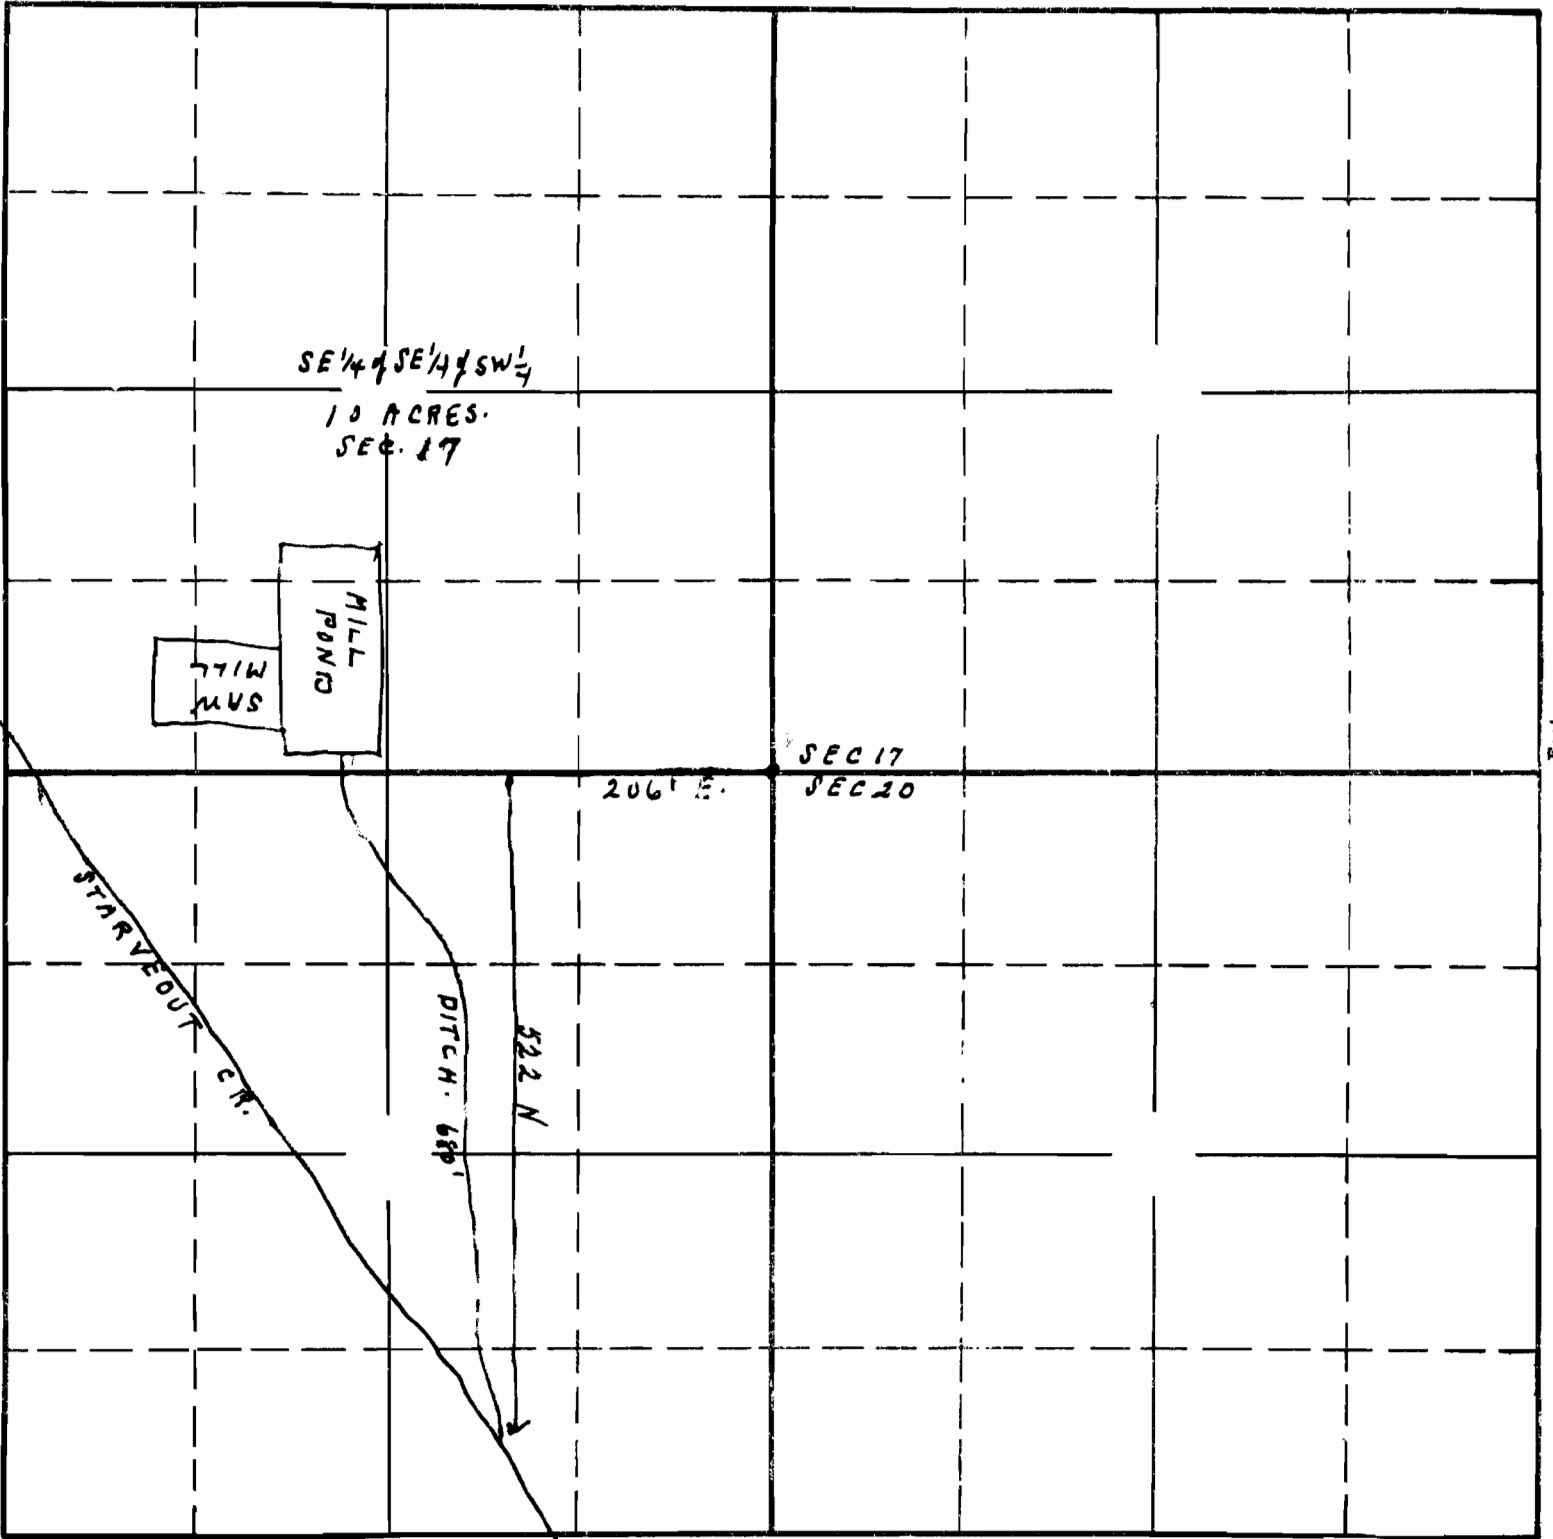

South

REC 20
 STATE ENGINEER
 SALEM OREGON

APPLICATION No. 19489
 PERMIT No. 15700