


T 34 S, R 6 W  
Section 4

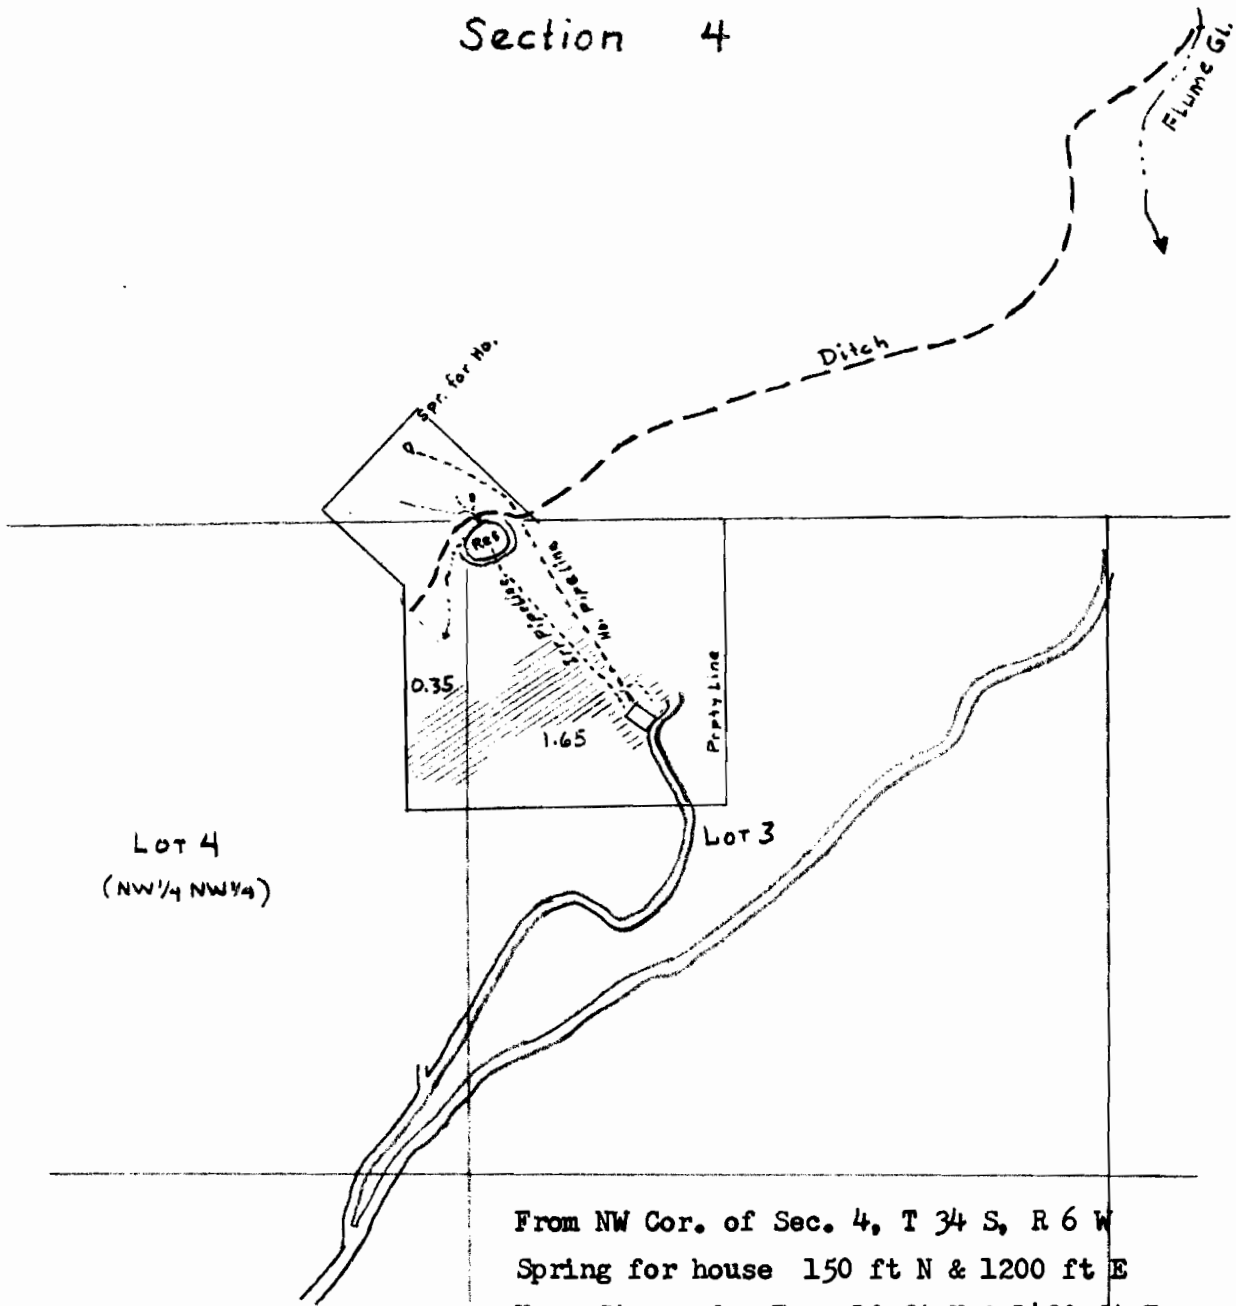

Lot 4  
(NW 1/4 NW 1/4)

Lot 3

0.35

1.65

Property Line

Ditch

Flume Gt.


From NW Cor. of Sec. 4, T 34 S, R 6 W  
Spring for house 150 ft N & 1200 ft E  
Unn. Stream for Irr. 10 ft N & 1400 ft E  
Reservoir outlet for Irr. 100 ft S & 80 ft E

Scale 1 in. = 400 ft.

Application No. 48900 & R-49047  
Permit No. 36630 & R-5939

TOWNSHIP  $\frac{33}{34}$  S, RANGE 6W, W. M.

North

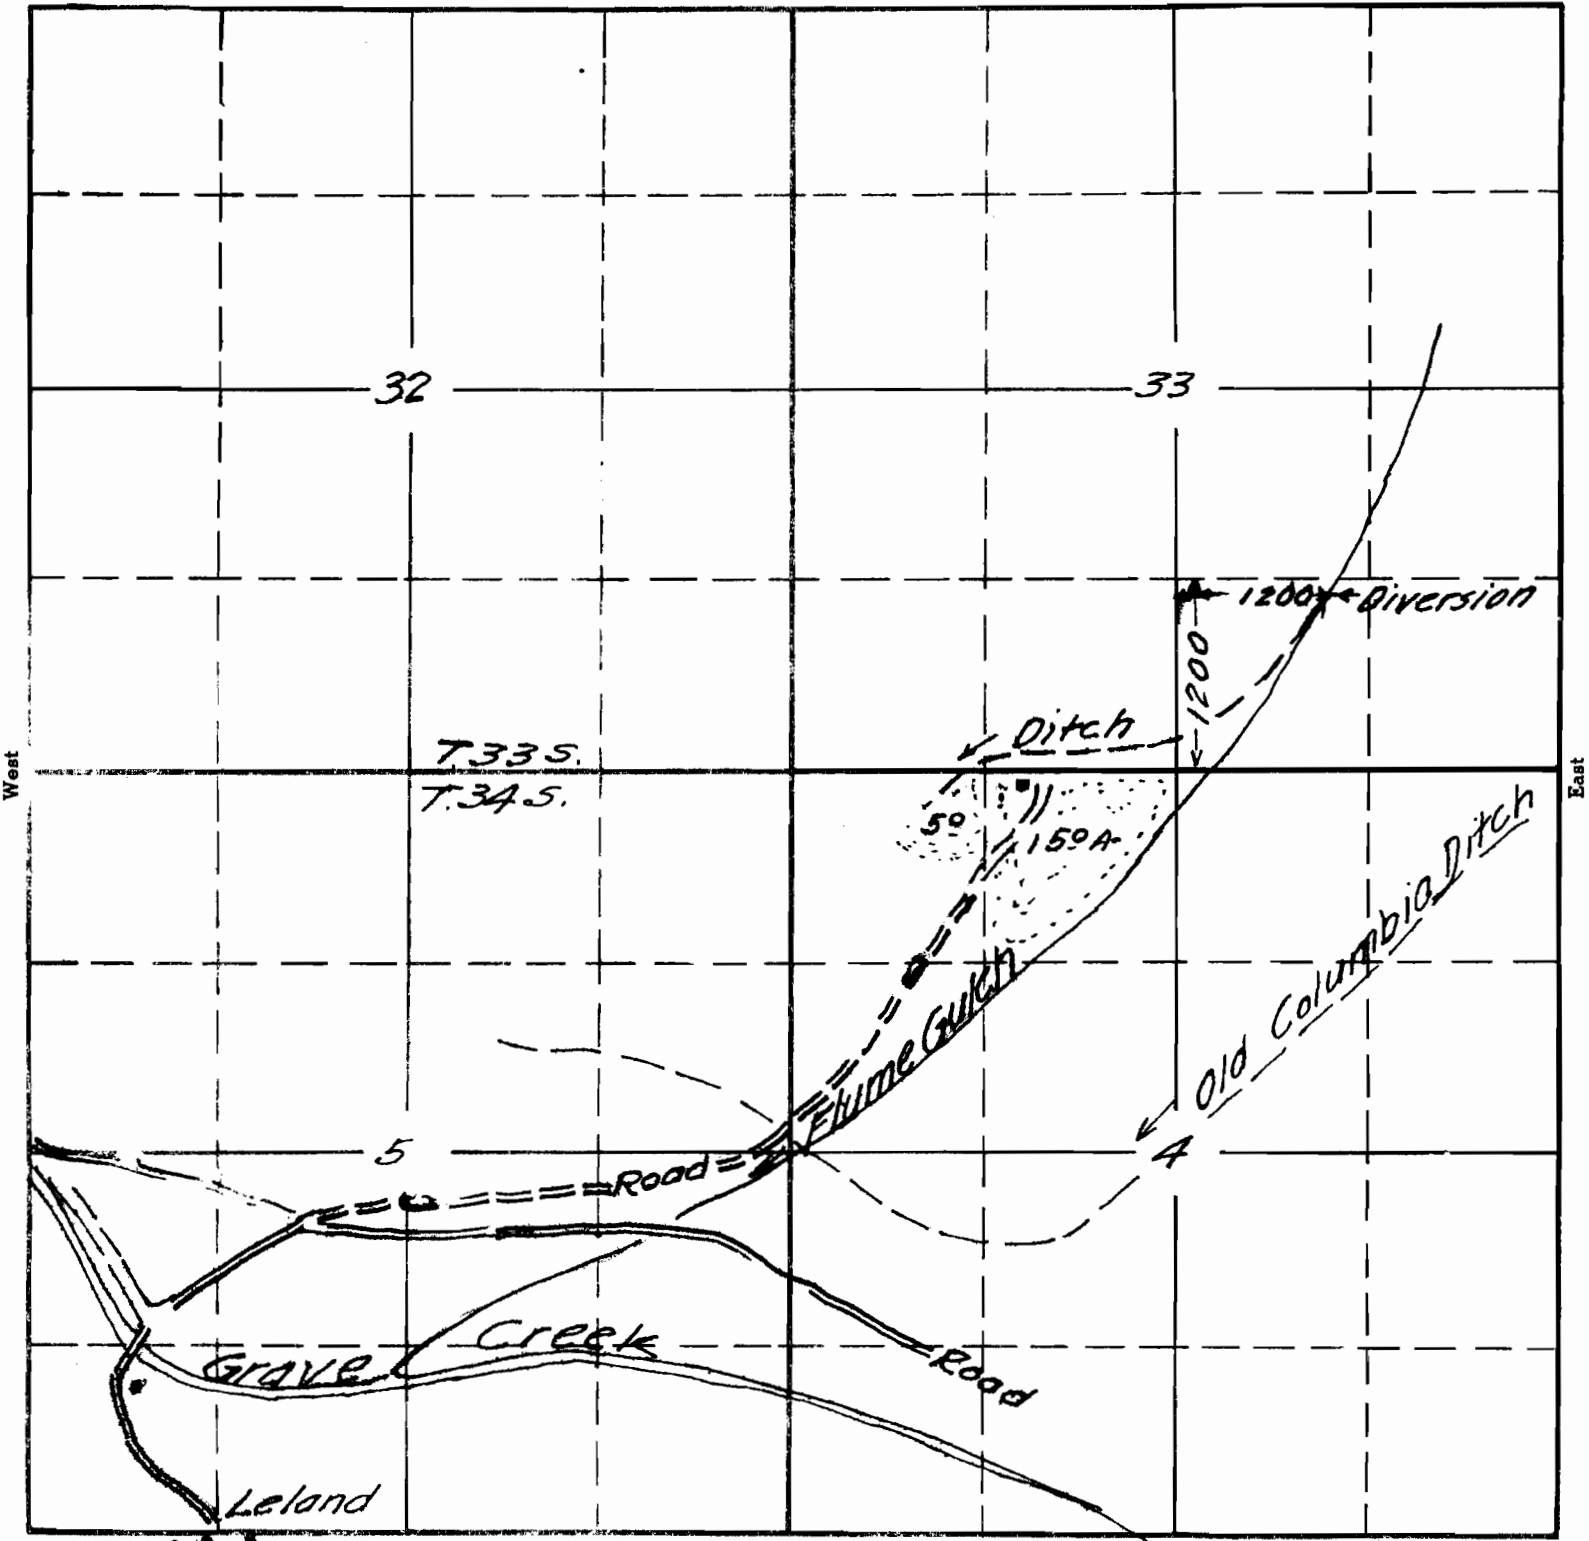

South

L. J. Reed  
Sept. 20, 1941

APPLICATION No. 19510  
PERMIT No. 15105