


17

TOWNSHIP 38 S, RANGE 2 W, W. M.

North

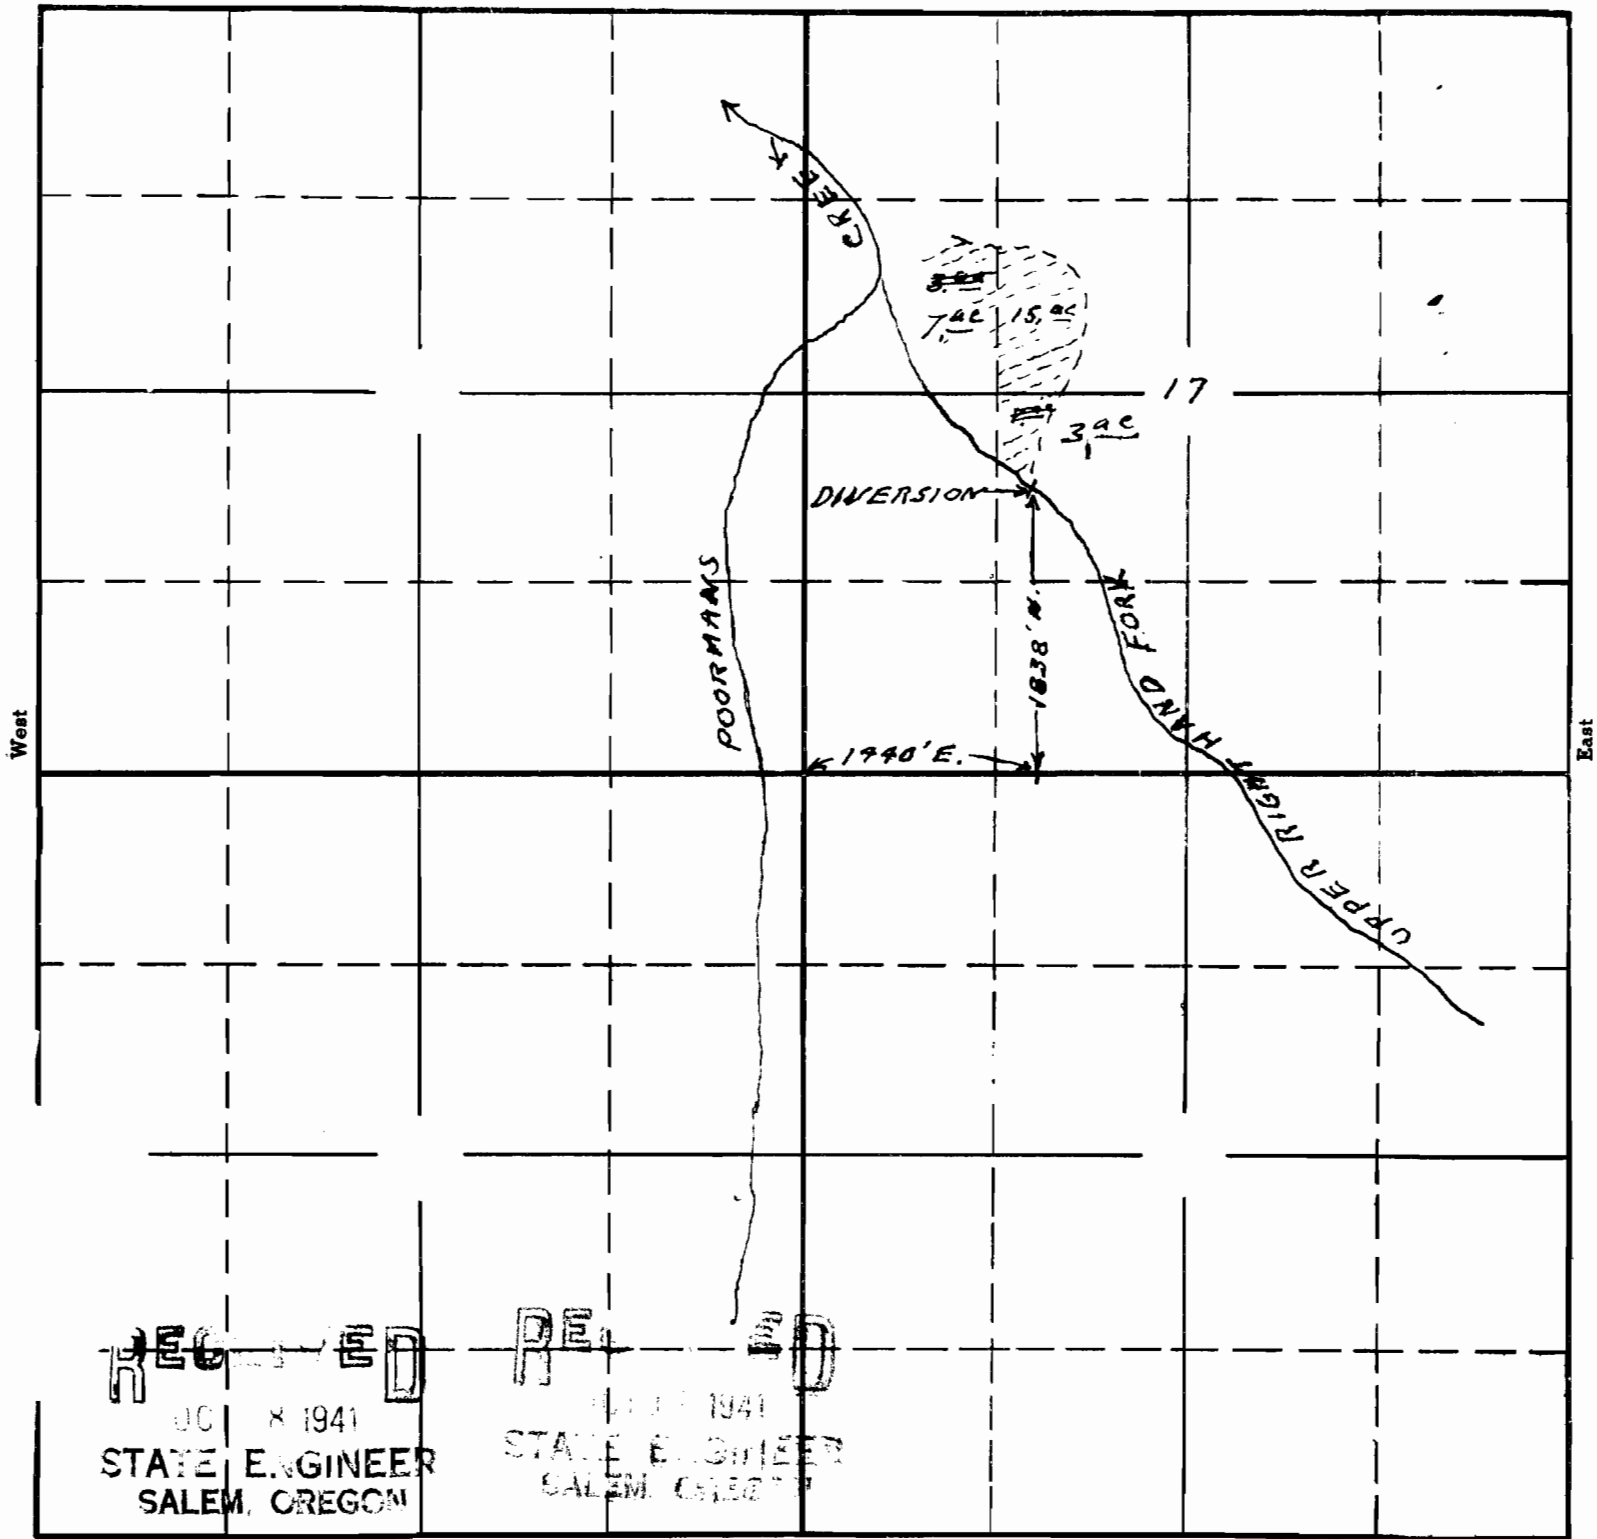

RECEIVED
 OCT 8 1941
 STATE ENGINEER
 SALEM, OREGON

RECEIVED
 OCT 11 1941
 STATE ENGINEER
 SALEM, OREGON

To accompany application South of
 John W Cotton for use of waters of
 Upper Right Hand Fork of Poormans Creek
 For irrigation purposes

19520
 APPLICATION No. 19520
 PERMIT No. 15112


This office 10/7/41 *Edwards*

SECTION

17

TOWNSHIP 38 S, RANGE 2 W, W. M.

North

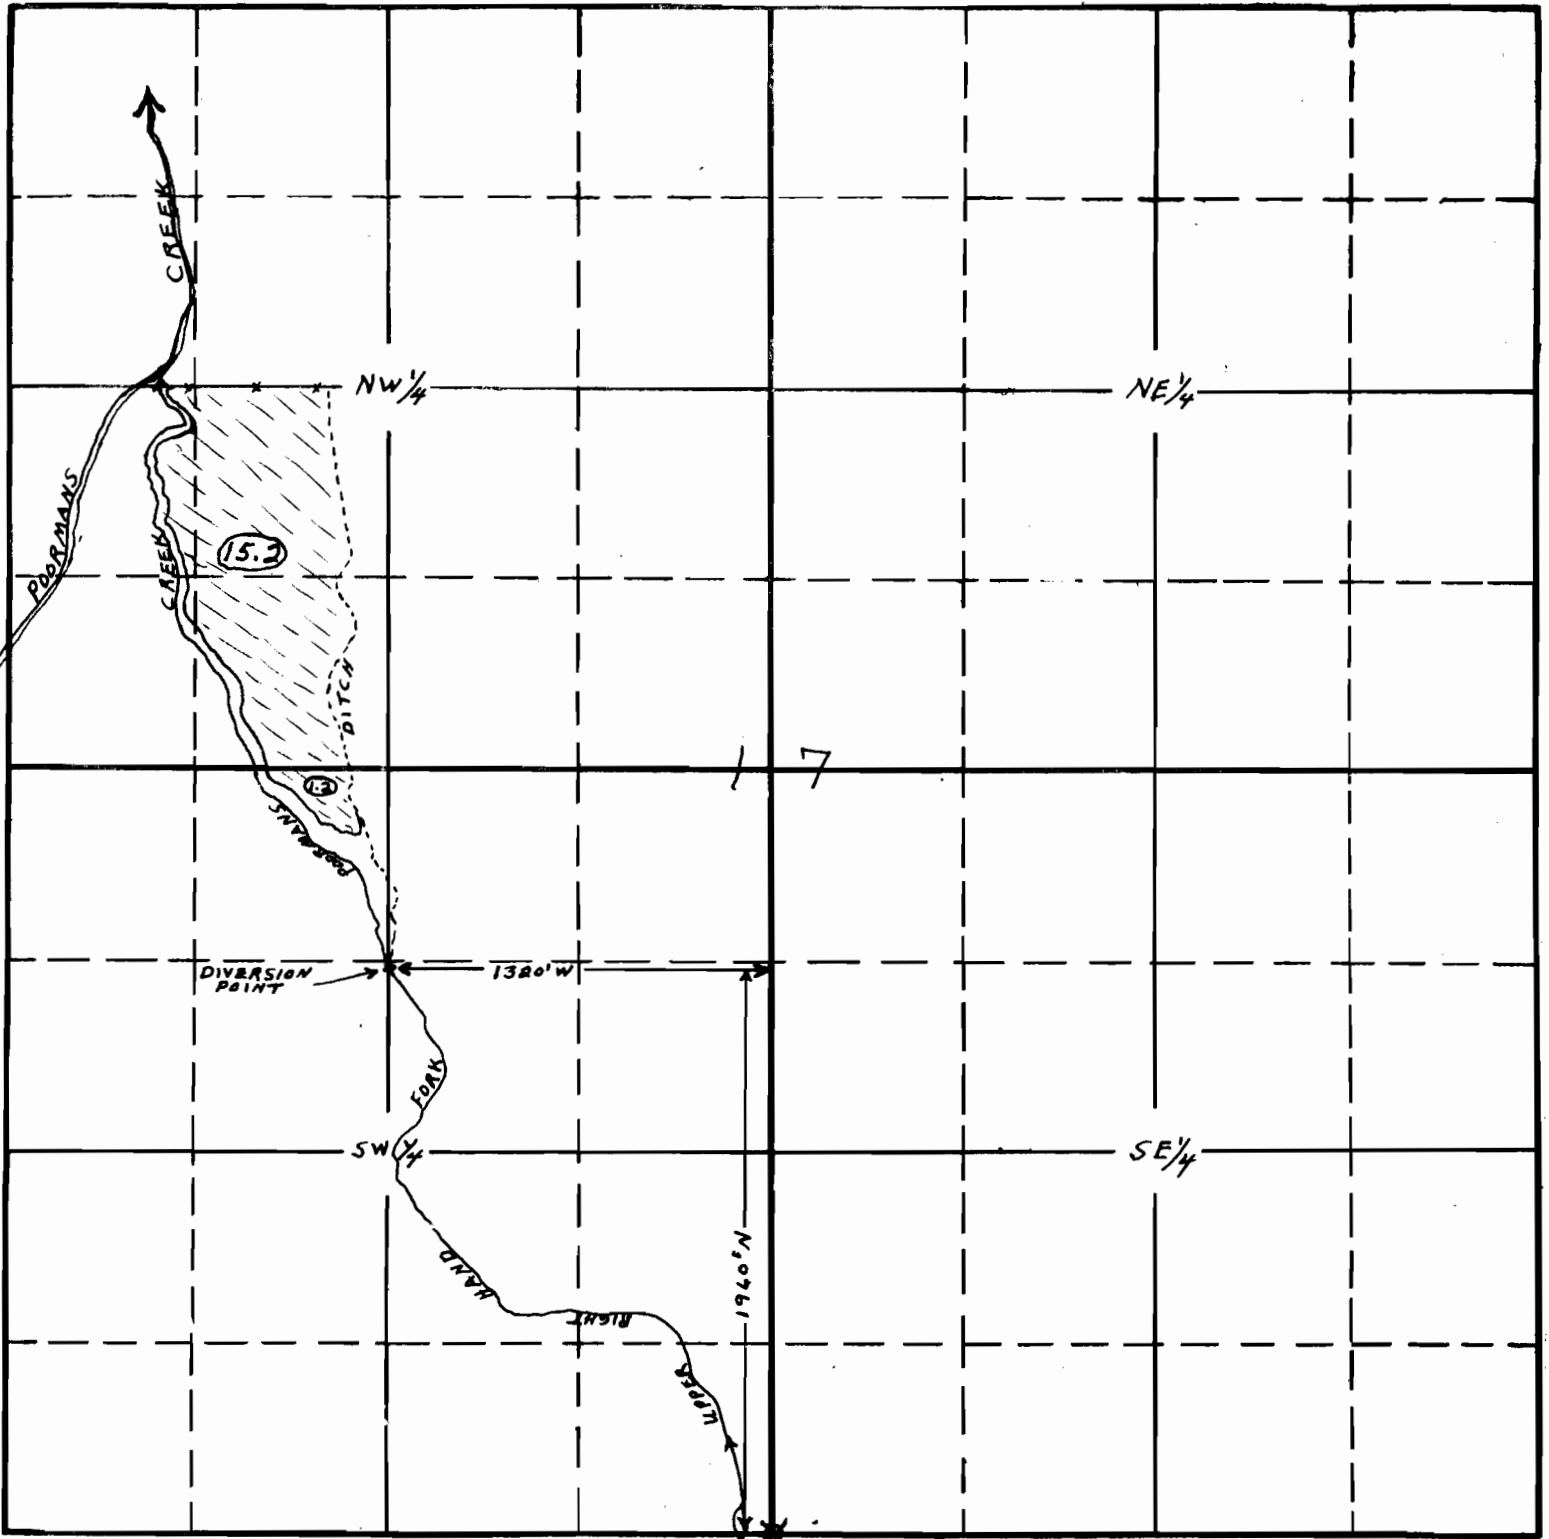

MAP MADE FROM PLANE TABLE SURVEY
 OF H. A. HOGAN PROPERTY. MADE AND
 COMPILED BY D. C. HENDRIX - WATERMASTER

2-27-52

APPLICATION No. 19520

PERMIT No. 15112

RECEIVED
 STATE ENGINEER
 SALEM, OREGON