


TOWNSHIP 34S, RANGE 4W, W. M.

North

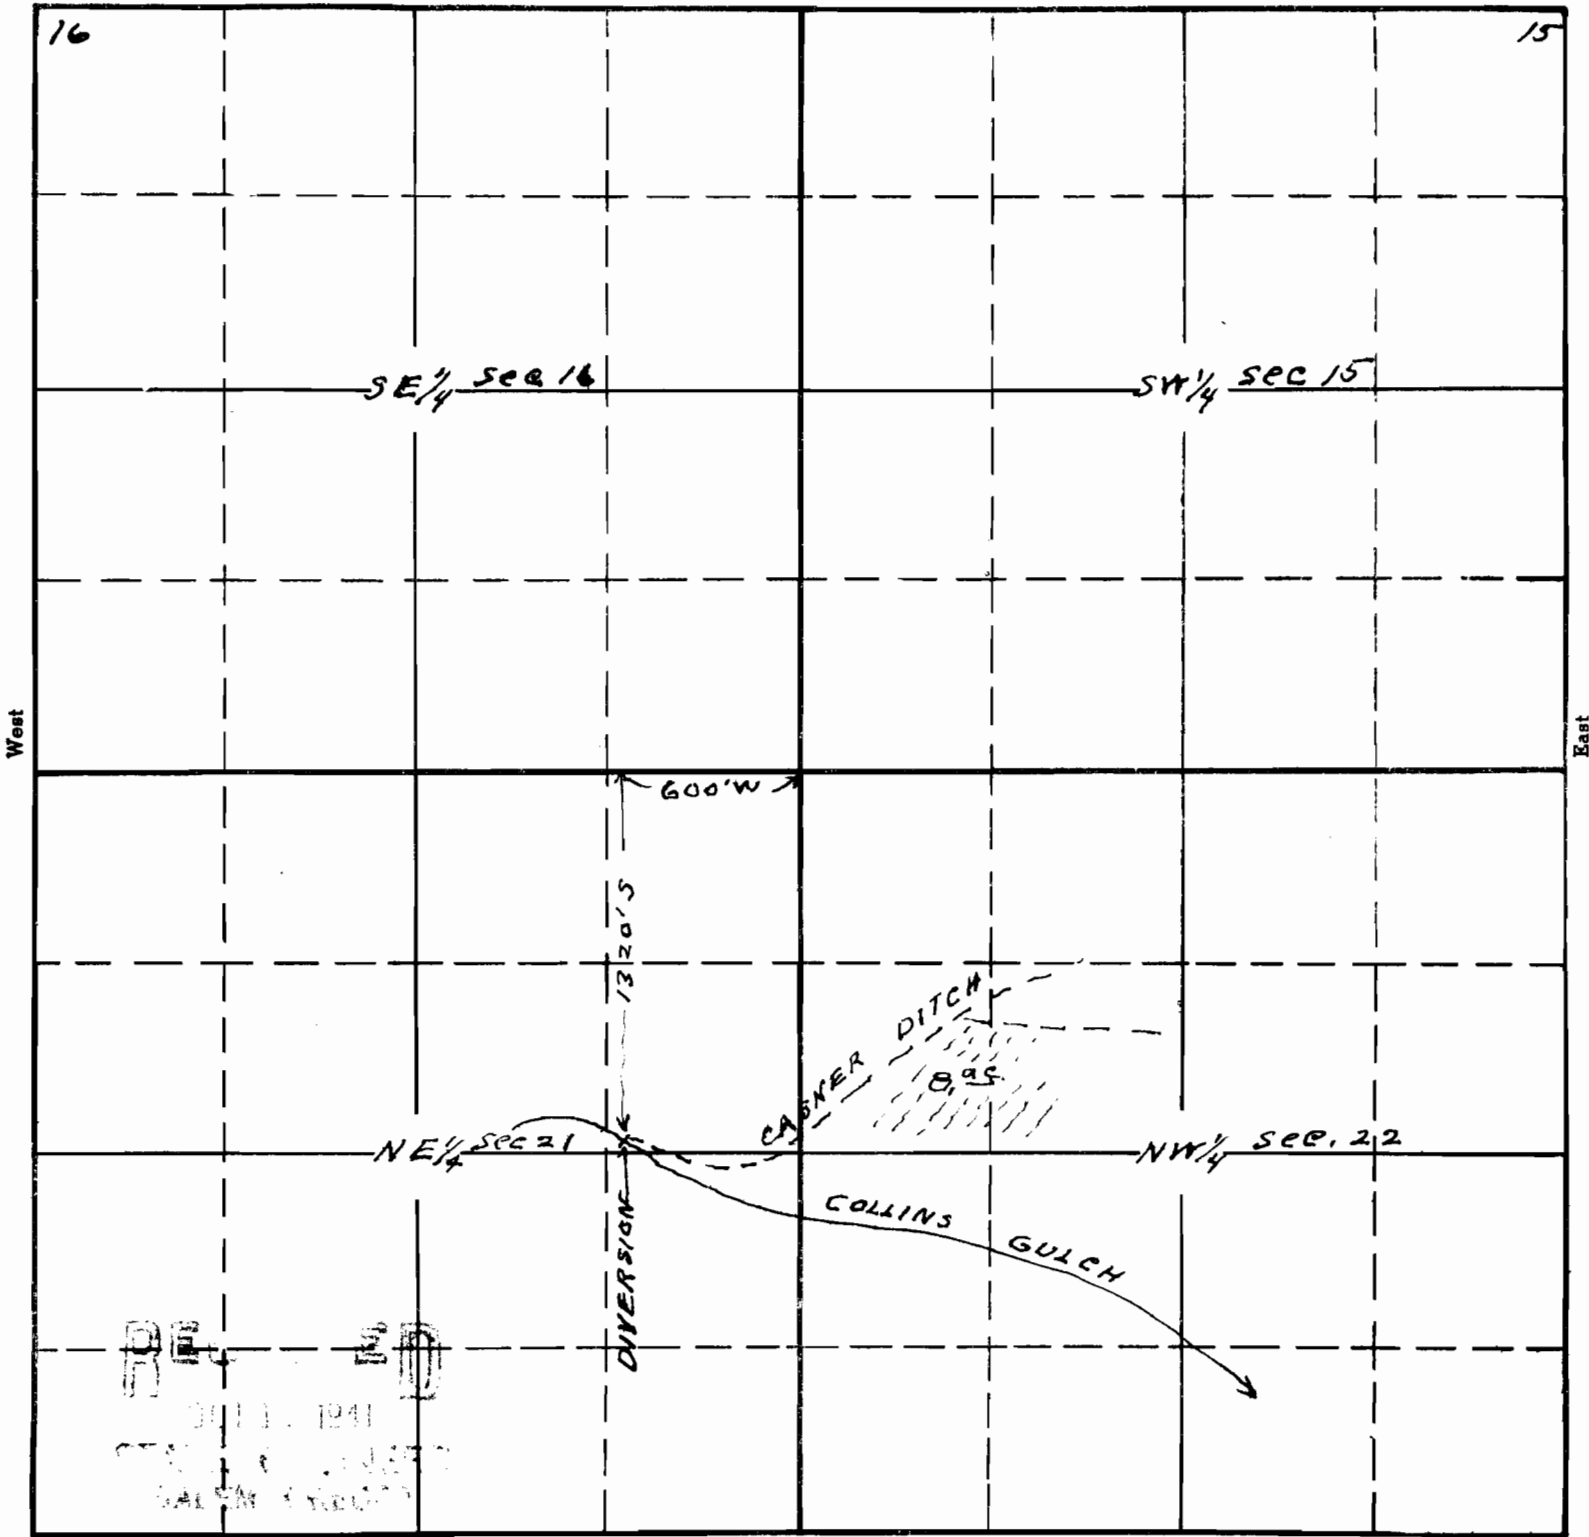

To accompany application of South
 Douglas and Frances E. Talbot for use of
 waters of Collins Gulch for irrigation

19529
 APPLICATION No. 19529
 PERMIT No. 15119

This office 10/14/91 *[Signature]*