


RE
317
502

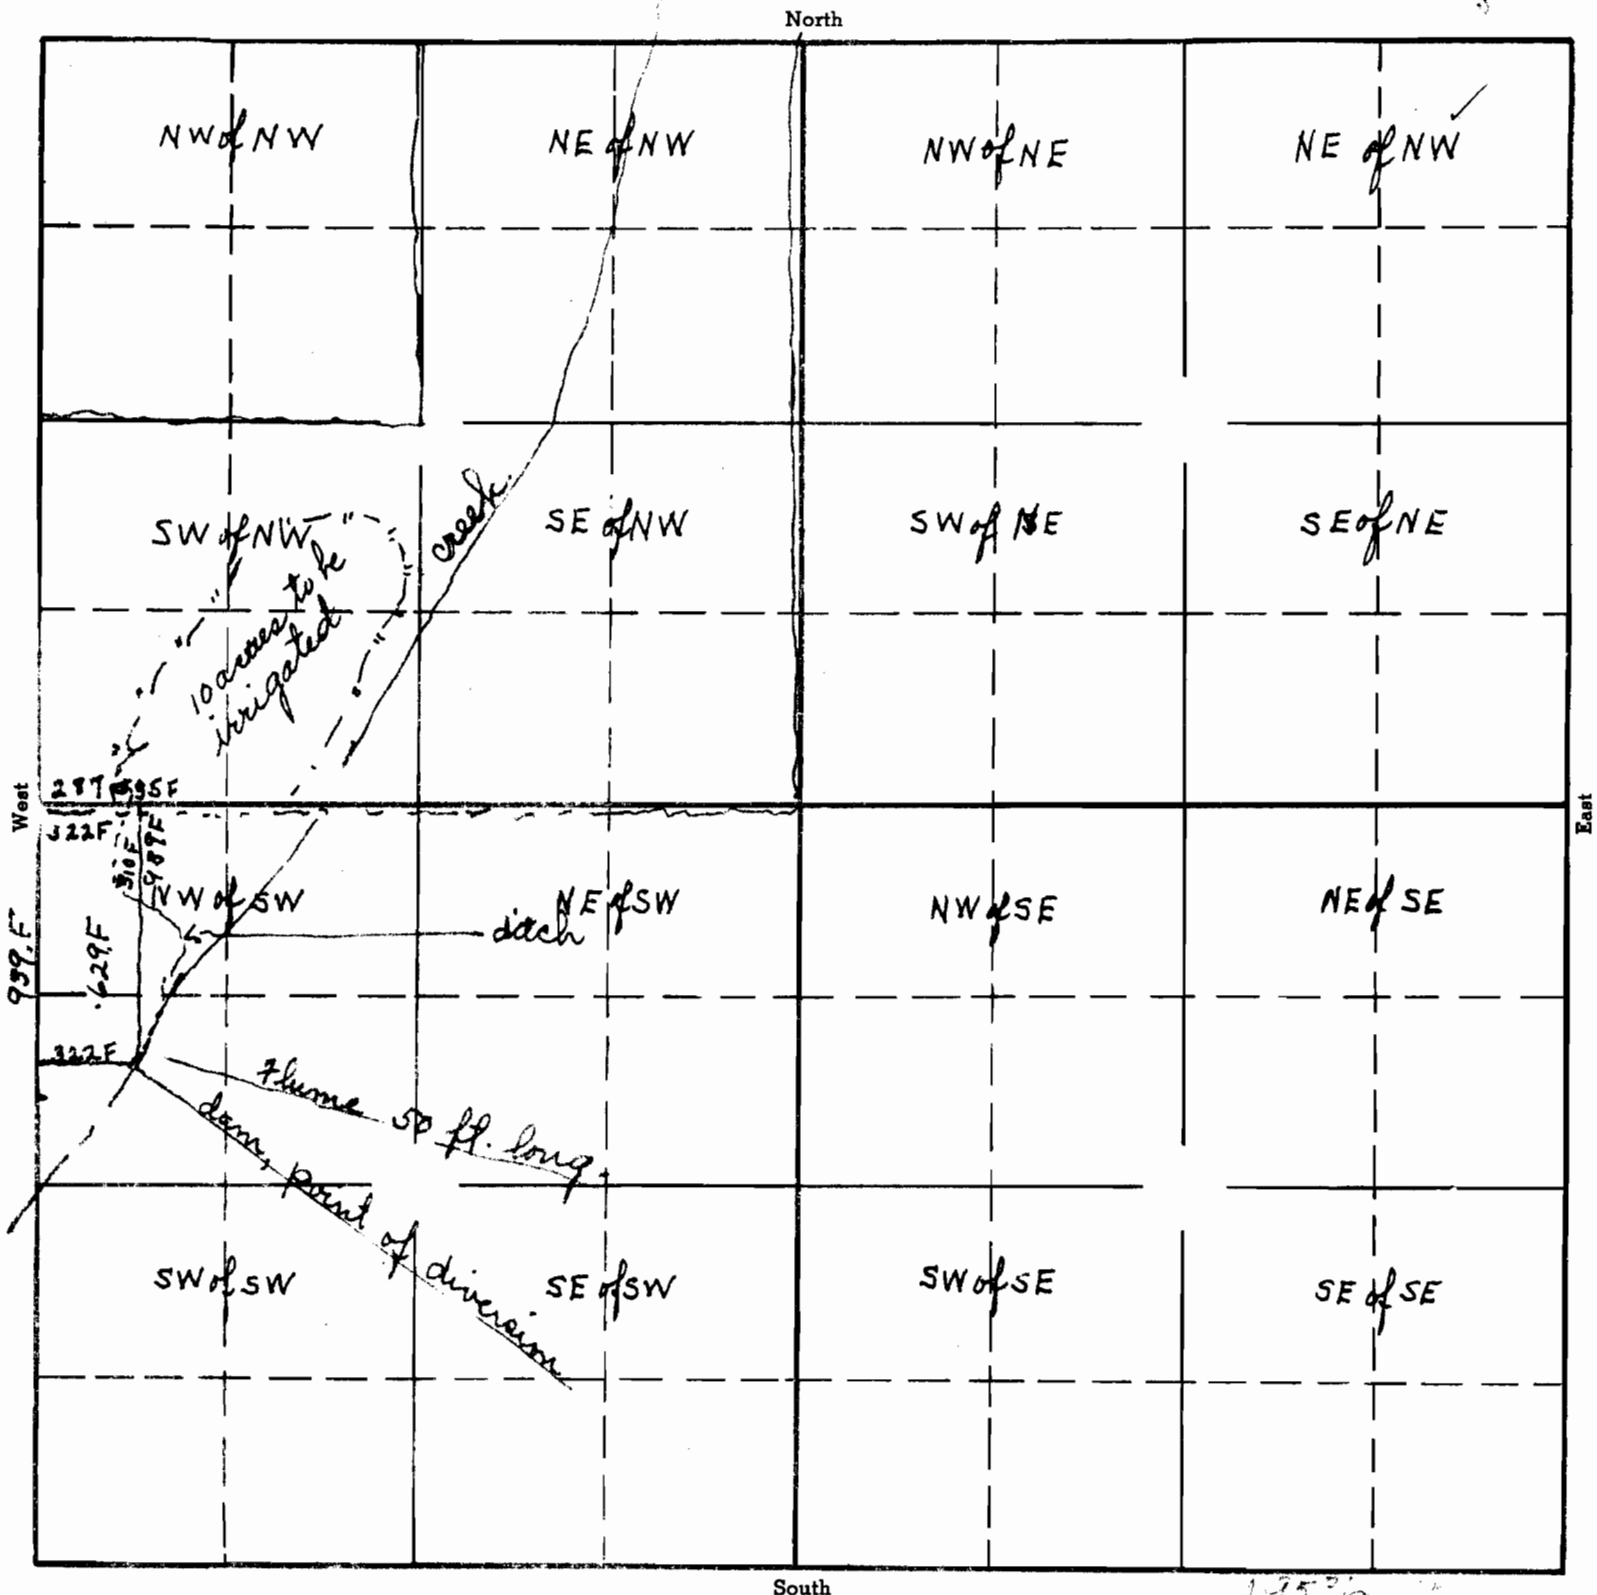

Original, but not on this sheet,
made out by Emmett P. Conger. Surveyor.

19536
APPLICATION No. 19536
PERMIT No. 15125