


North line SW¹/₄ NW¹/₄ Sec 36

North line J.W. Mott property

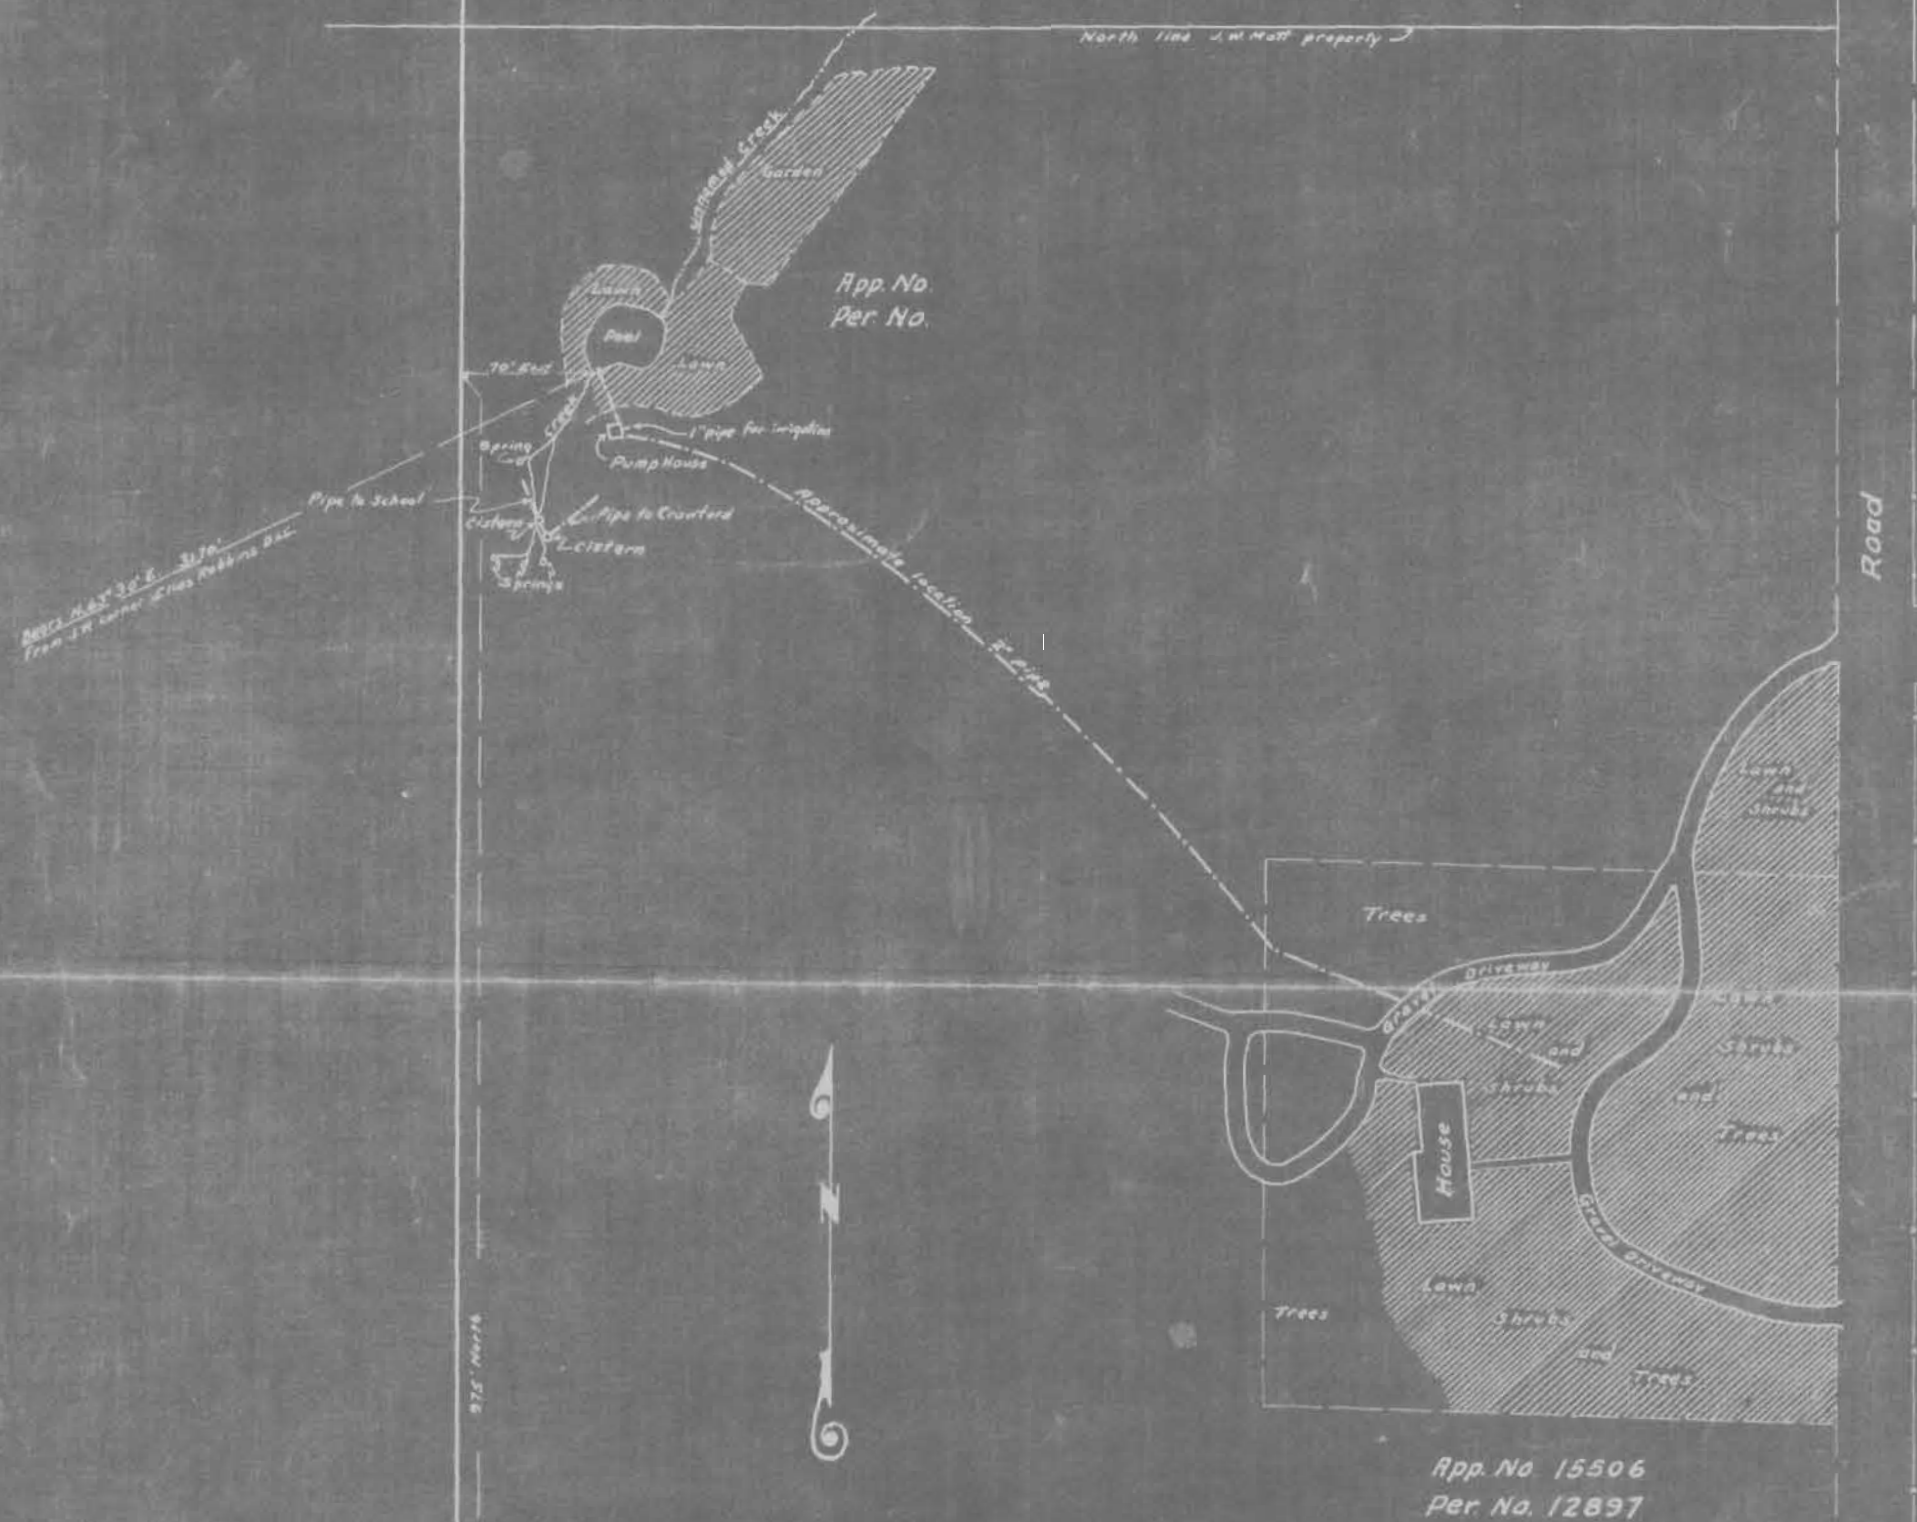

MAP OF
WATER RIGHT DEVELOPMENT
J. W. MOTT
POLK COUNTY, OREGON

PREPARED FROM PLANETABLE
SURVEY MADE JULY 25, 1941

SCALE: 1 IN. = 100 FT.

Application No. 19542
Permit No. 15129

W¹/₄ Corner Sec. 36, T. 6 S., R. 4 W. W.M.