


23

TOWNSHIP 32S, RANGE 1E, W. M.

North

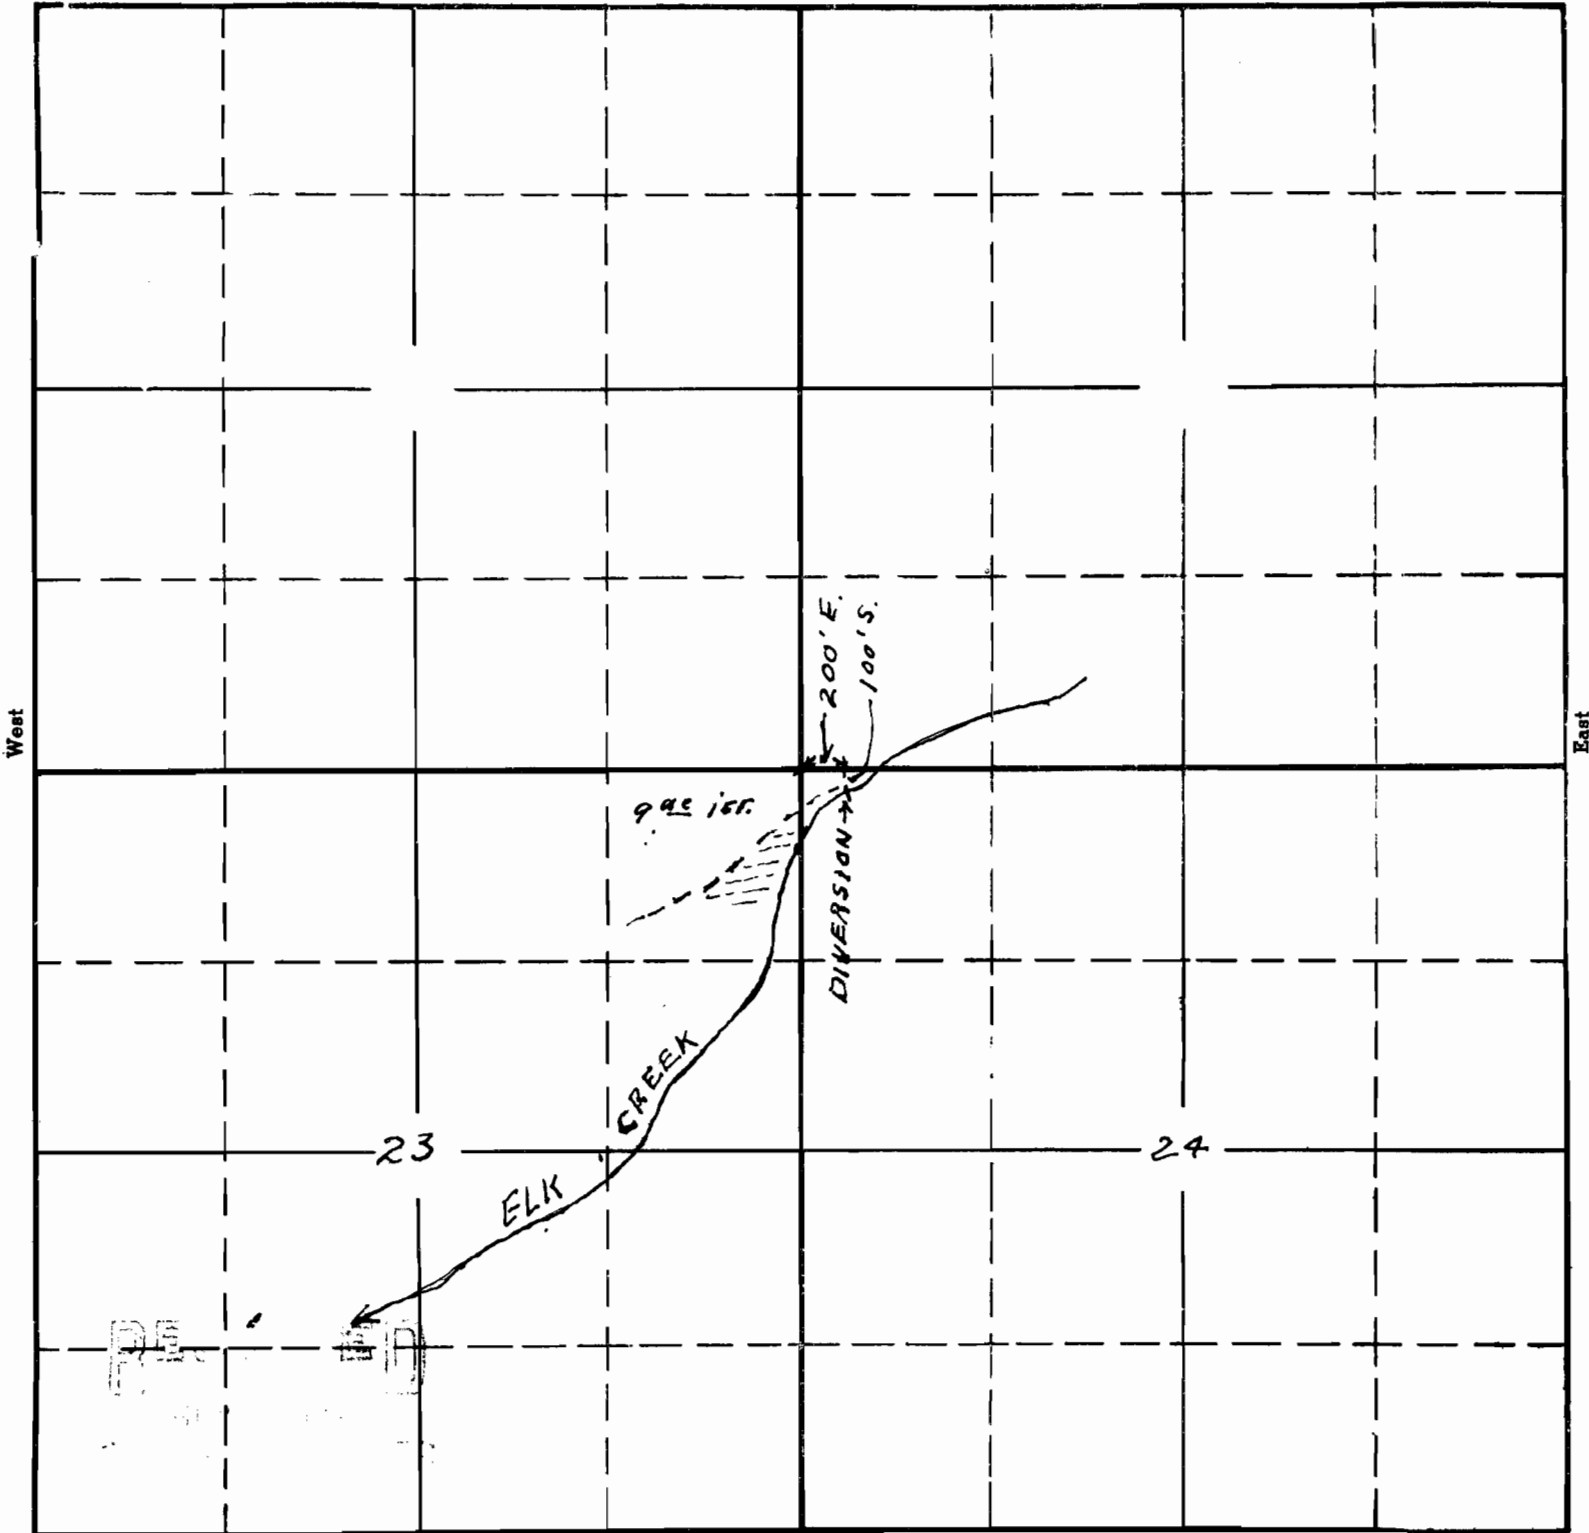

Sketch To accompany application of  
 John R KIRSCH for use of waters of  
 Elk Creek for irrigation purposes

APPLICATION No. 1955  
 PERMIT No. 15135

This office 10/6/41 *[Signature]*