


SECTION

TOWNSHIP 43, RANGE 38E, W. M.

North

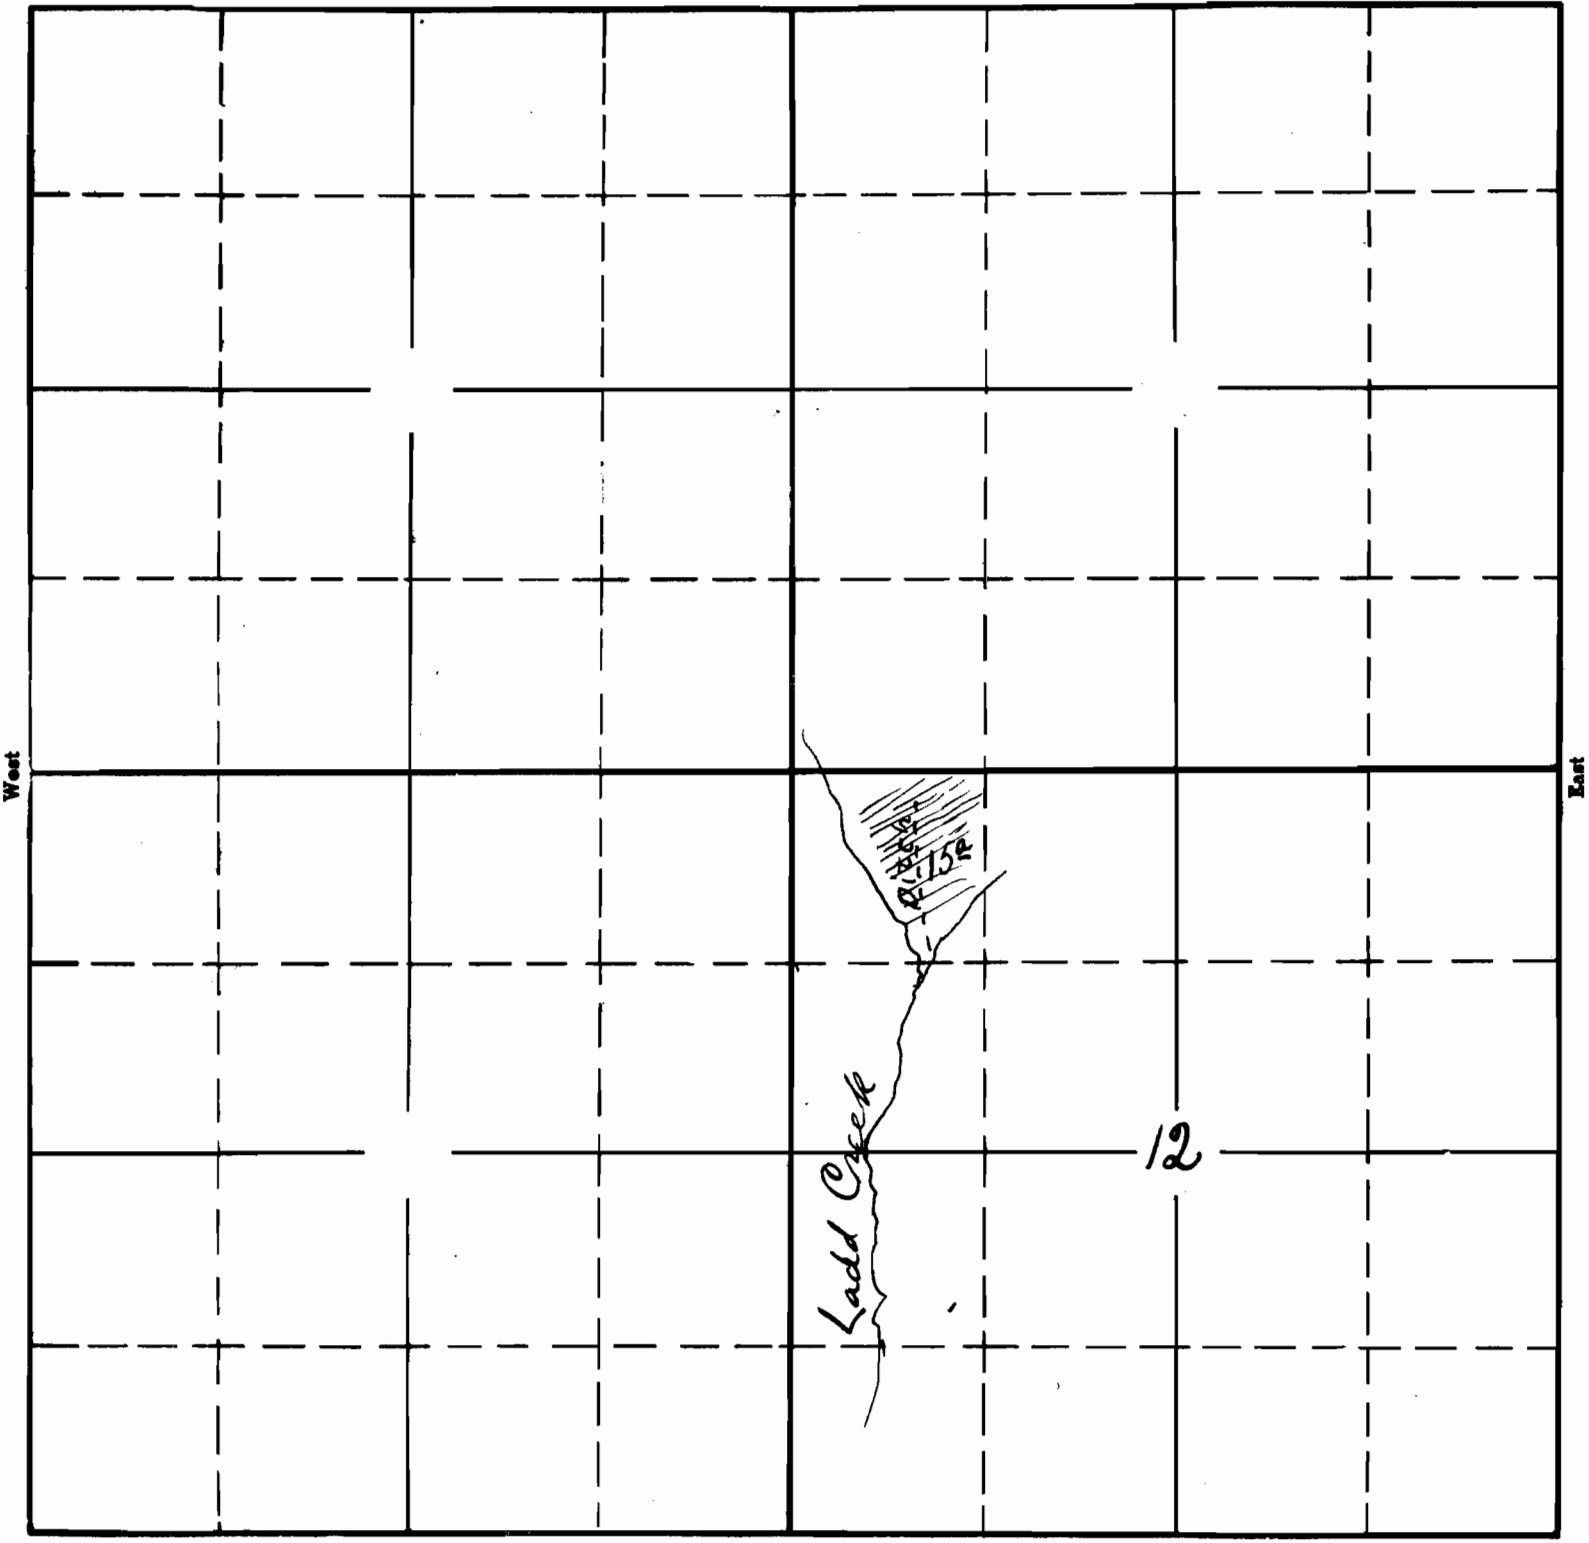

South

RECEIVED
 NOV 10 1941
 STATE ENGINEER
 SALEM, OREGON

APPLICATION No. 19555
 PERMIT No. 15138