


BADGER IMPROVEMENT DISTRICT
 Showing Location of Inchoate Water Rights Under Abstract
 of Permit No. 1516, Application No. 13088, Priority, October 21, 1929, And
 Abstract of Permit R-773, Application No. 13087.
 Drawn by Roger J. Wilhelm, Surveyor and Watermaster of Wasco County, Oregon.
 March, 1953.
 For Final Proof
 under Permit 15165

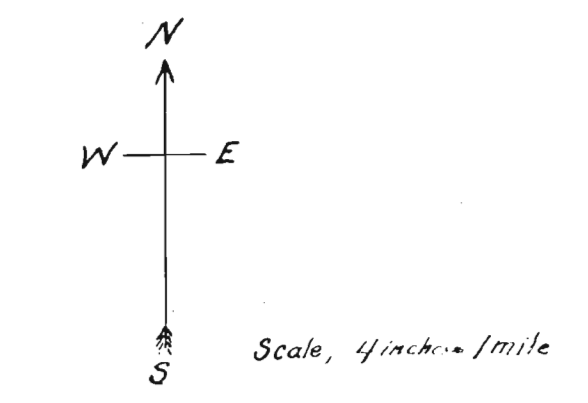

RECEIVED
 JUL 13 1953
 STATE ENGINEER
 OREGON