



2843

E 482

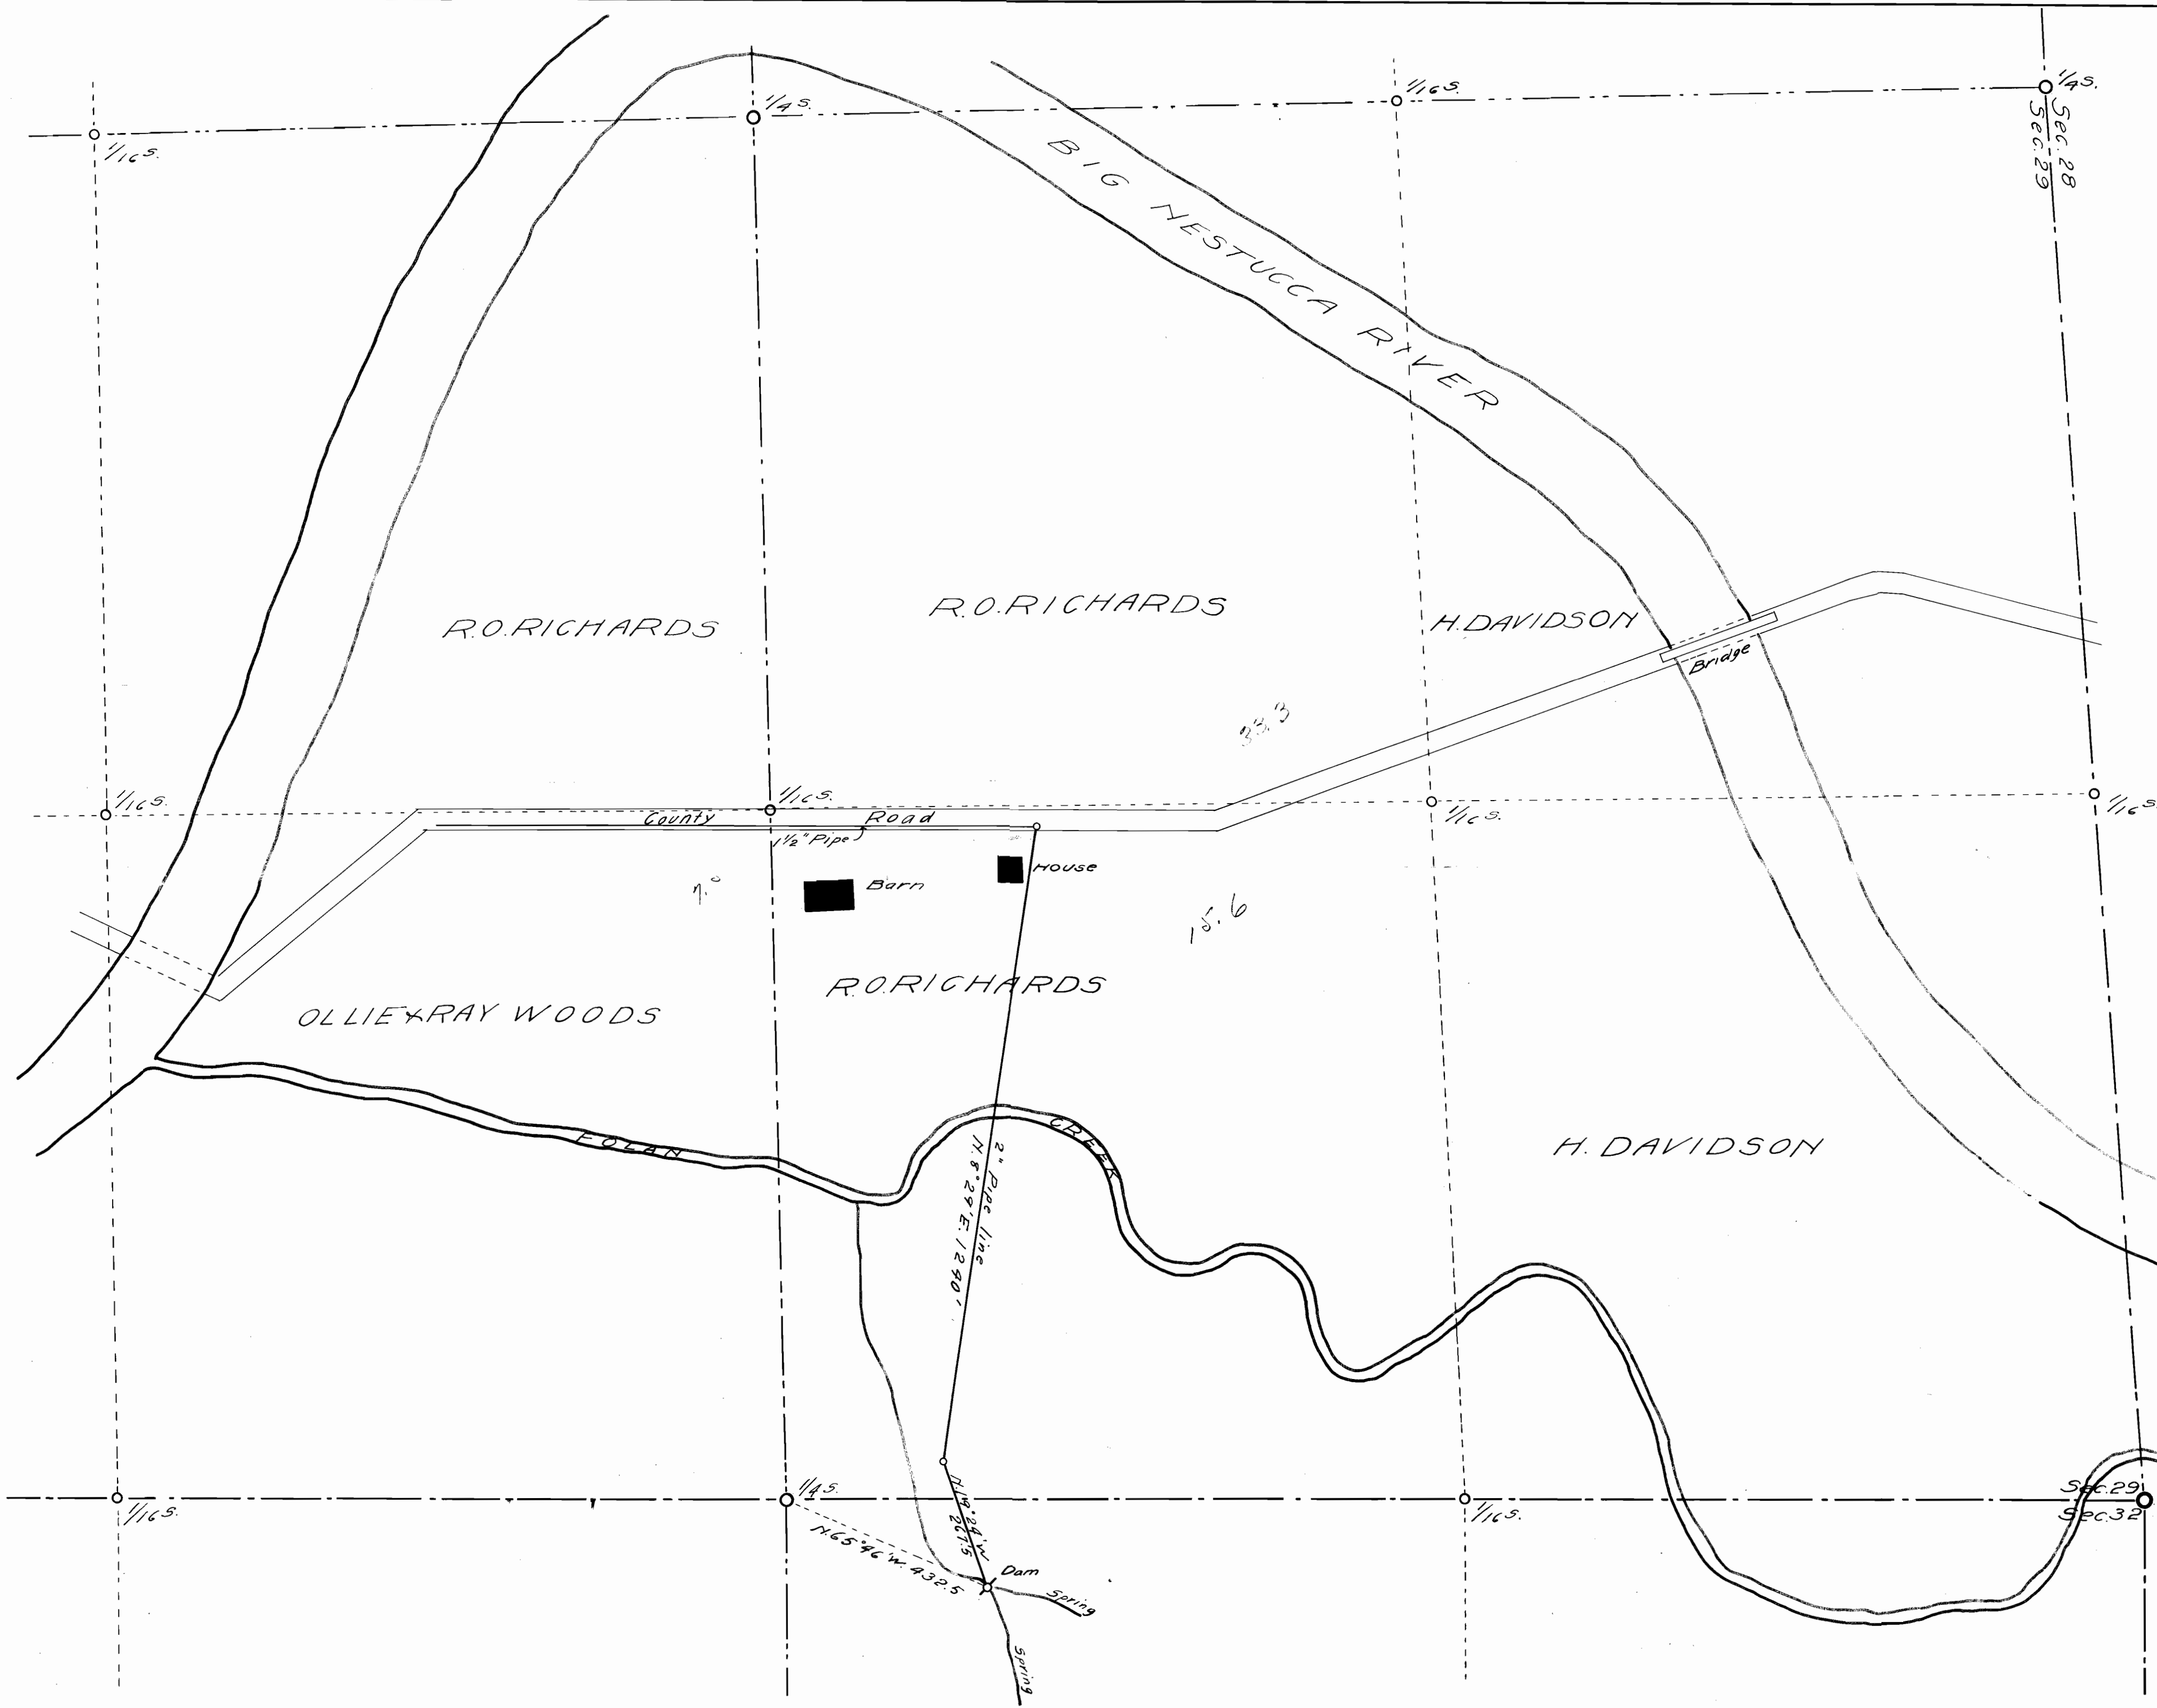

SURVEYOR'S CERTIFICATE-
 I, U.G. Jackson, of Tillamook County, Oregon, do hereby certify that this map was made from notes taken during an actual survey made by me on Dec. 9, 1912, and that it correctly represents the works described in the accompanying application.
 U.G. Jackson
 Co. Surveyor
 March 11, 1913.

2843-
 Report No. 1520

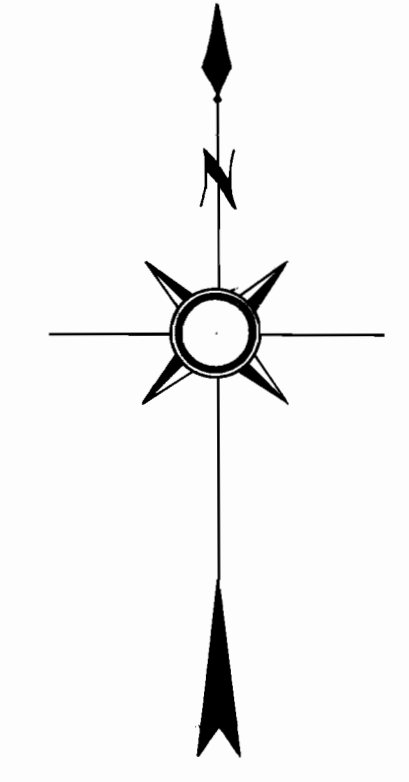

MAP
 OF
SPRING WATER RIGHT
 FOR
R. O. RICHARDS
 SEC. 29, 32, T. 3S., R. 9W. W.M.
 TILLAMOOK COUNTY
 OREGON
 SCALE - 1" = 200'
 MARCH 11, 1913

587

587

587