

SECTION


Permit: S 15206  
Volume: 8  
Strm: E FK ILLINOIS R  
Trib: ILLINOIS R  
Priority: 2/25/42

TOWNSHIP 40 S, RANGE 8 W.

Scale 4" = 1 Mile

North Feb. 42

U.S. MIDDARD

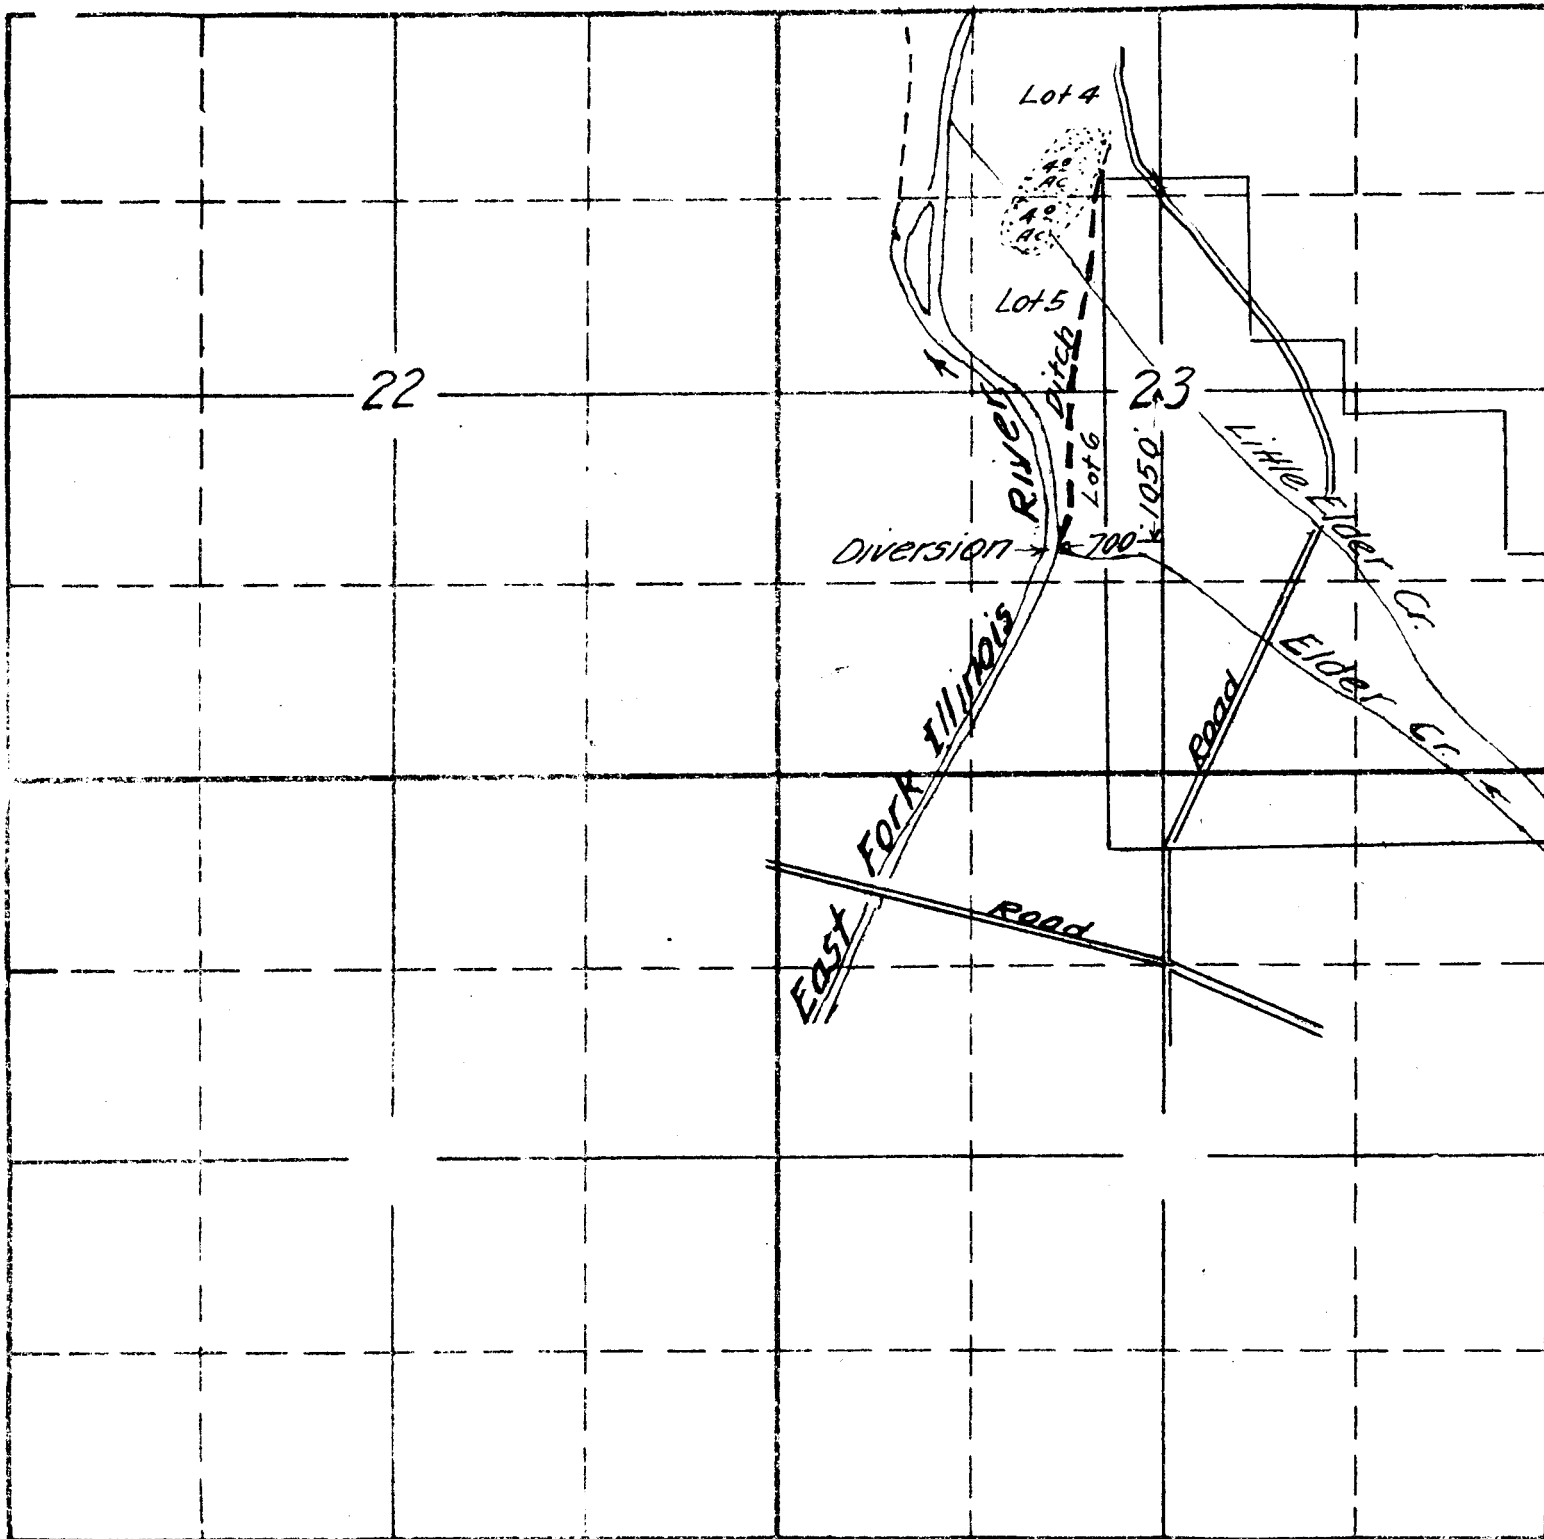

South

1963 2

APPLICATION No. 1963 2

PERMIT No. 15206