

SECTION


29

TOWNSHIP 35S, RANGE 1W, W. M.

RECORDED

MAR 28 1942

STATE ENGINEER
SALEM, OREGON

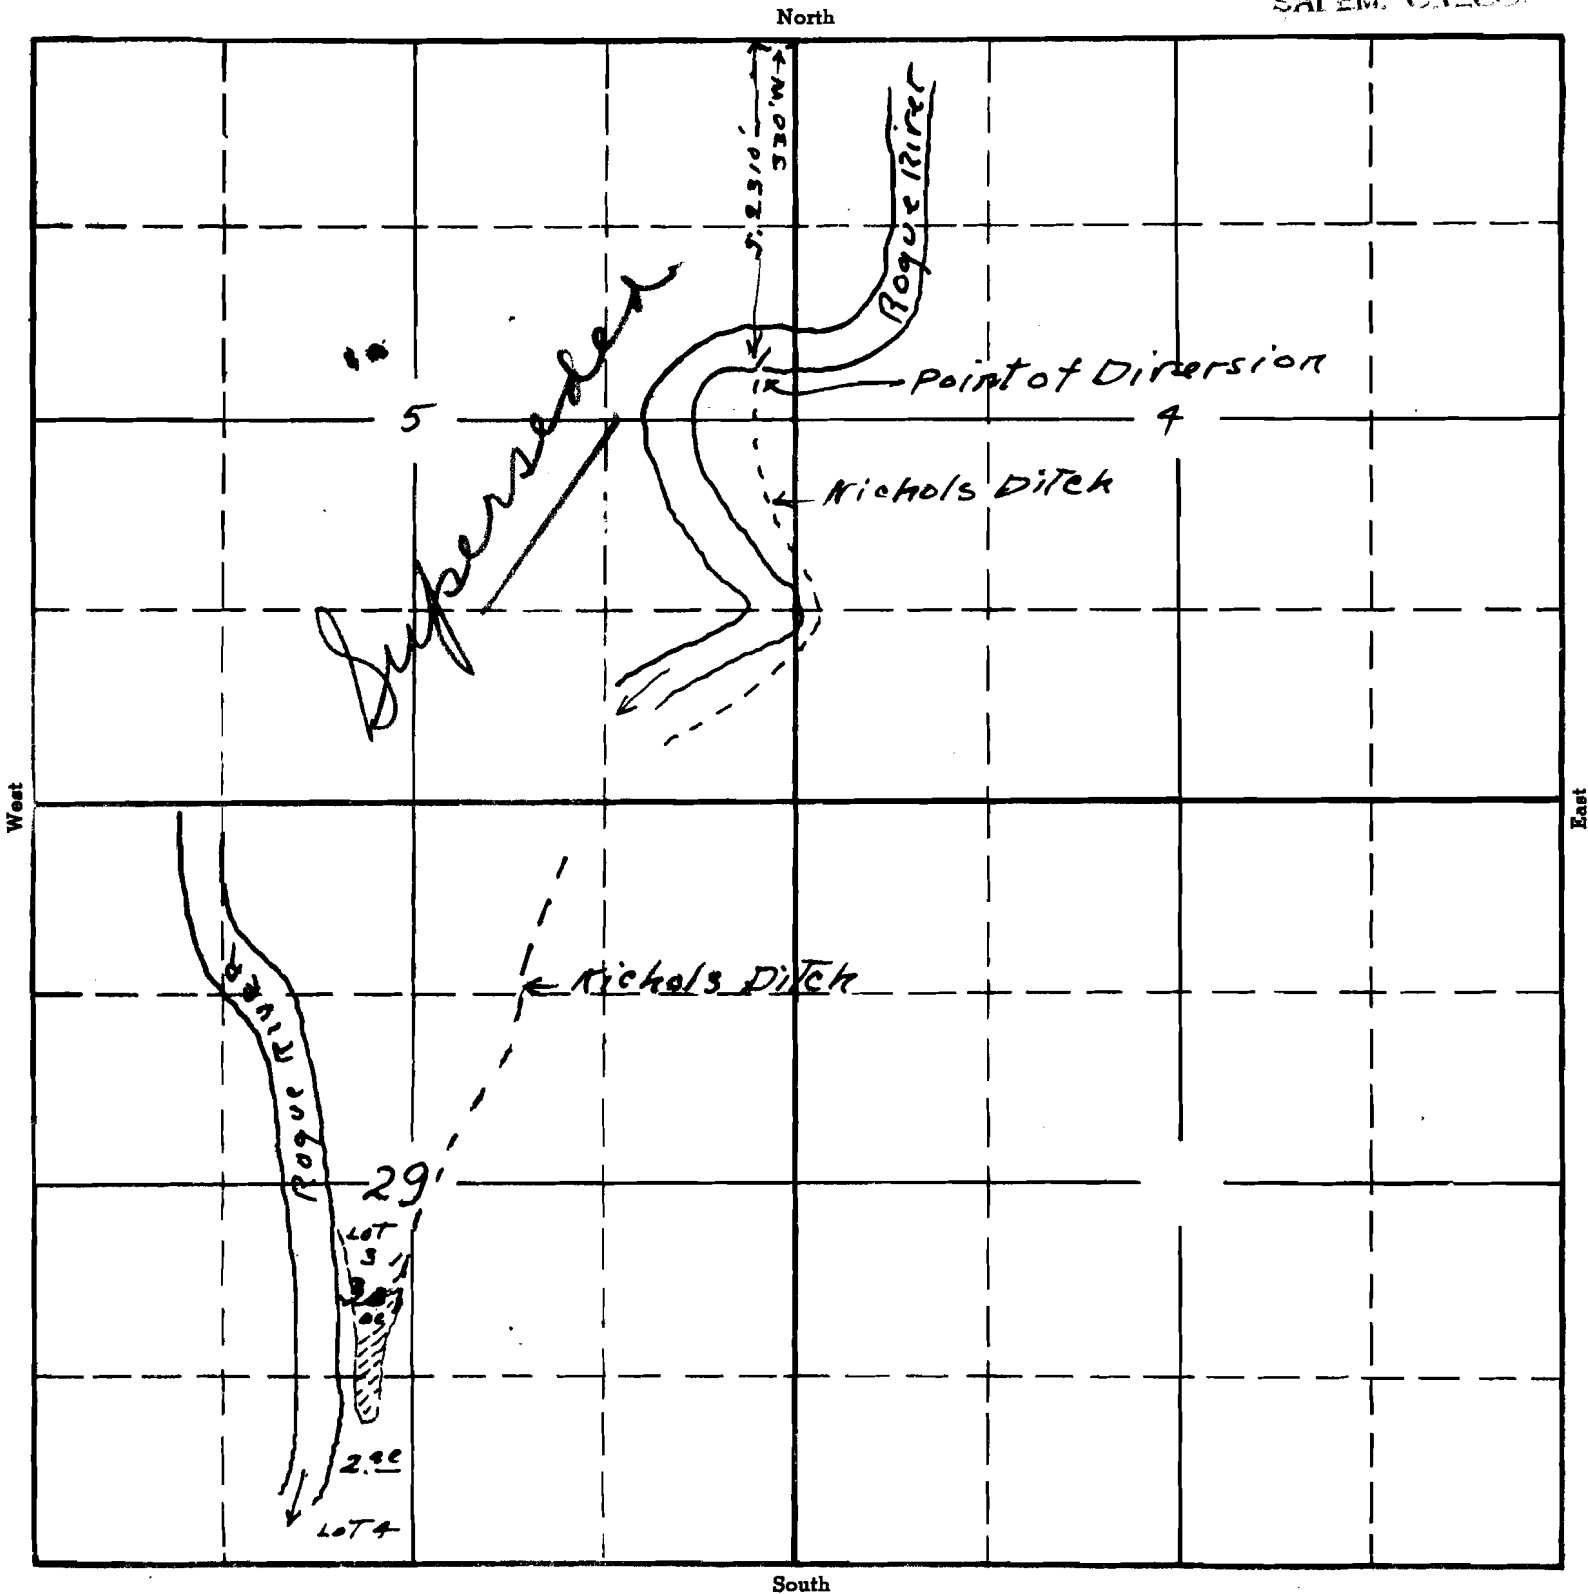


APPLICATION No. 19648
PERMIT No. 15221

29

TOWNSHIP 35S, RANGE 1W, W. M.

North

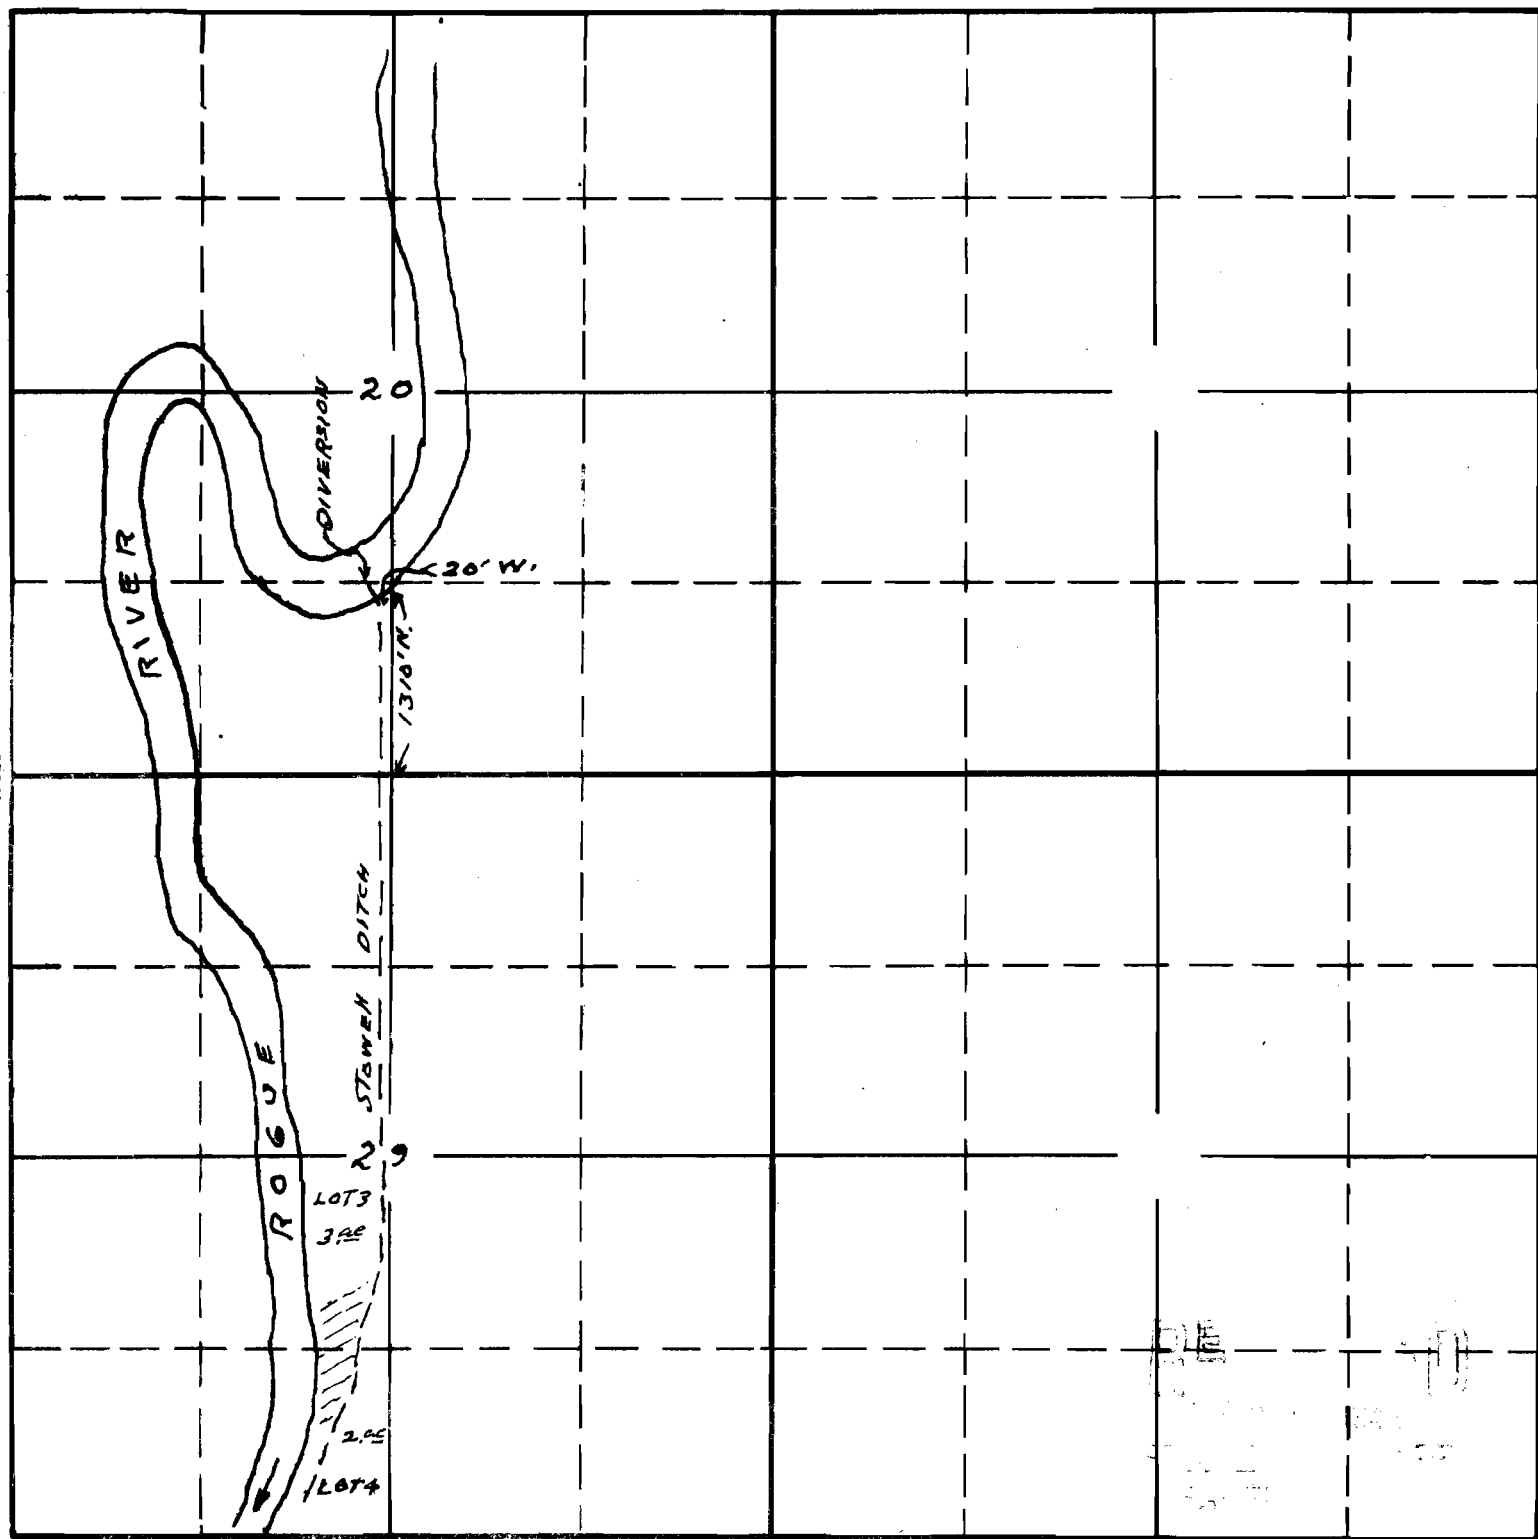

South

Sketch to accompany final proof of
Permit No 15221 To correct point of
diversion.

APPLICATION No.

PERMIT No.

Initiated by George H Stowell by App. No. 19698
Priority of Mar. 24, 1942.

10/3/42 C. L. Smith