

SECTION


\_\_\_\_\_

\_\_\_\_\_

\_\_\_\_\_

TOWNSHIP 18 S, RANGE 5 W, W. M.

North

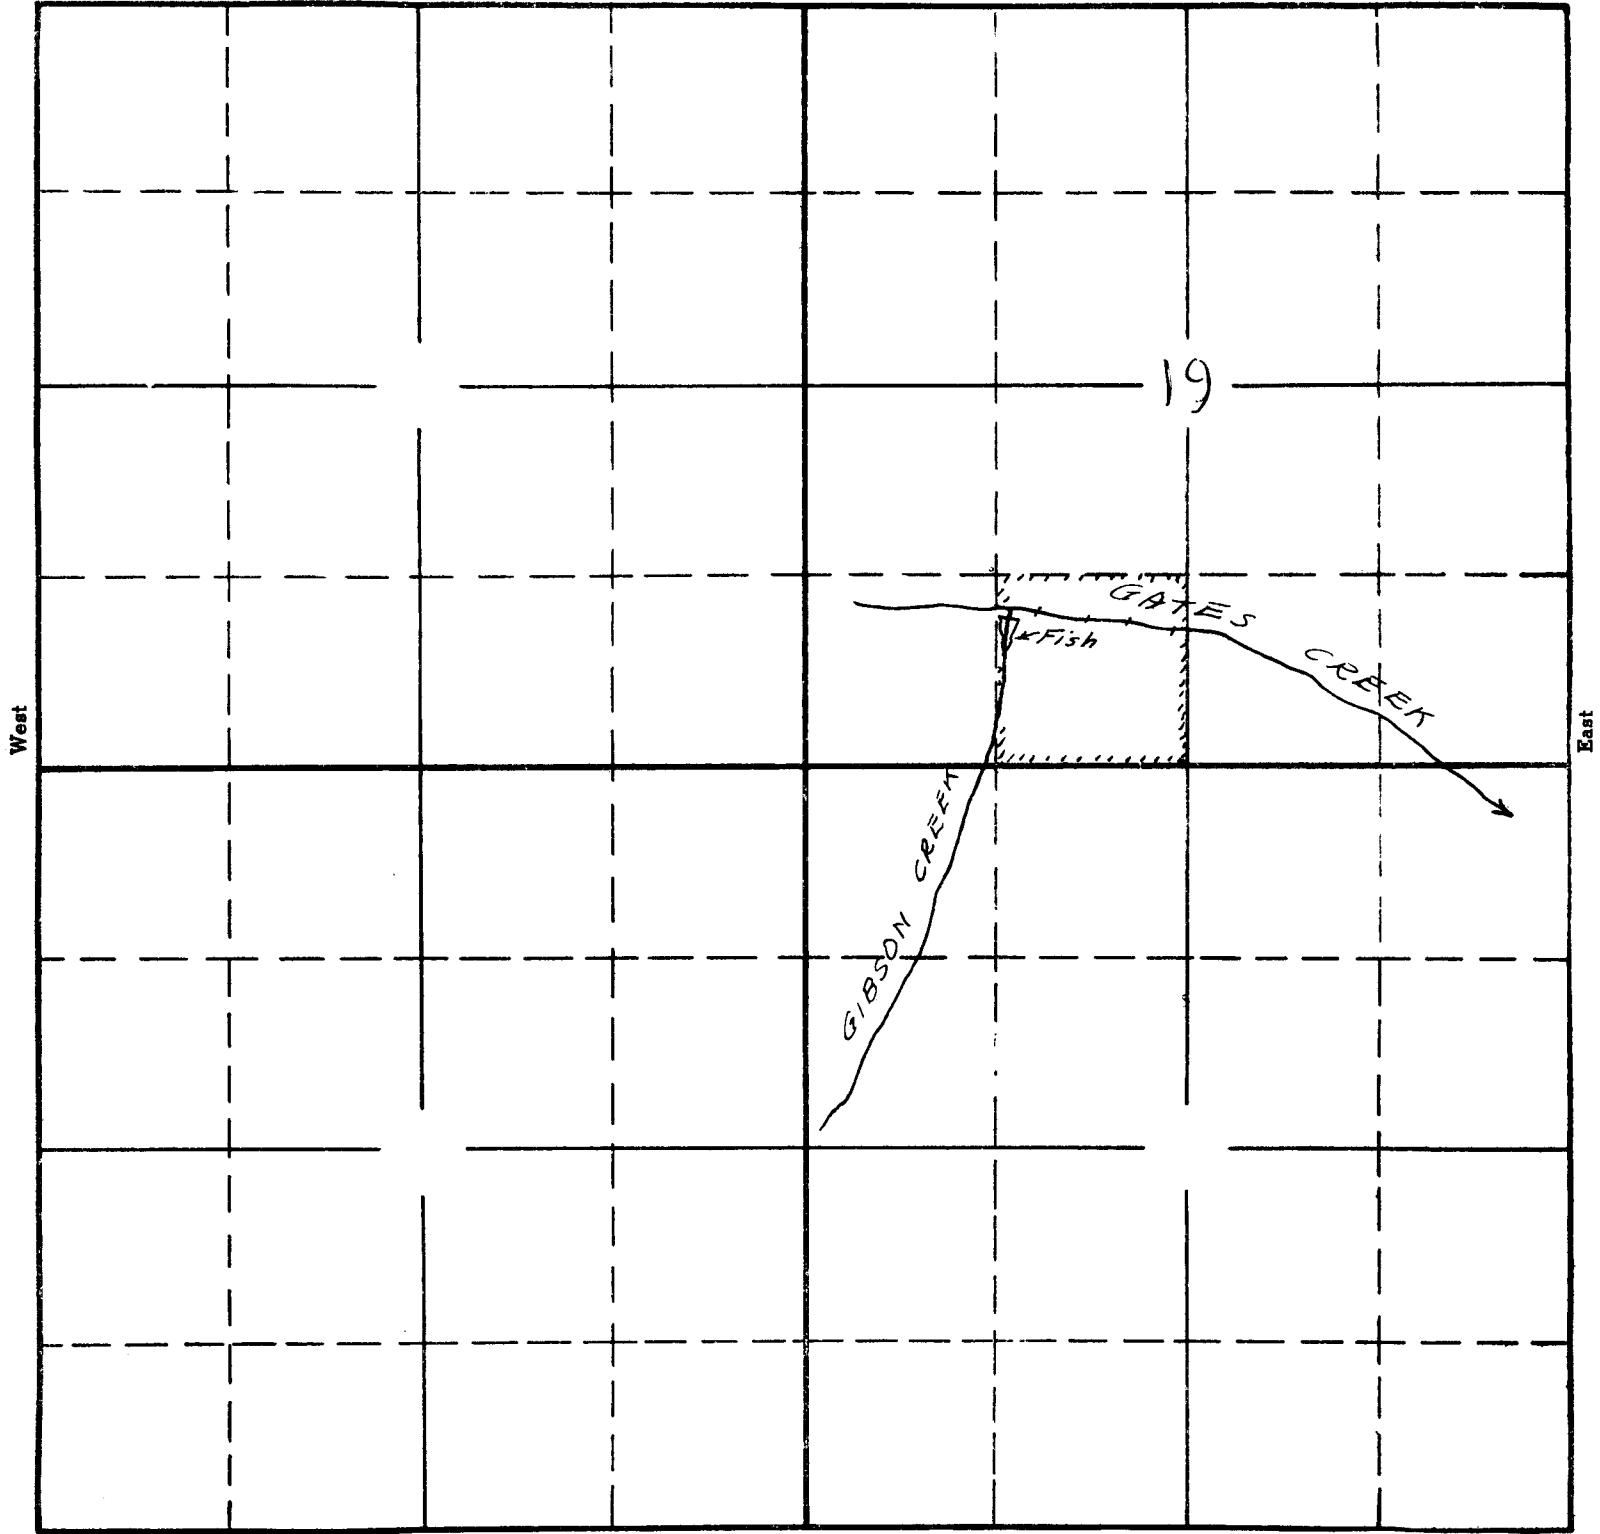

South

19720 DL  
2-14

Sketched in office of the State Engineer from Metsker map and data by applicant 5-25-42.

APPLICATION No. 19720  
PERMIT No. 15292