
TOWNSHIP 33 S., RANGE 6 W., W. M.

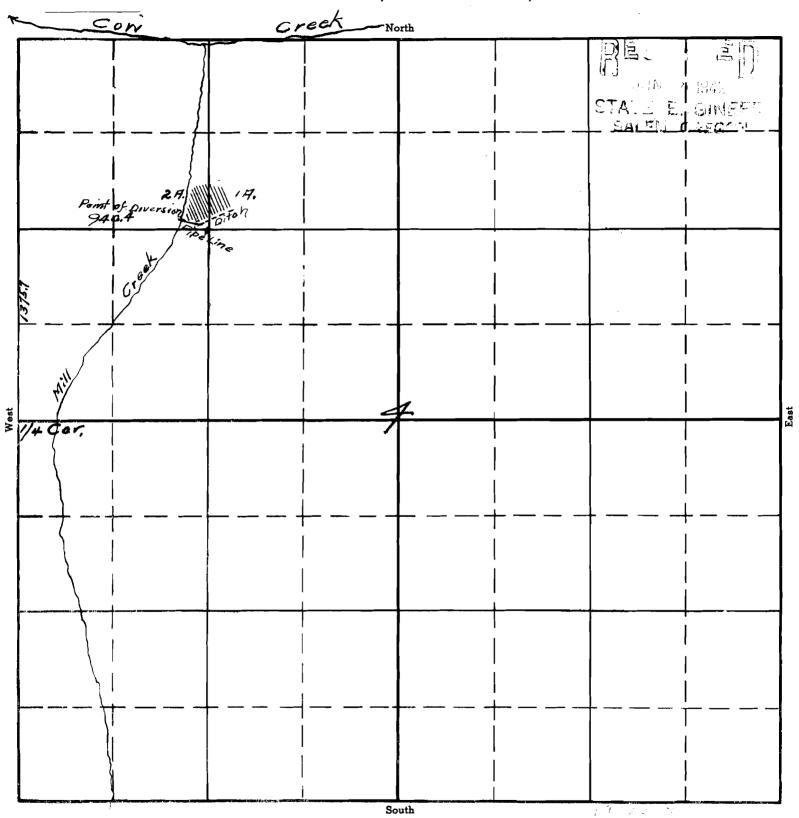

APPLICATION No. 19723
PERMIT No. 15295