


Sec 25

Township 40. Range 8^W. M.
north

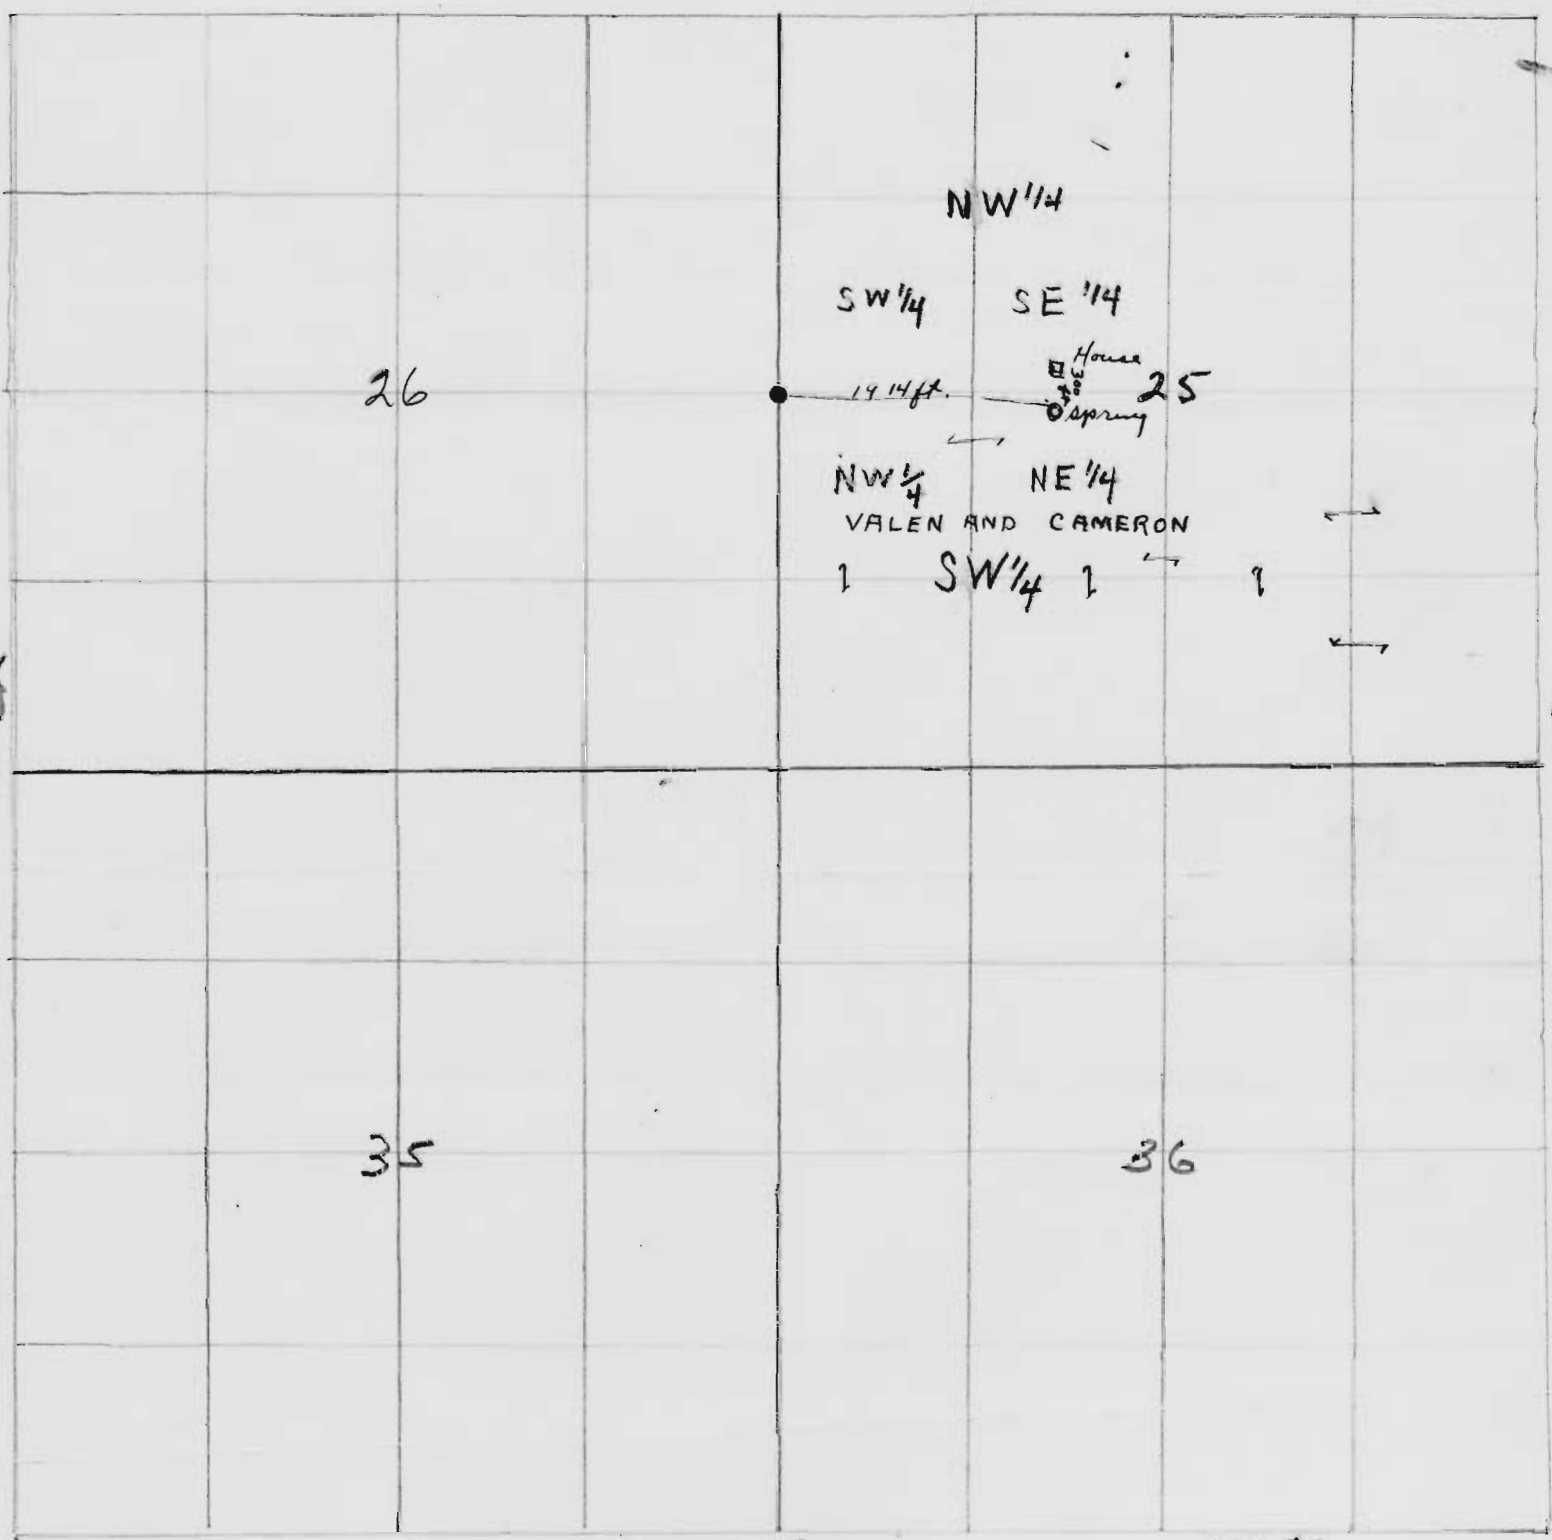

south

19750
15368

RECEIVED
 JUL 20 1942
 STATE ENGINEER
 SALEM, OREGON

RECEIVED
 JUL 29 1942
 STATE ENGINEER
 SALEM, OREGON

Application No. 19750
Permit No. 15336