

SECTION


28

TOWNSHIP 13 S, RANGE 10 W, W. M.

North

West

East

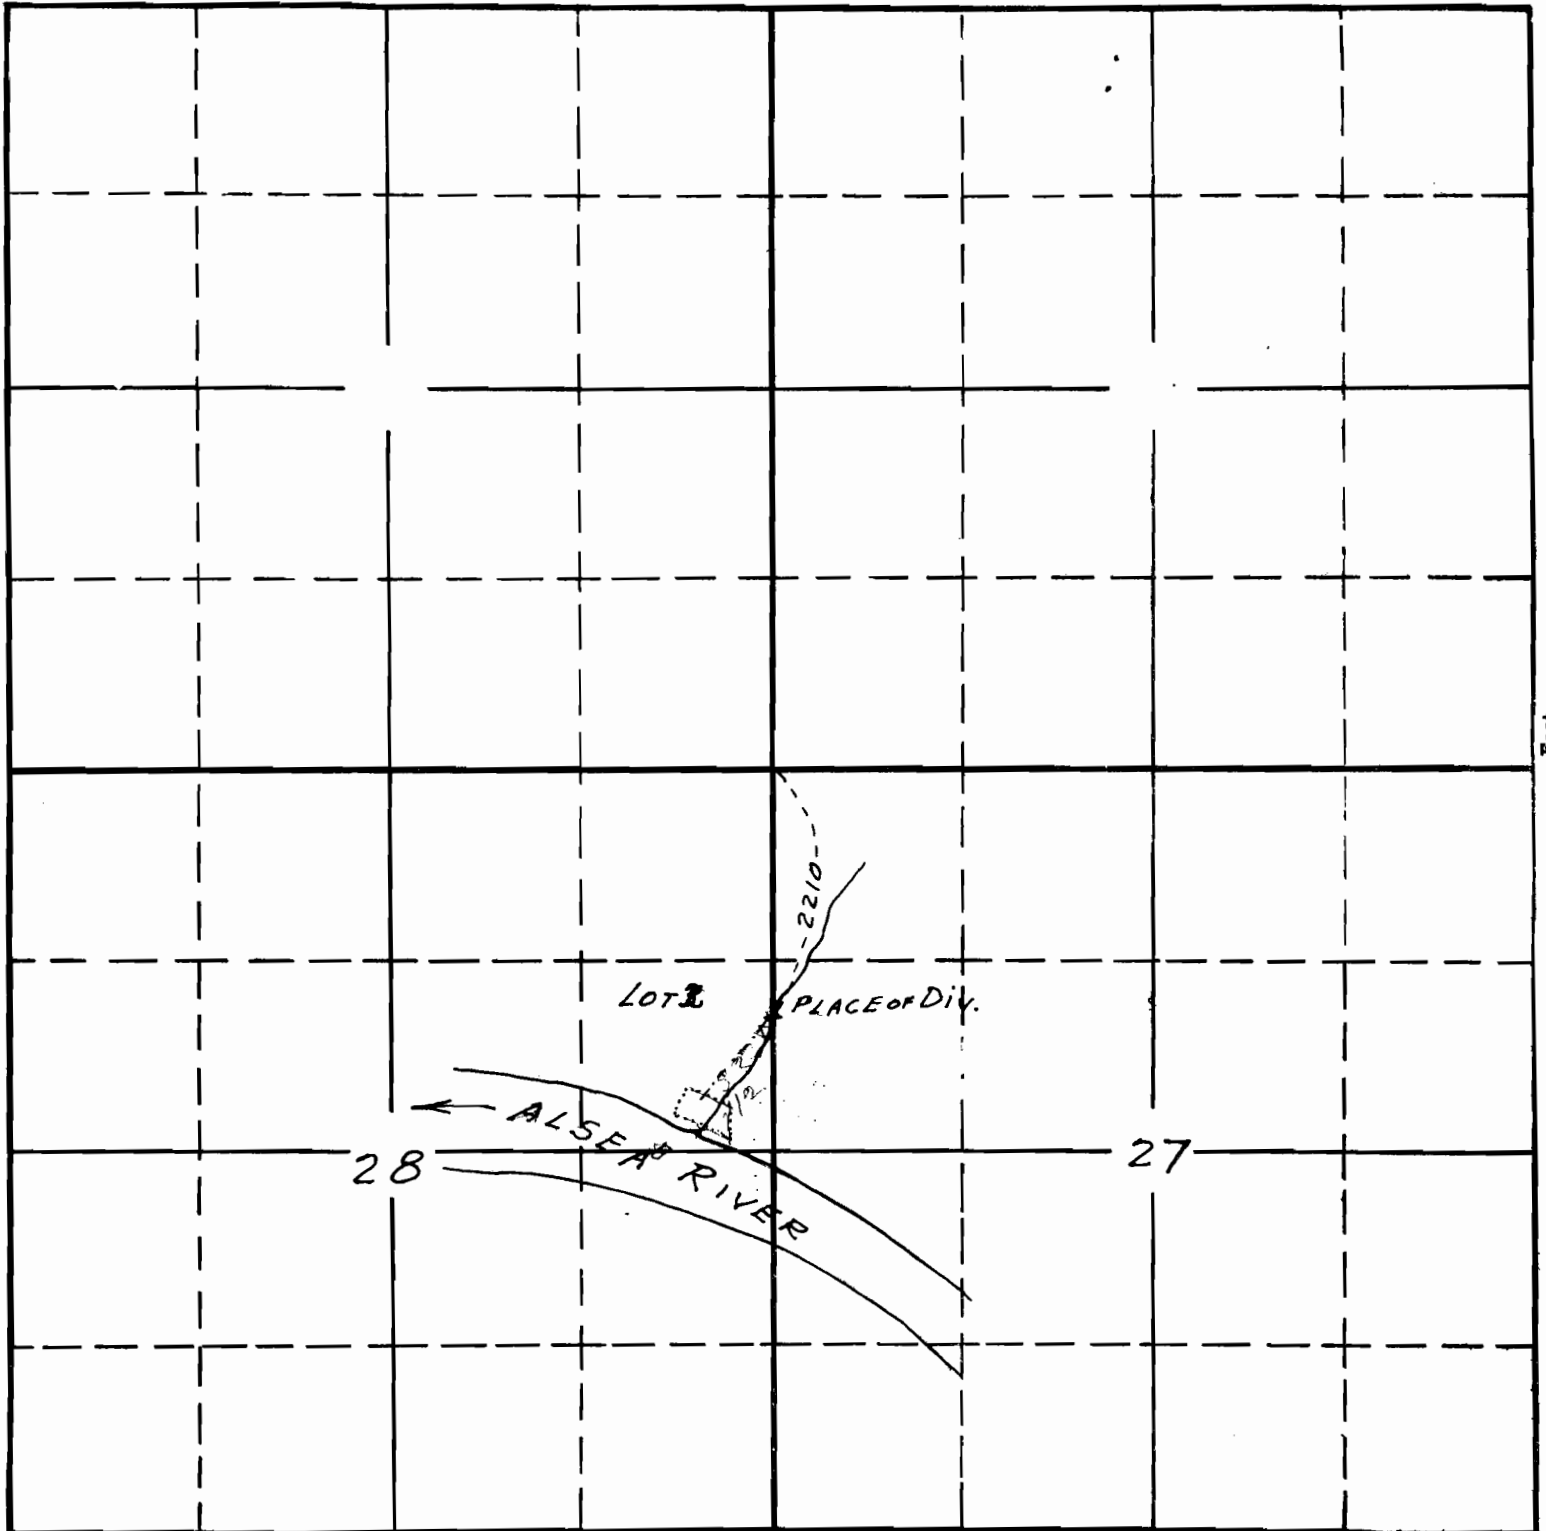

South

19757 ORC
18-11

APPLICATION No. 19757

PERMIT No. 15343