


21

TOWNSHIP 36 S, RANGE 3 W, W. M.

North

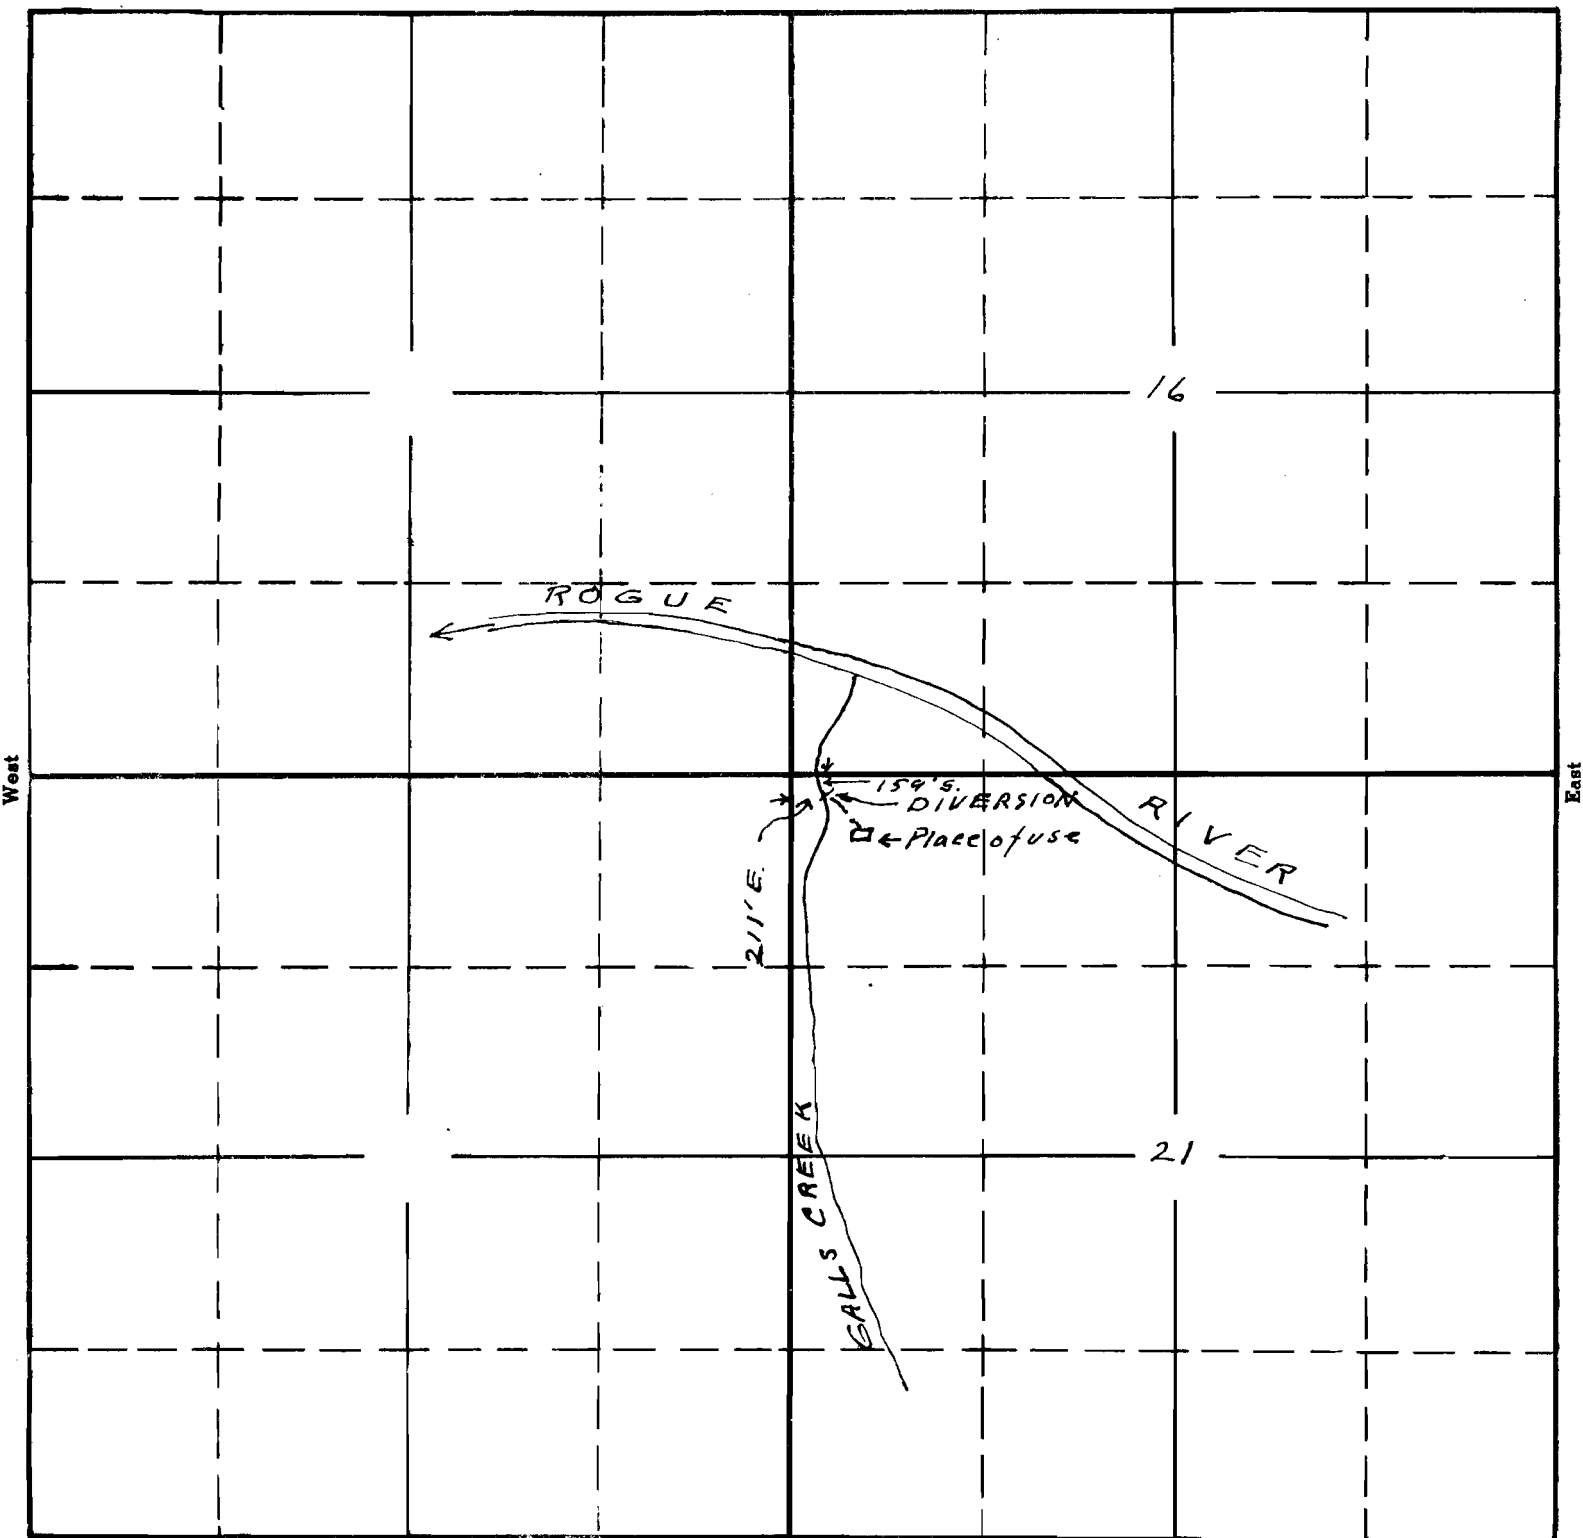

South

Sketch to accompany application of Earnest T Ross for use of Galls Cr. and spring in Galls Creek

19779 ac  
15-73 A

APPLICATION No. 19779

PERMIT No. 15362

This office of SA [Signature]