


24

TOWNSHIP 38 S , RANGE 3 E , W. M.

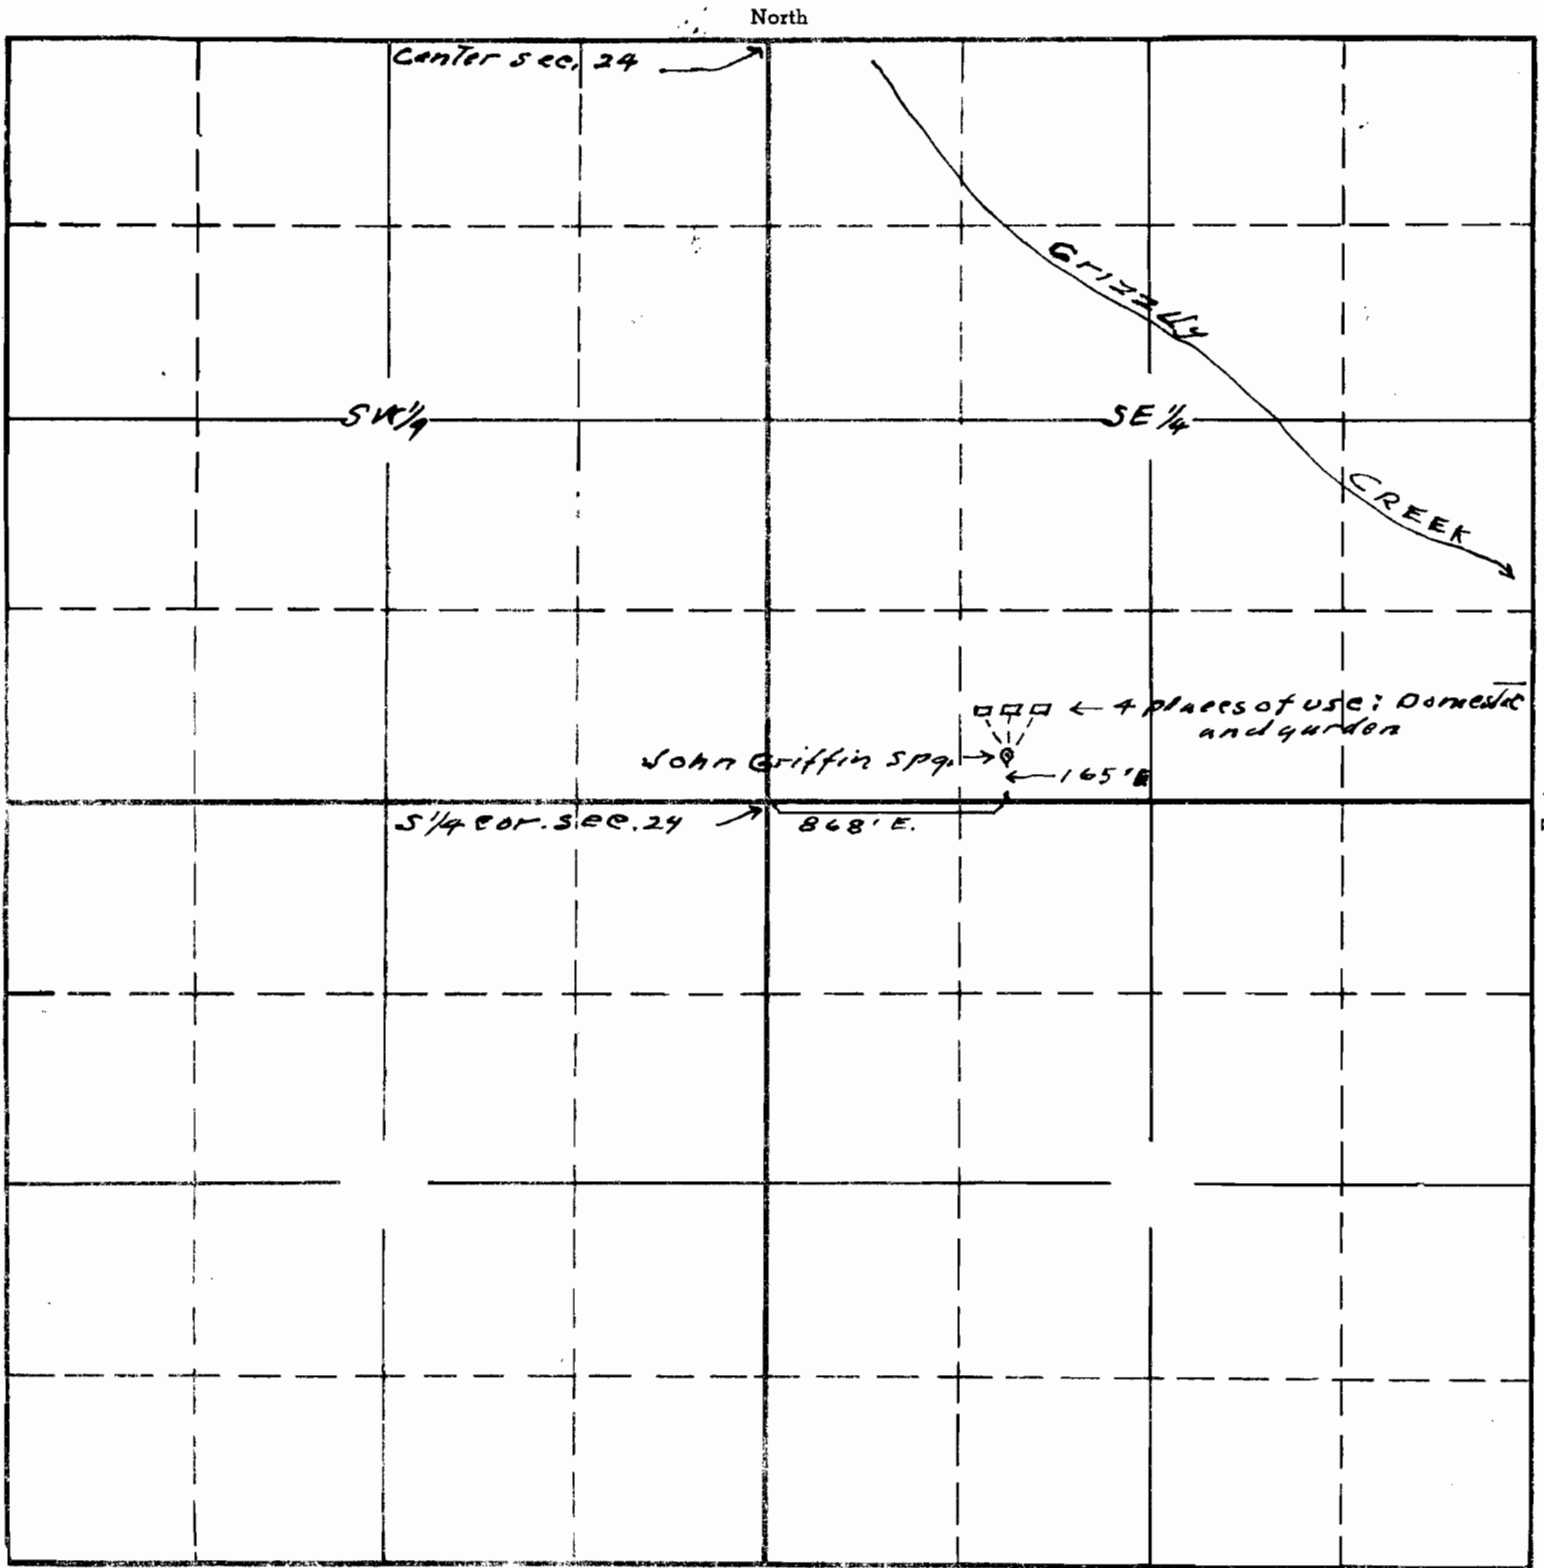

Sketch to accompany application of
 Wm Lindsay for use of John Griffin
 Spring for domestic and garden for
 four families

APPLICATION No. 19787
 PERMIT No. 15367

This office 9/5/42 *[Signature]*