


TOWNSHIP 32 S , RANGE 3 E , W. M.

32

North

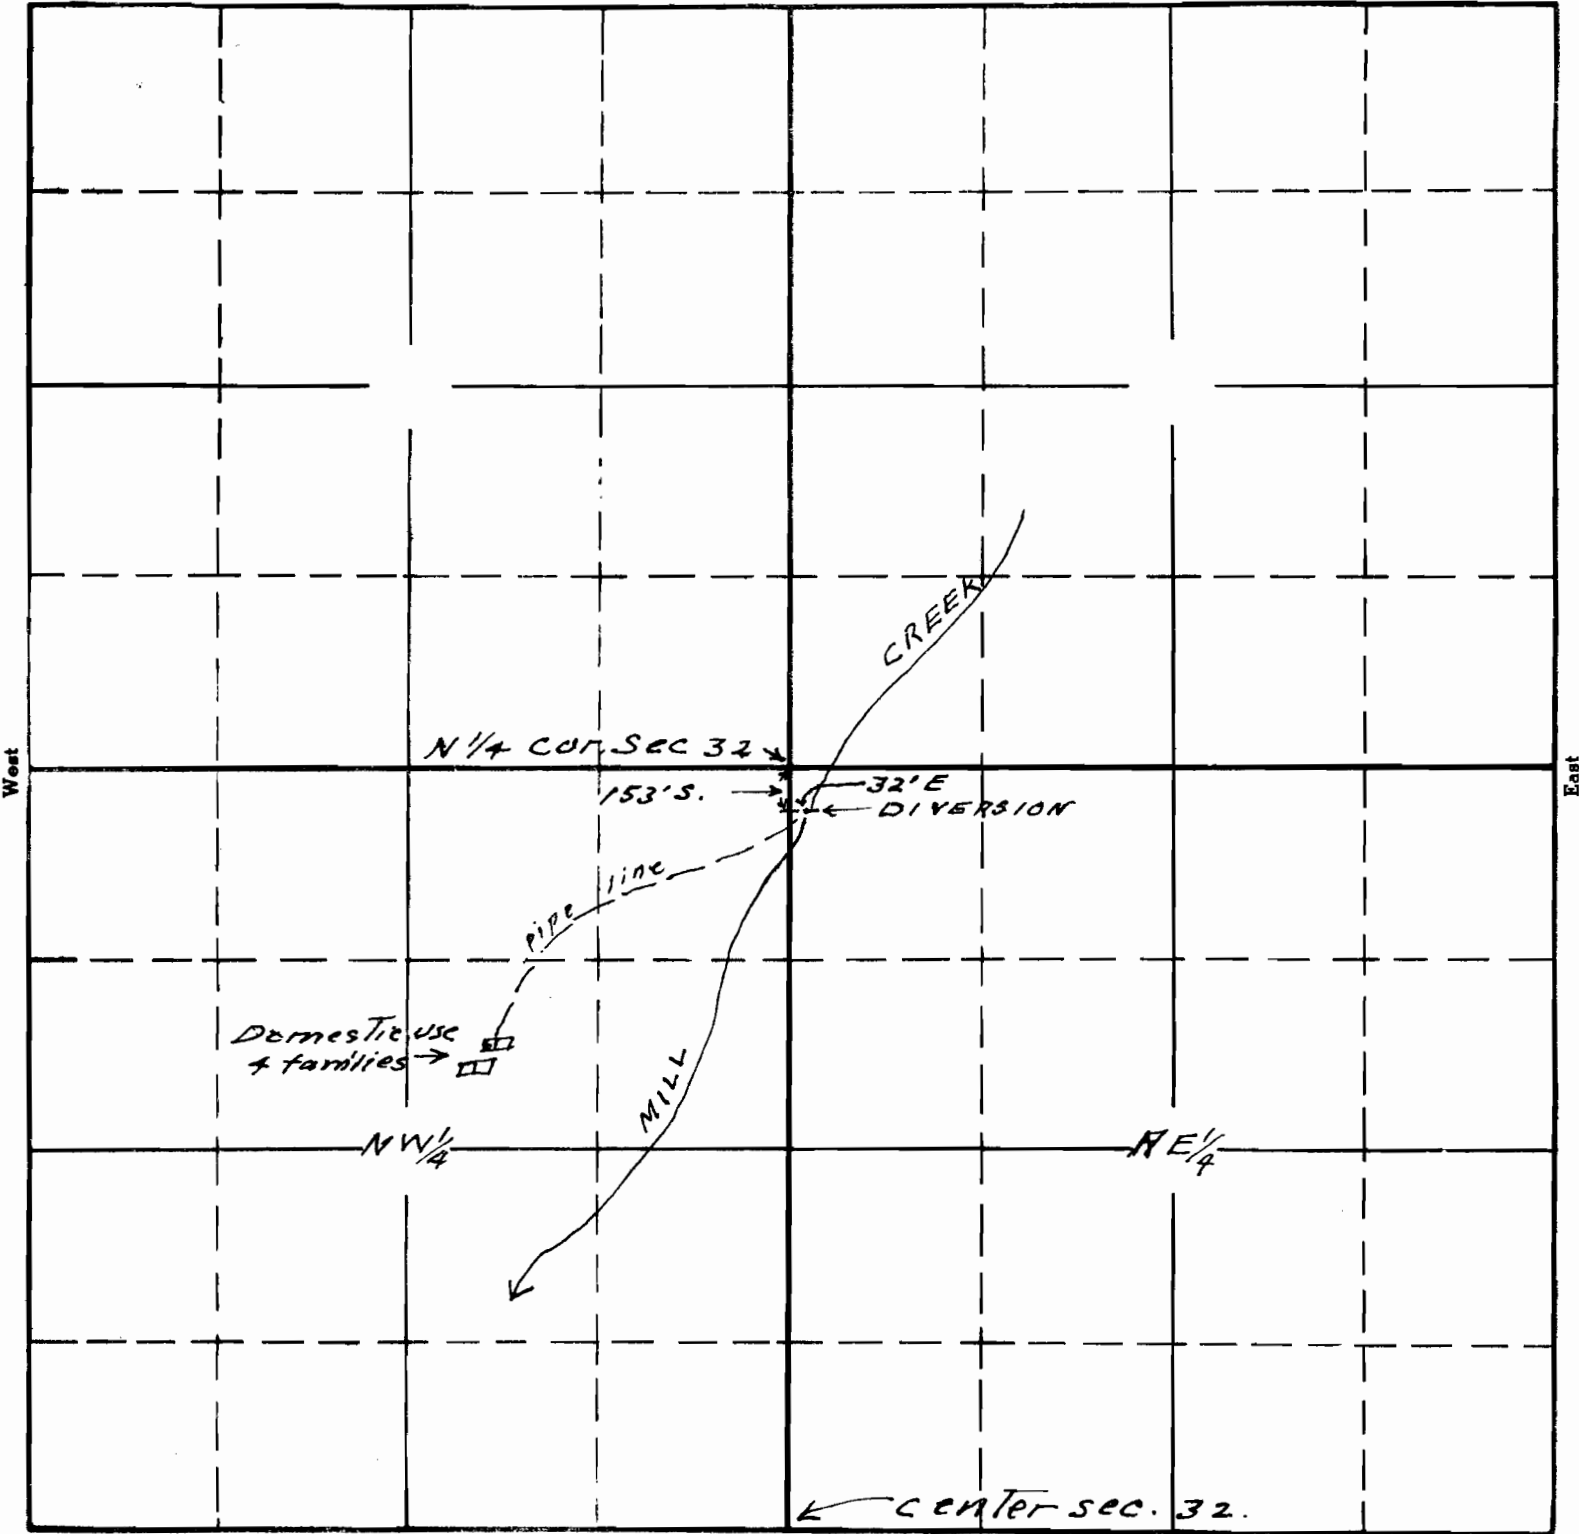

Sketch to accompany application of
 Fred Svintz for use of waters of
 Mill Creek for 4 families domestic
 and one swimming pool

19790
 APPLICATION No. 19790
 PERMIT No. 15370

This office 9/8/42 *Andy*