


SECTION

TOWNSHIP 39 S, RANGE 8 W, W. M.

North

West

East

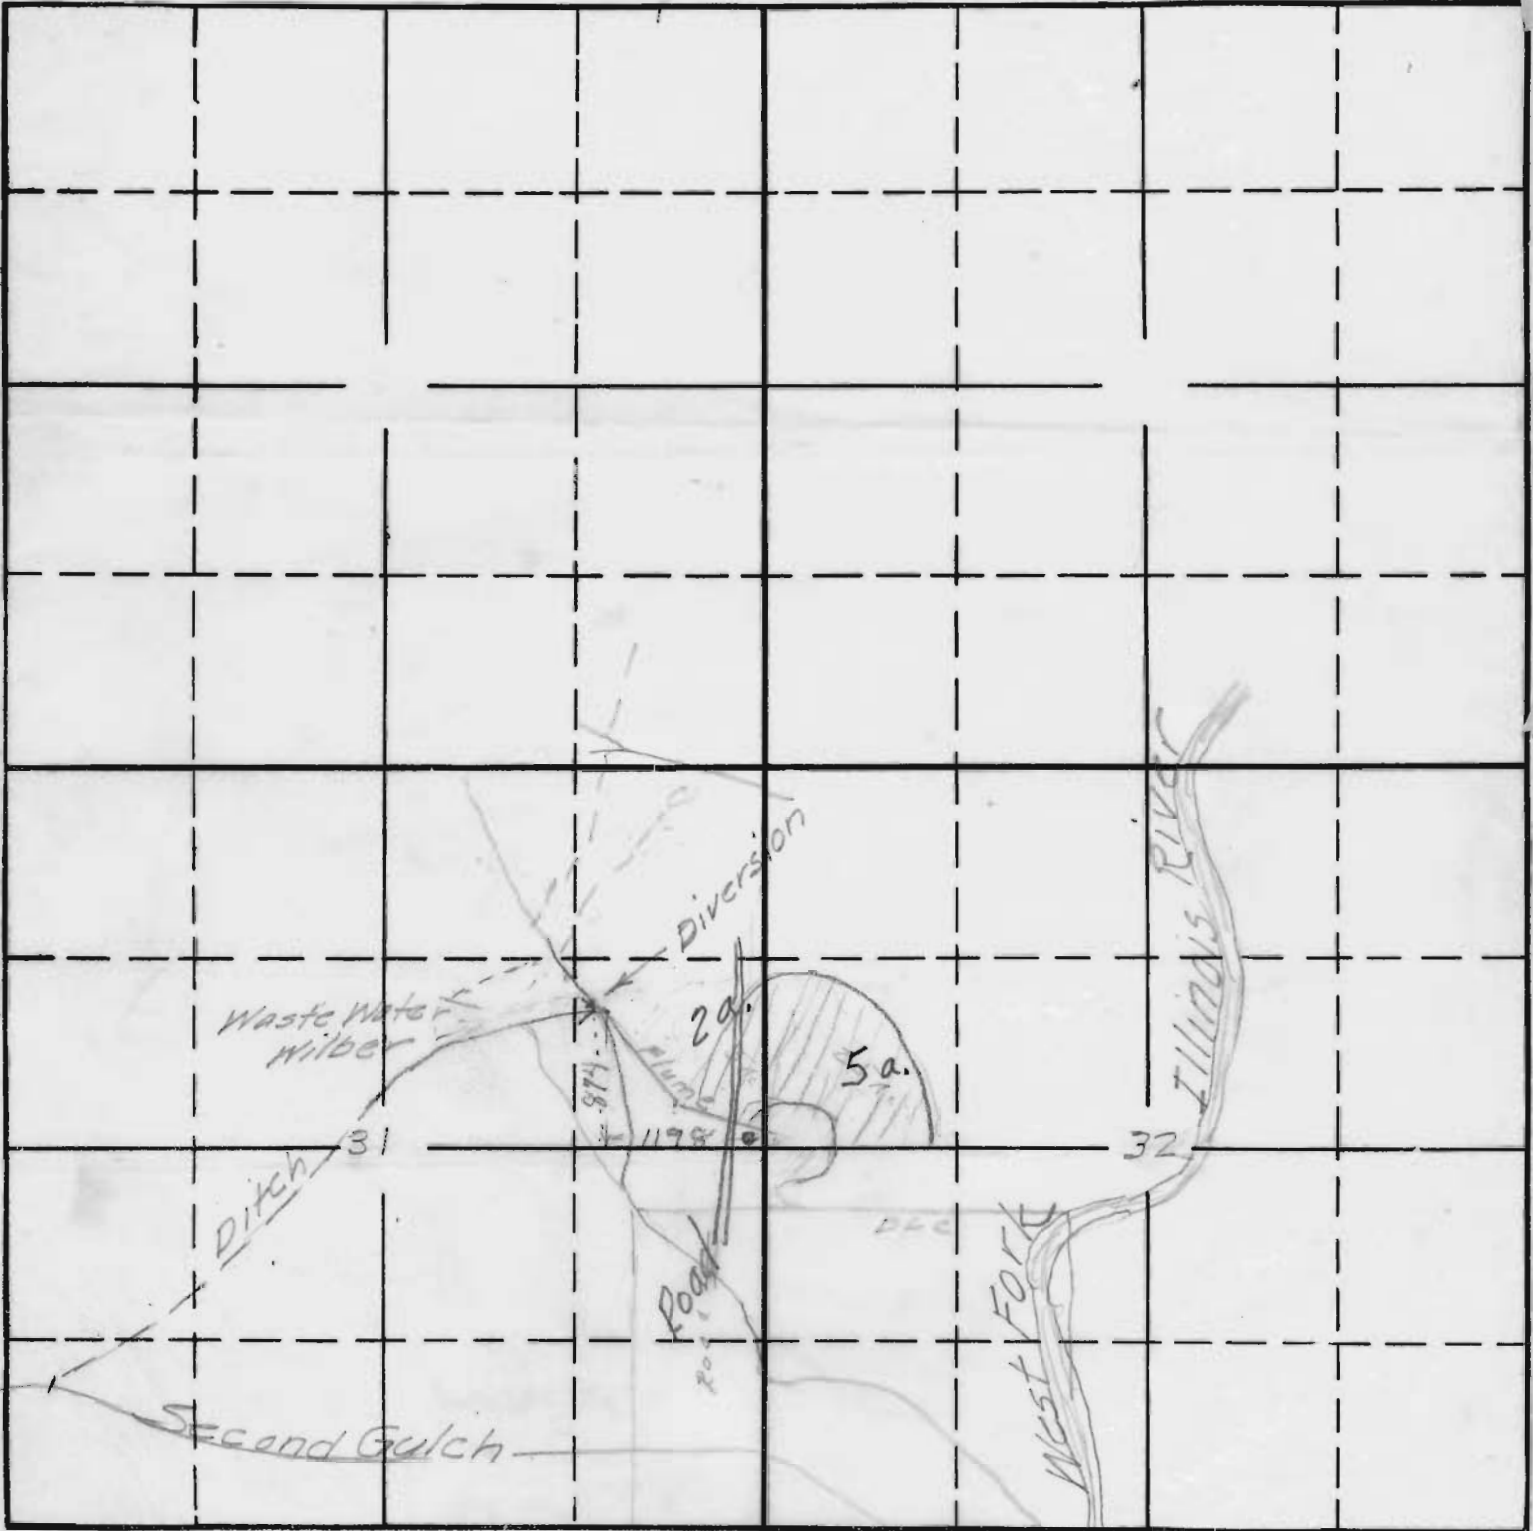

South

19796 ac
 15-56 B
 APPLICATION No. 19796
 PERMIT No. 15382