


SECTION

DE 30

STATE ENGINEER

TOWNSHIP 15, RANGE 38 E, W. M. STATE ENGINEER

North

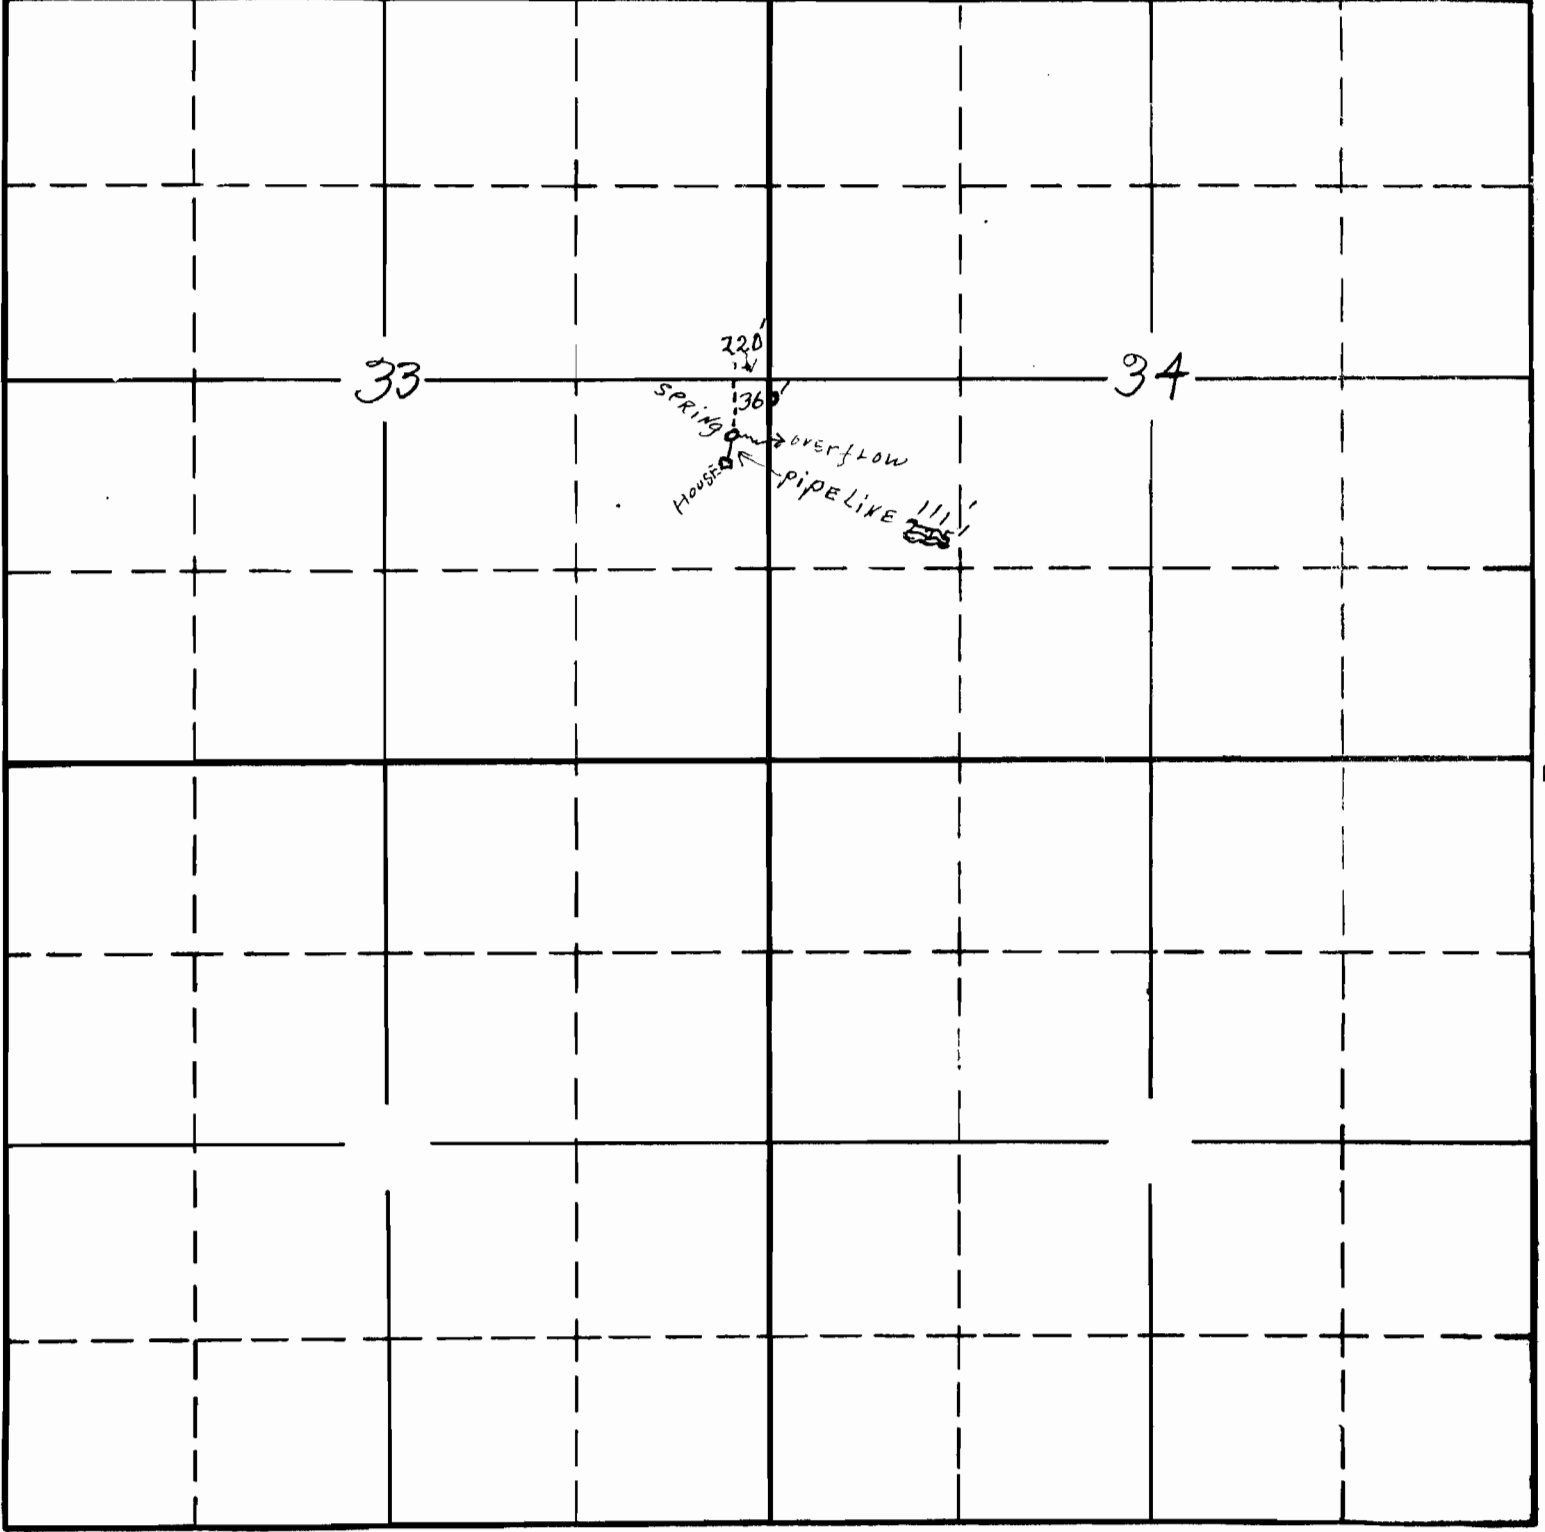

South

19812 OK
 S-15
 APPLICATION No. 19812
 PERMIT No. 15392