


T.5S.R.1W.W.M.

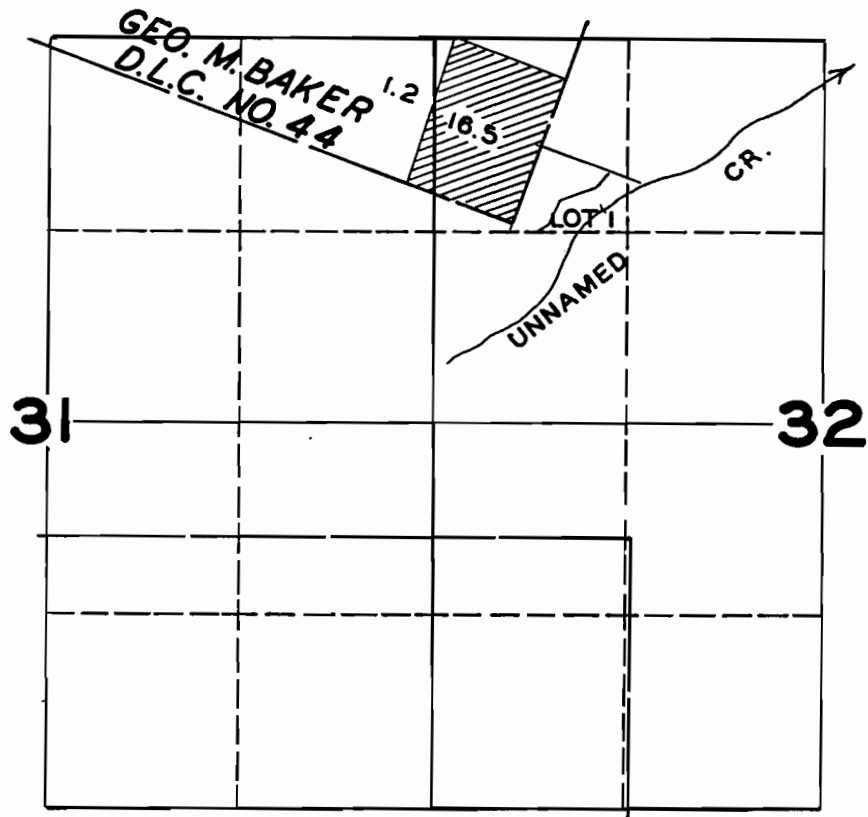

FINAL PROOF SURVEY

UNDER

Application No. 21425 Permit No. 16916

IN NAME OF

JOSEPH G. SMITH

Surveyed MAY 2, 1949, by JAS. E. BUNNELL