


15

TOWNSHIP 36 S, RANGE 3 W, W. M.

North

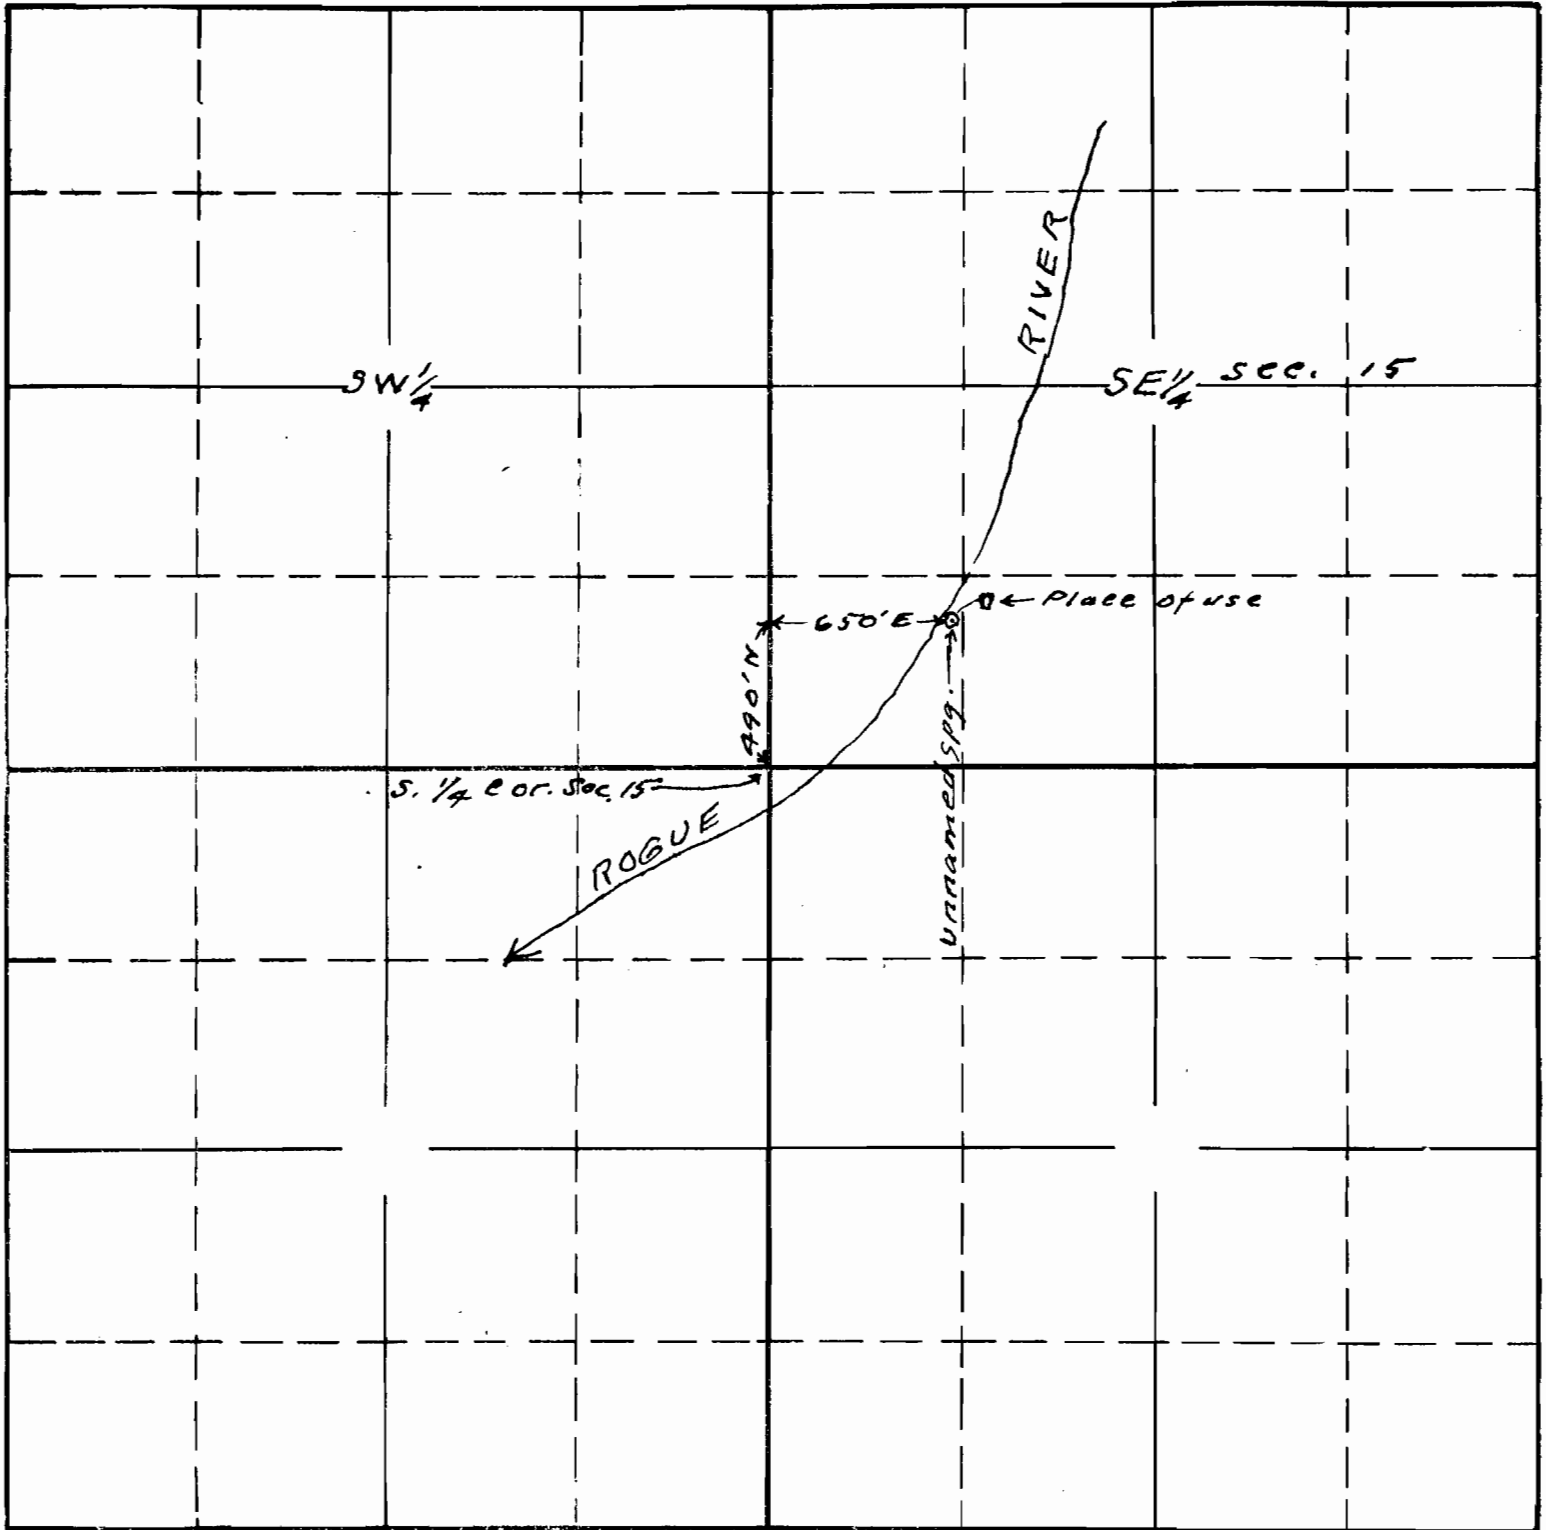

East

South

Sketch To accompany application of
 City of Gold Hill for use of
 unnamed spring for domestic use

19805 or
 15-78A
 APPLICATION No. 19805
 PERMIT No. 15417

This office 9/26/92 *[Signature]*