


Sec.

TP. 39 S.

R. 5 W.

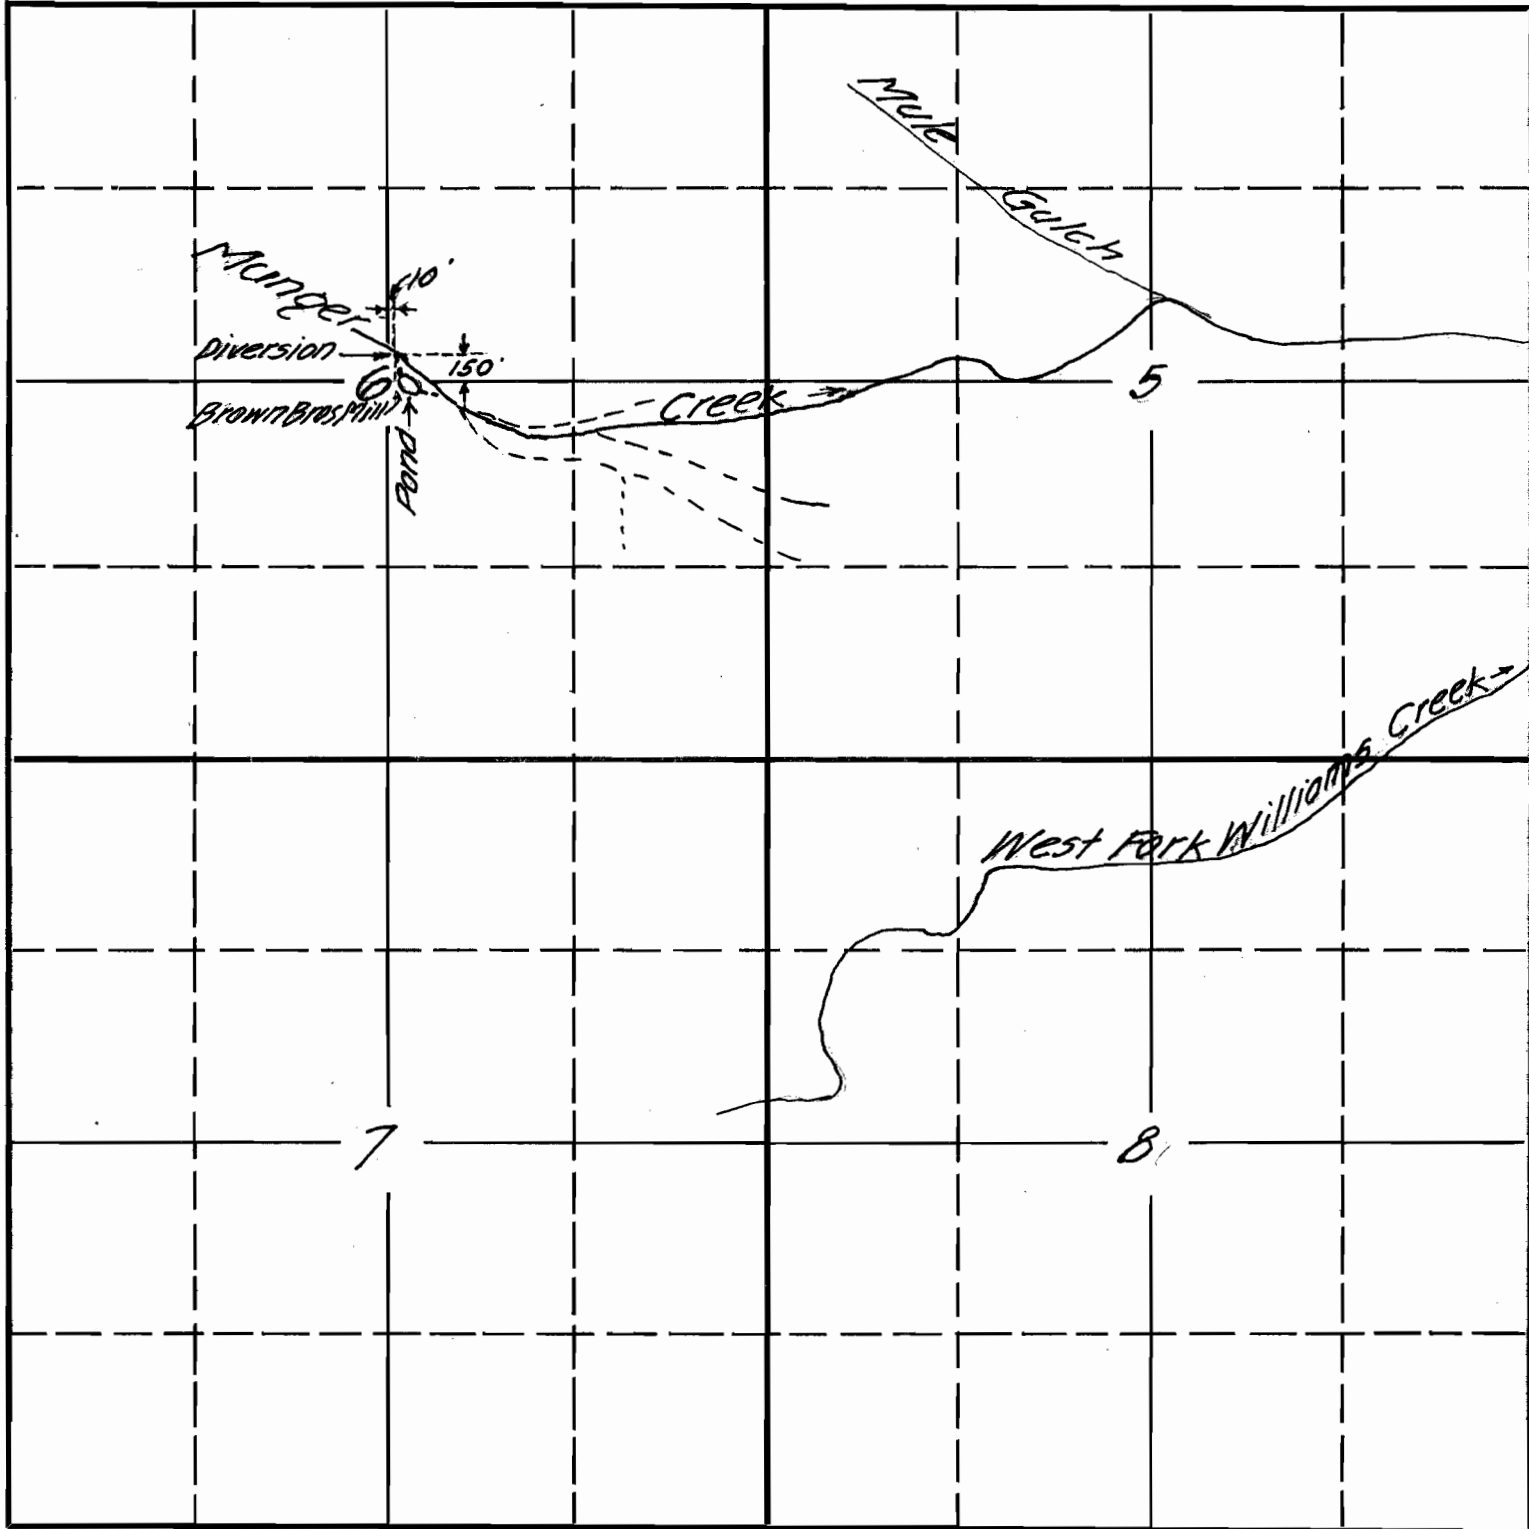

Brown Bros, (H.E. Brown, Partner)
Feb. 1943

14852 OK
15-16 B
P-15431

Appt. 19852

