

sec. 25


26

35

36

Tp. 35 S

R 7 W

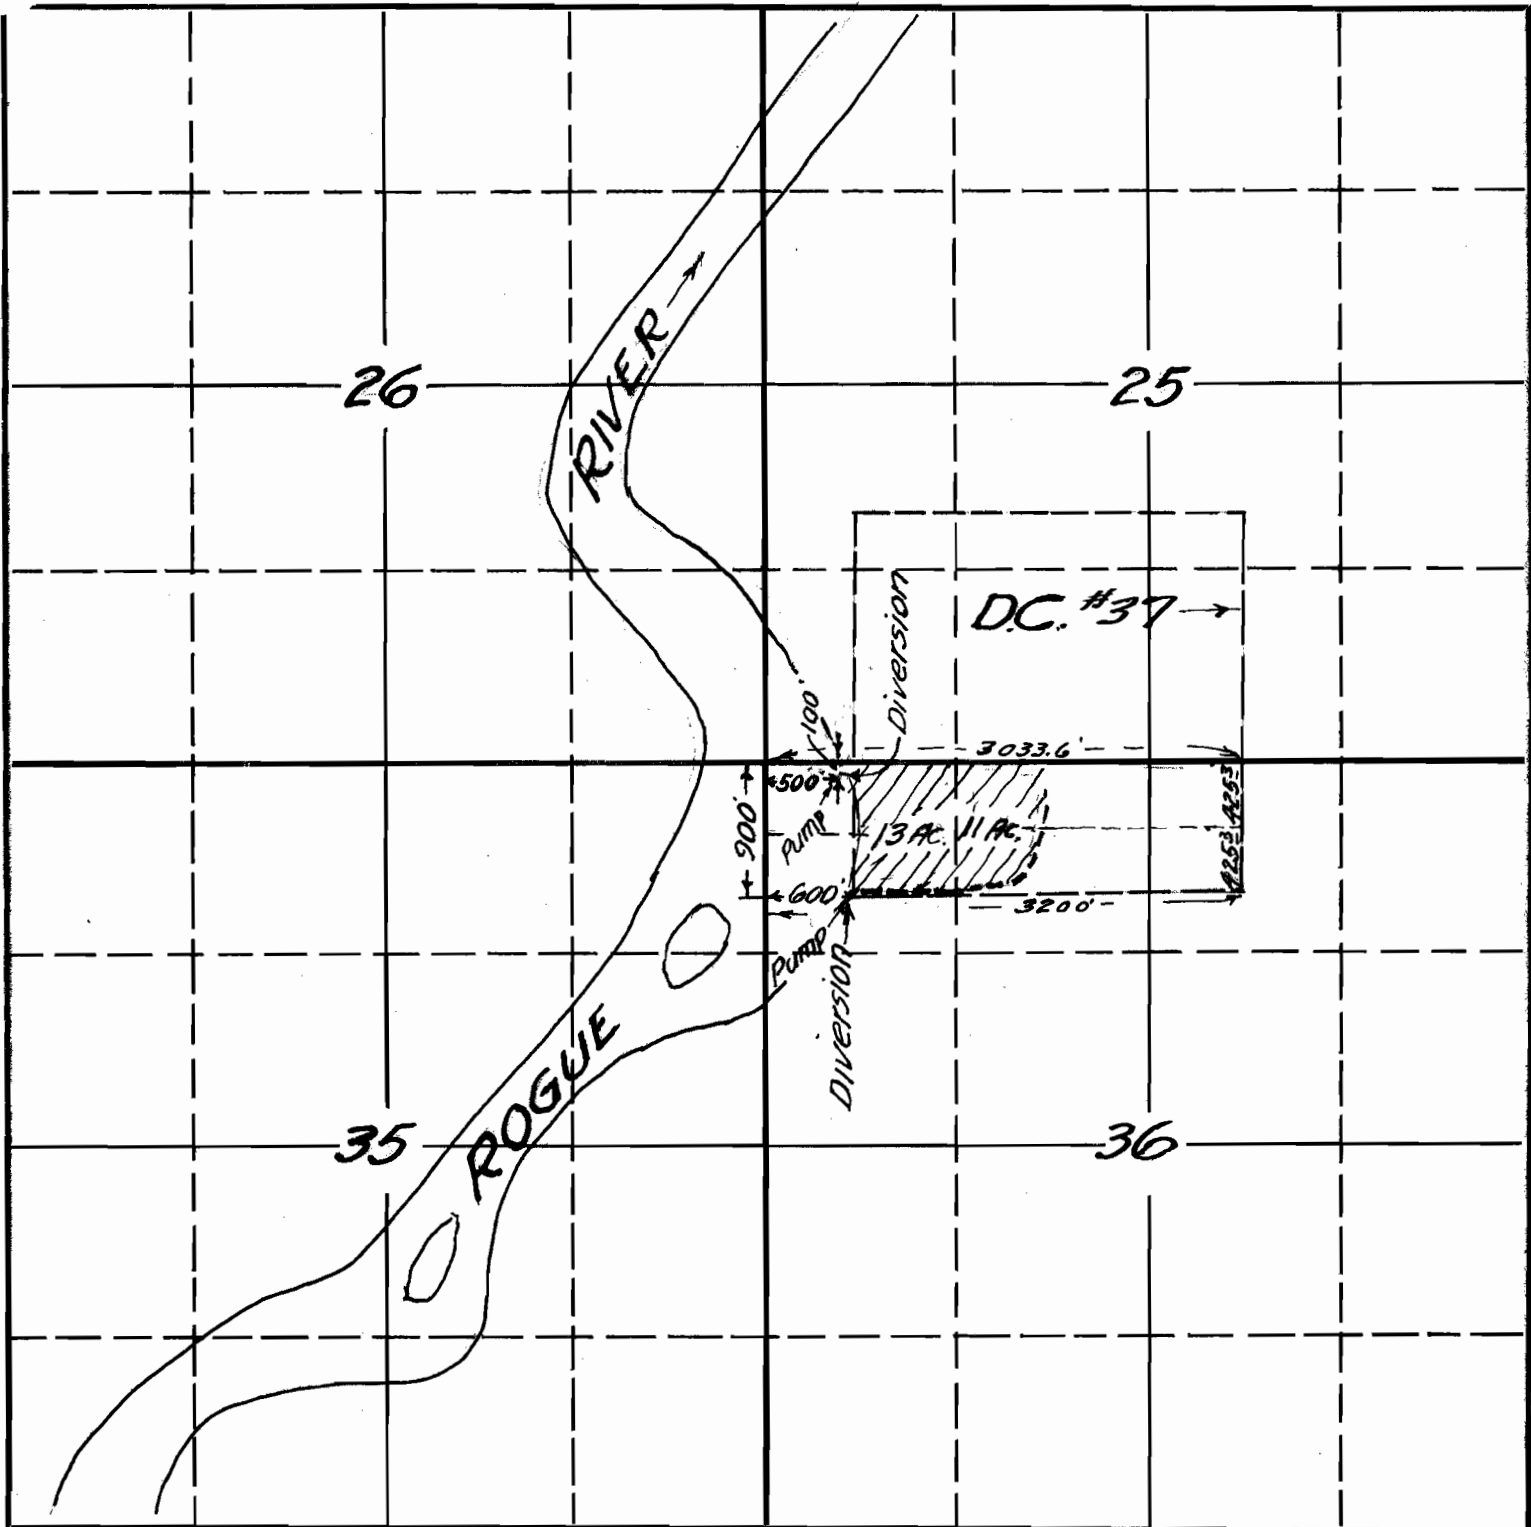

R.E. Stephenson  
Feb. 1943.

19855 CR  
15-60 A  
P-15434