


22

TOWNSHIP 38 S, RANGE 4 W, W. M.

North

West

East

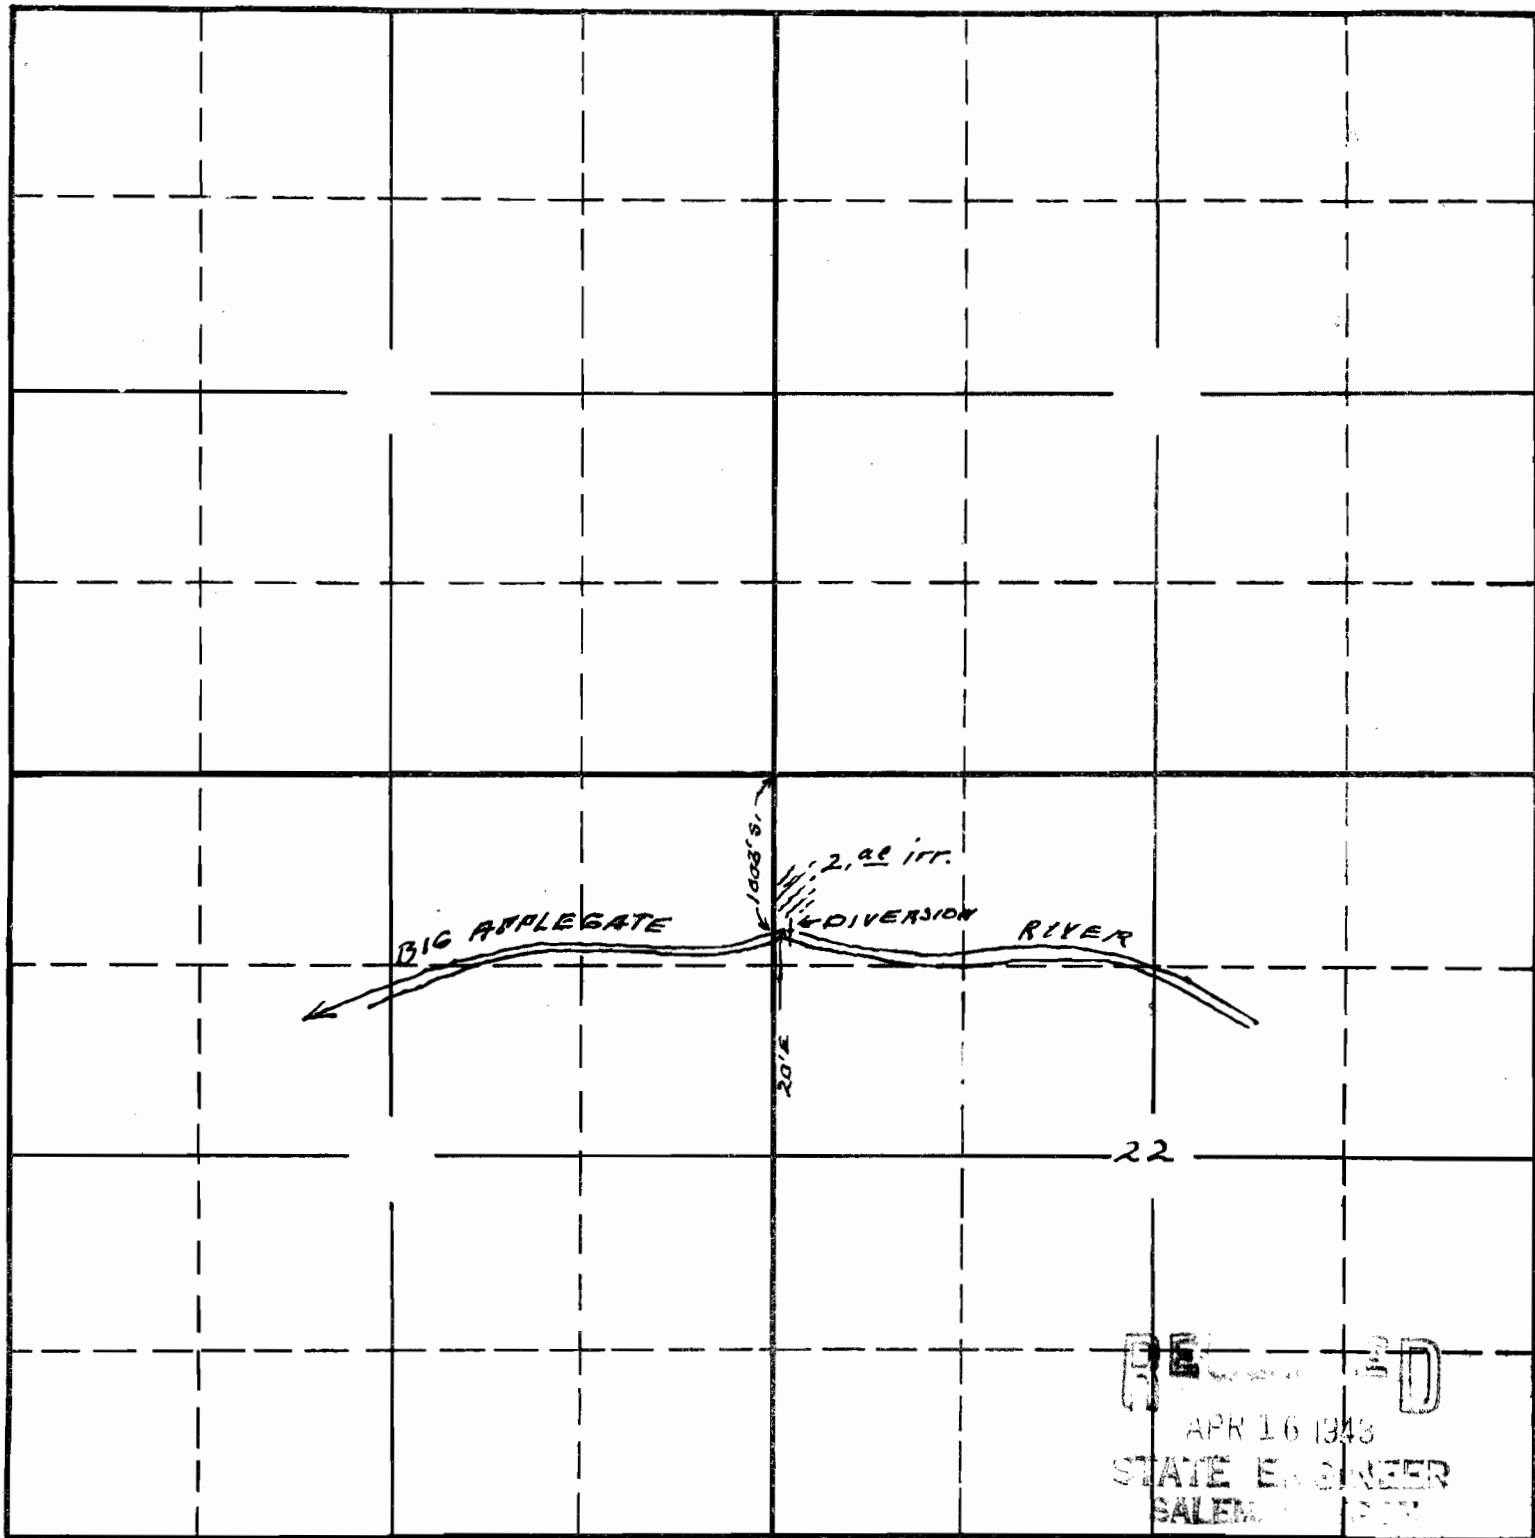

RECORDED
 APR 16 1948
 STATE ENGINEER
 SALEM, ORE.

South
 Sketch to accompany application of
 Lester E & Hallie Parker for use of waters of
 Big Applegate River for irrigation purposes

11234
 APPLICATION No. 19894
 PERMIT No. 15461

This office of 2/13 & 1/2