


15

TOWNSHIP 36 S , RANGE 3 W , W. M.

North

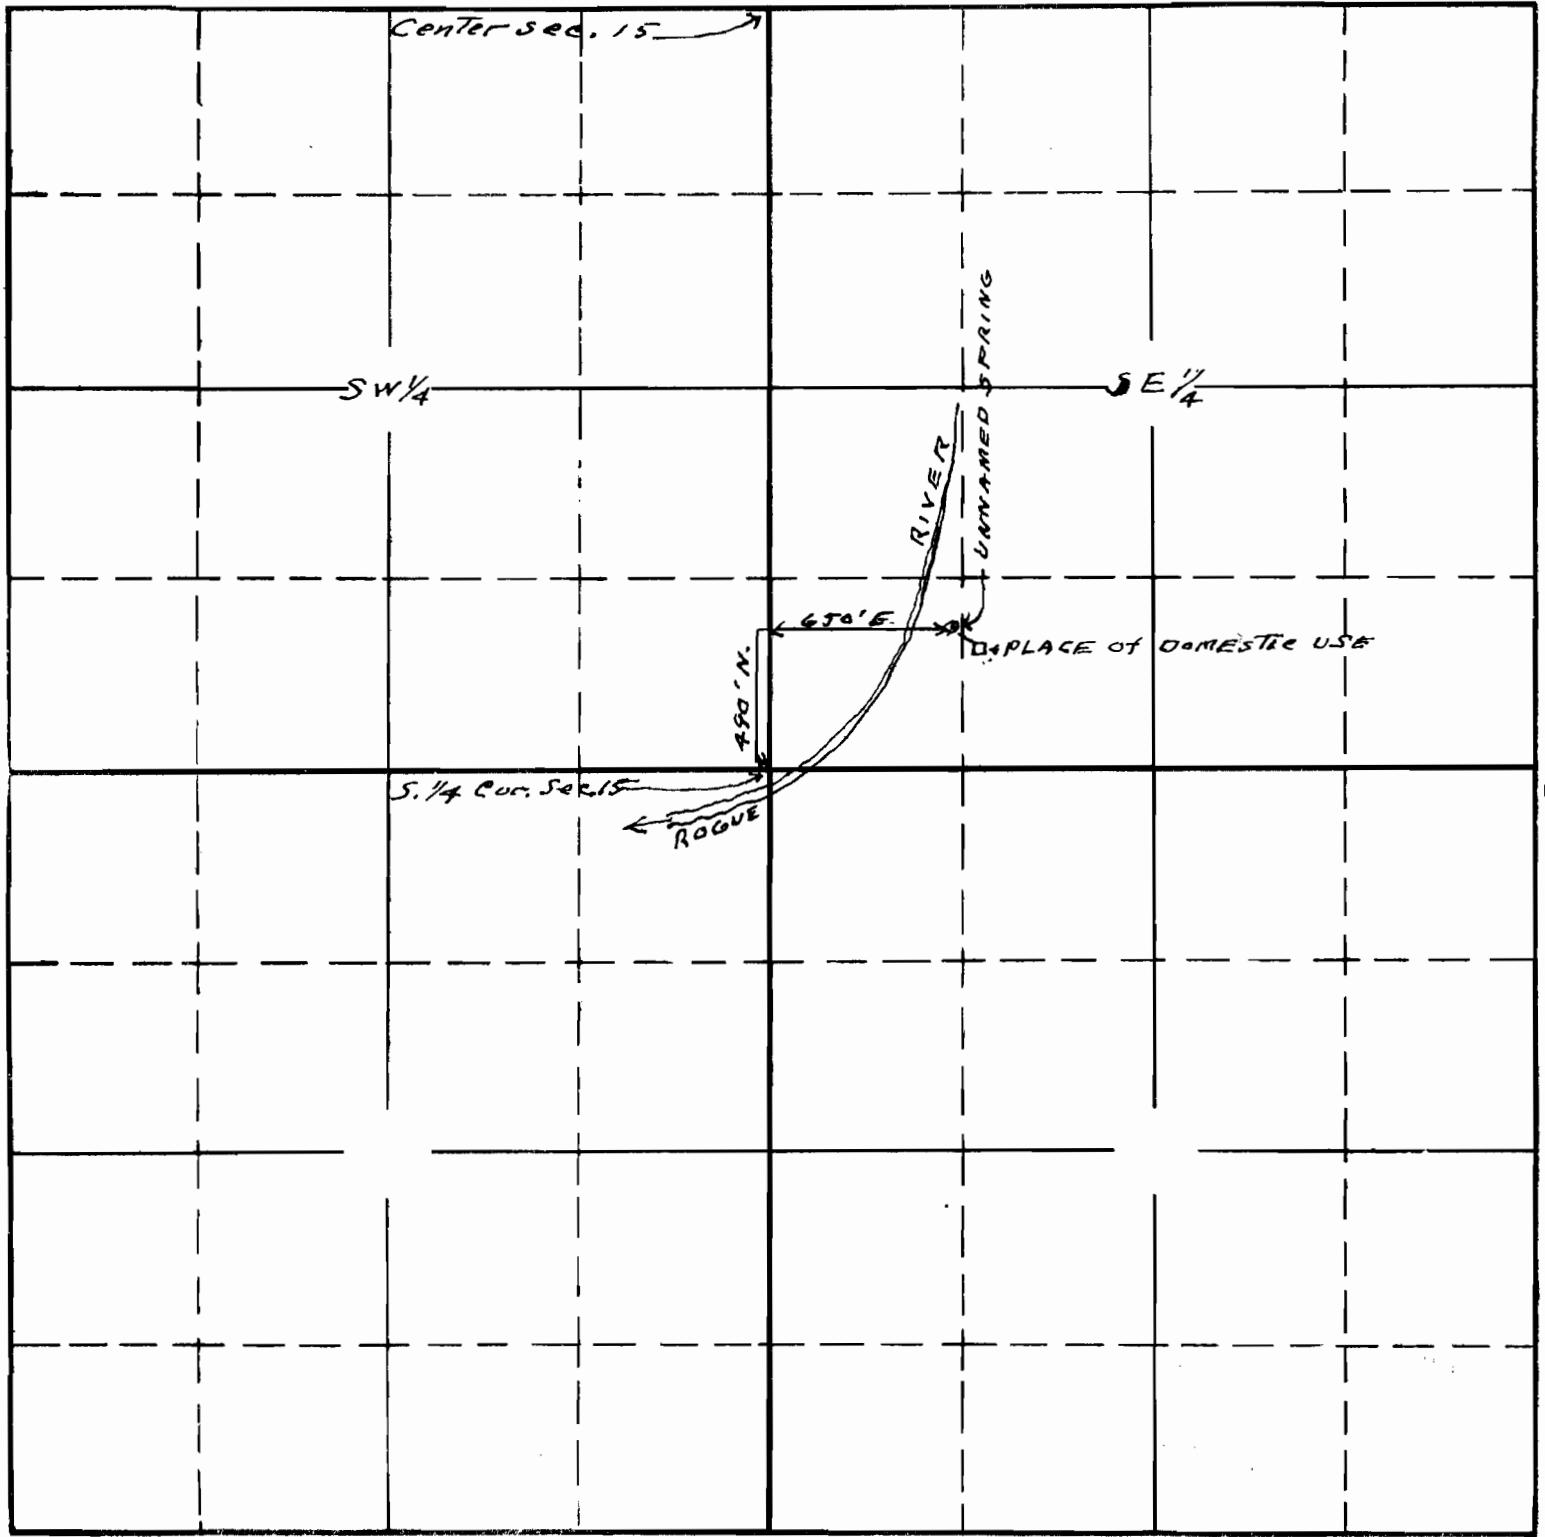

Sketch to accompany application of
 Ray Spencer for permit to use waters of
 Unnamed spring for domestic purposes

APPLICATION No. 19783
 PERMIT No. 15468

This office 9/1/42