


SECTION

TOWNSHIP 39S, RANGE 9W, W. M.

North

West

East

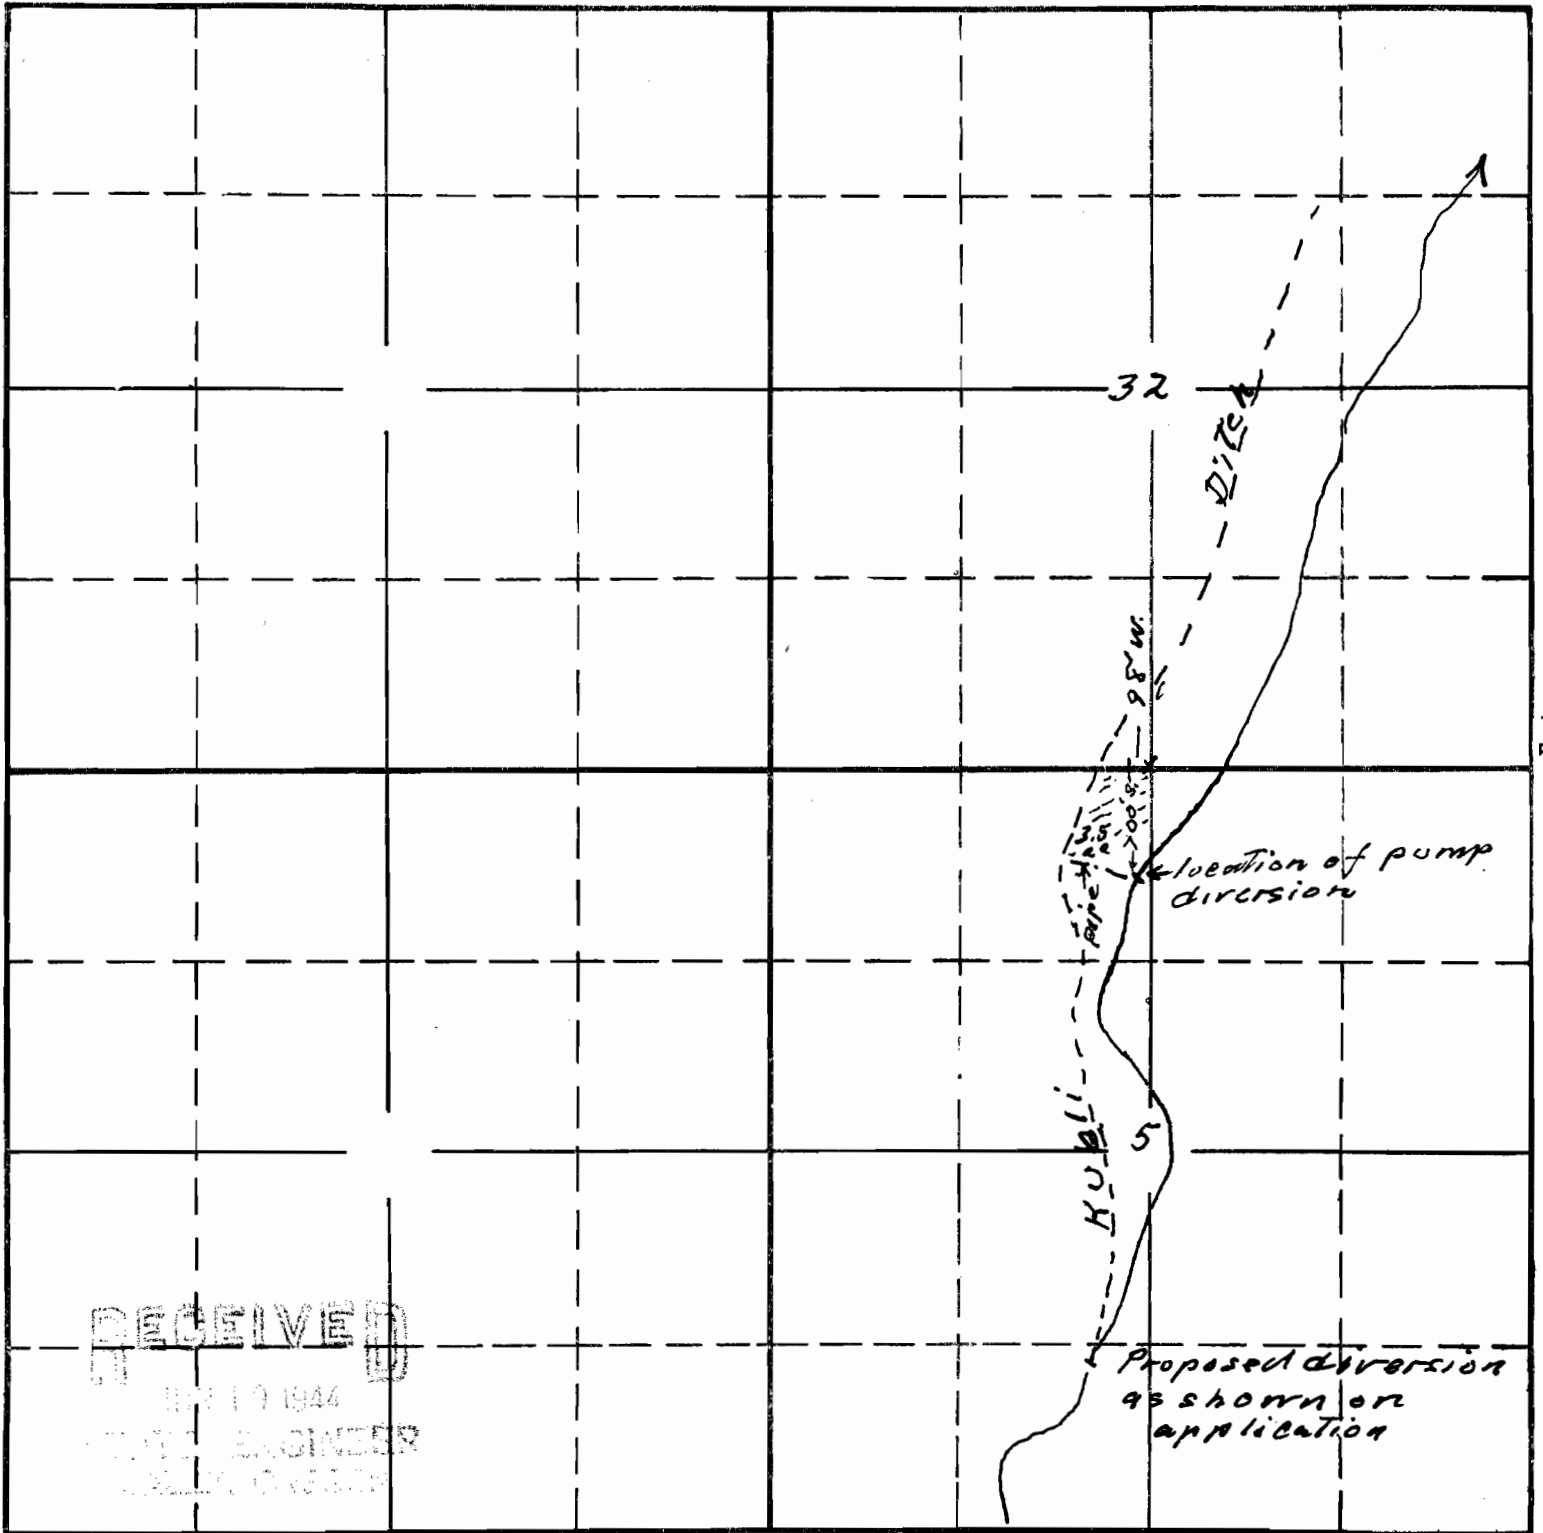

RECEIVED
 APR 19 1944

Map showing actual location of diversion Permit No 15531 in the name of Albert F White for use of waters of Thompson Creek for irrigation purposes


APPLICATION No.
 PERMIT No.

South

5

TOWNSHIP 39 S, RANGE 7 W, W. M.

North

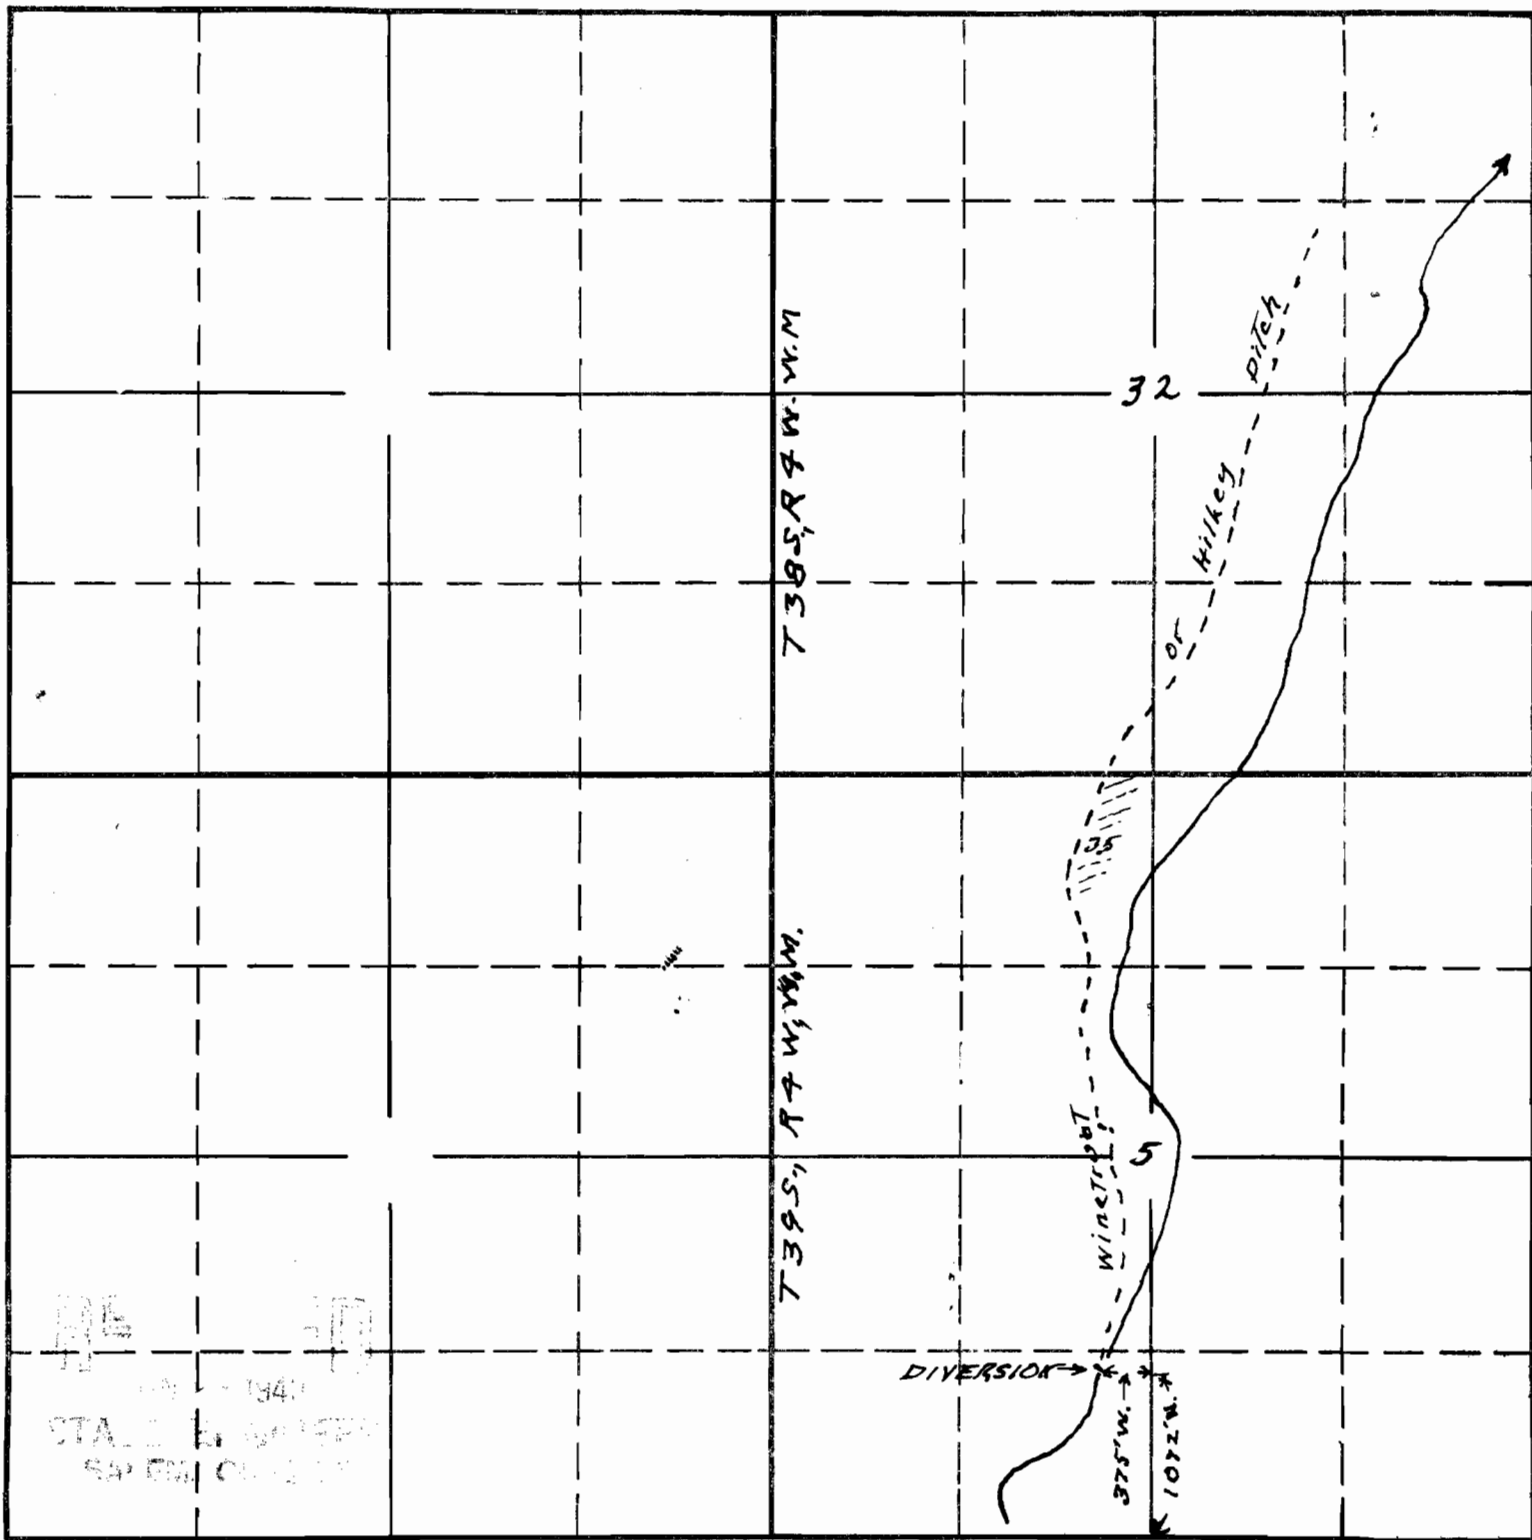

Map to accompany application ^{South} of
 Albert F White for use of waters of
 Thompson Creek for irrigation purposes

1940 152076
 15263
 APPLICATION No. 19960
 PERMIT No. 15531

This office - 6/24/43 [Signature]