


3

TOWNSHIP 38 S, RANGE 3 W, W. M.

North

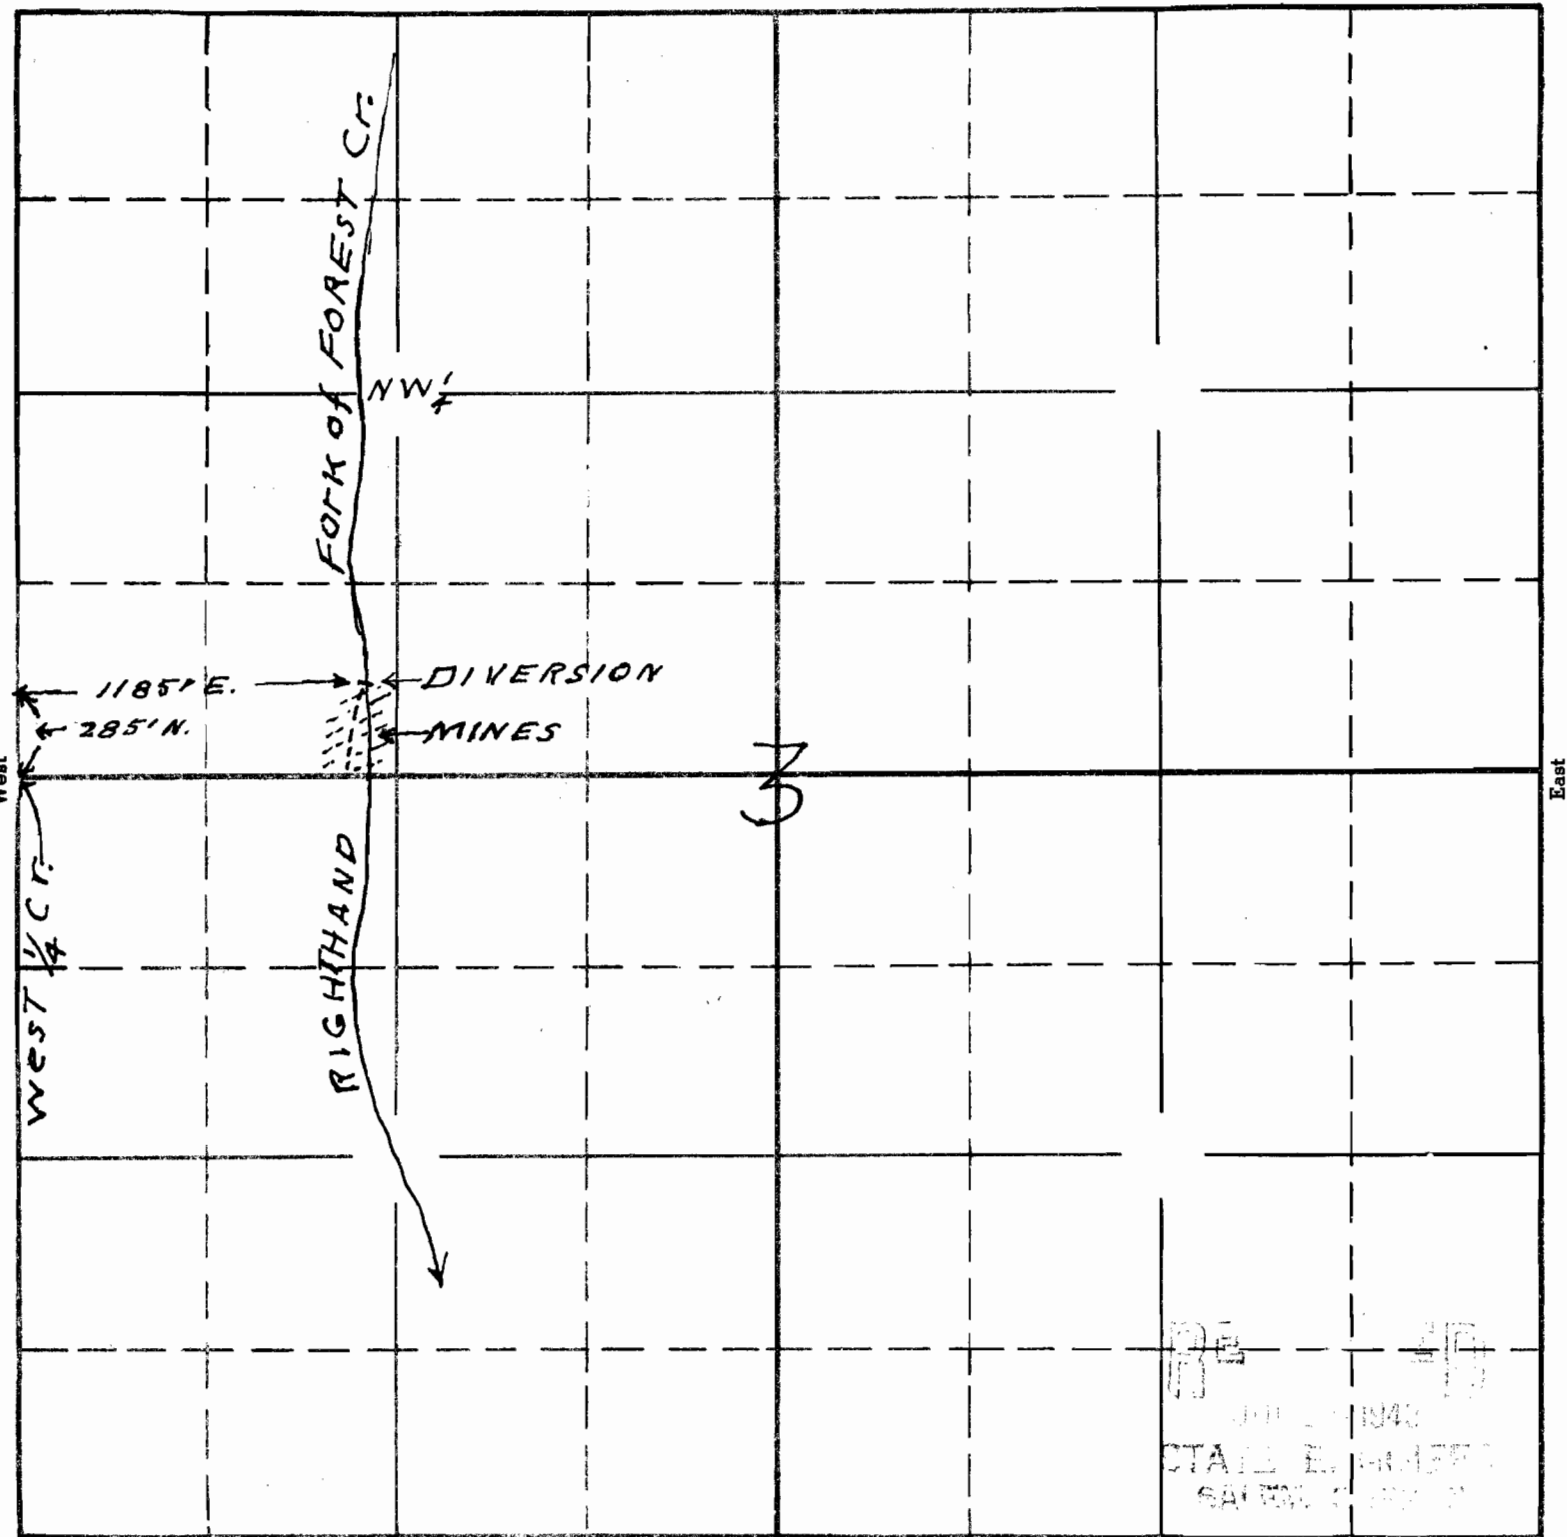

South

RE-40
 JUL 21 1943
 STATE ENGINEER
 SALEM, ORE.

19977

15543

Sketch to accompany application of
 Eric Lundgren for use of waters of
 Right Hand Fork of Forest Creek for
 Mining purposes.

APPLICATION No. 19977
 PERMIT No. 15543

This office 7/12/43 *W. Smith*