


17

TOWNSHIP 33 S, RANGE 1 W, W. M.

North

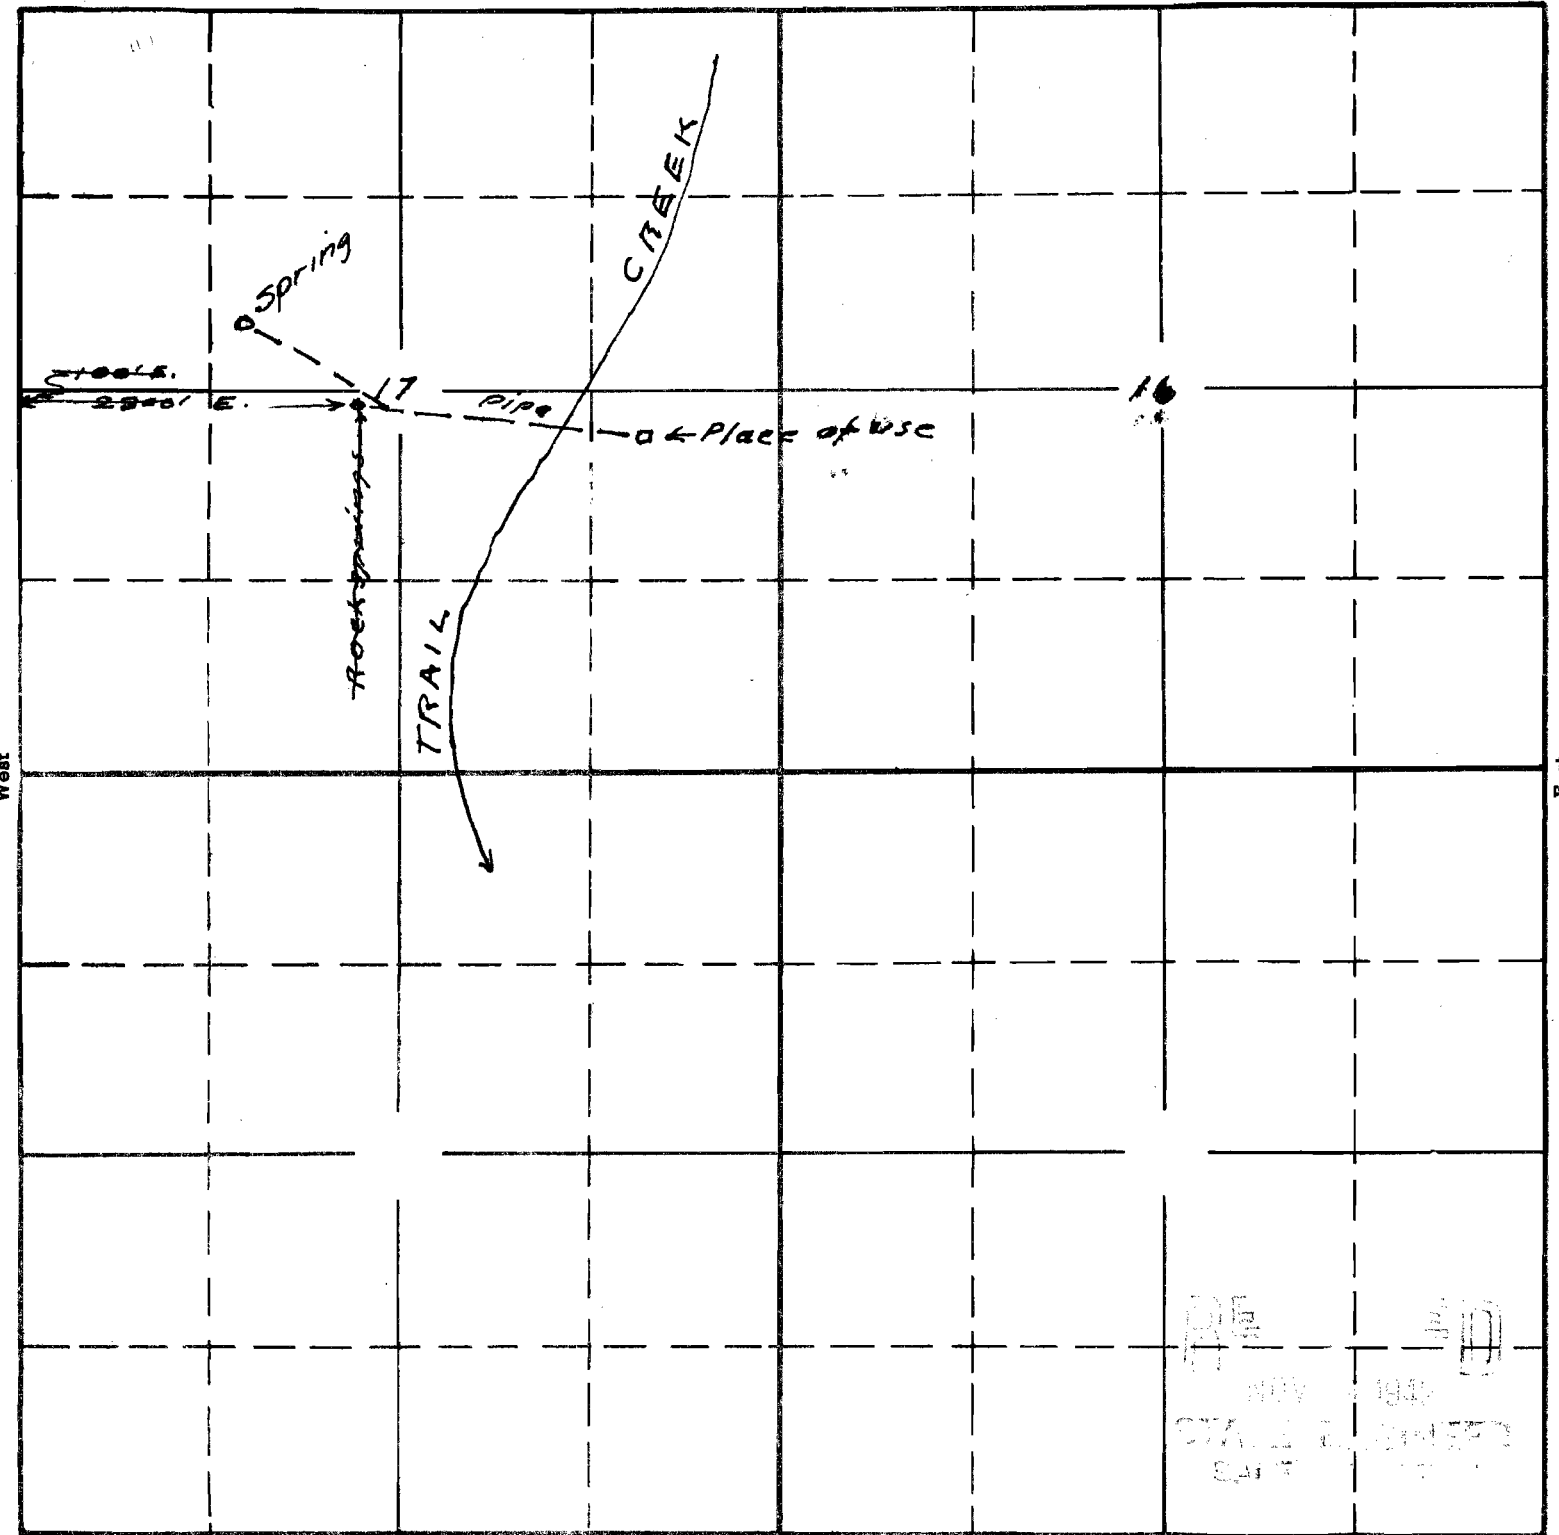

Sketch to accompany application of
 Walter D Oliver for use of waters of
 Rock Springs for domestic, stock
 and 1/2 acre of garden.

1941
 15-18 A
 APPLICATION No. 19991
 PERMIT No. 15555

This office 10/14/42 *[Signature]*