


TOWNSHIP 36 S, RANGE 6 W, W. M.

North

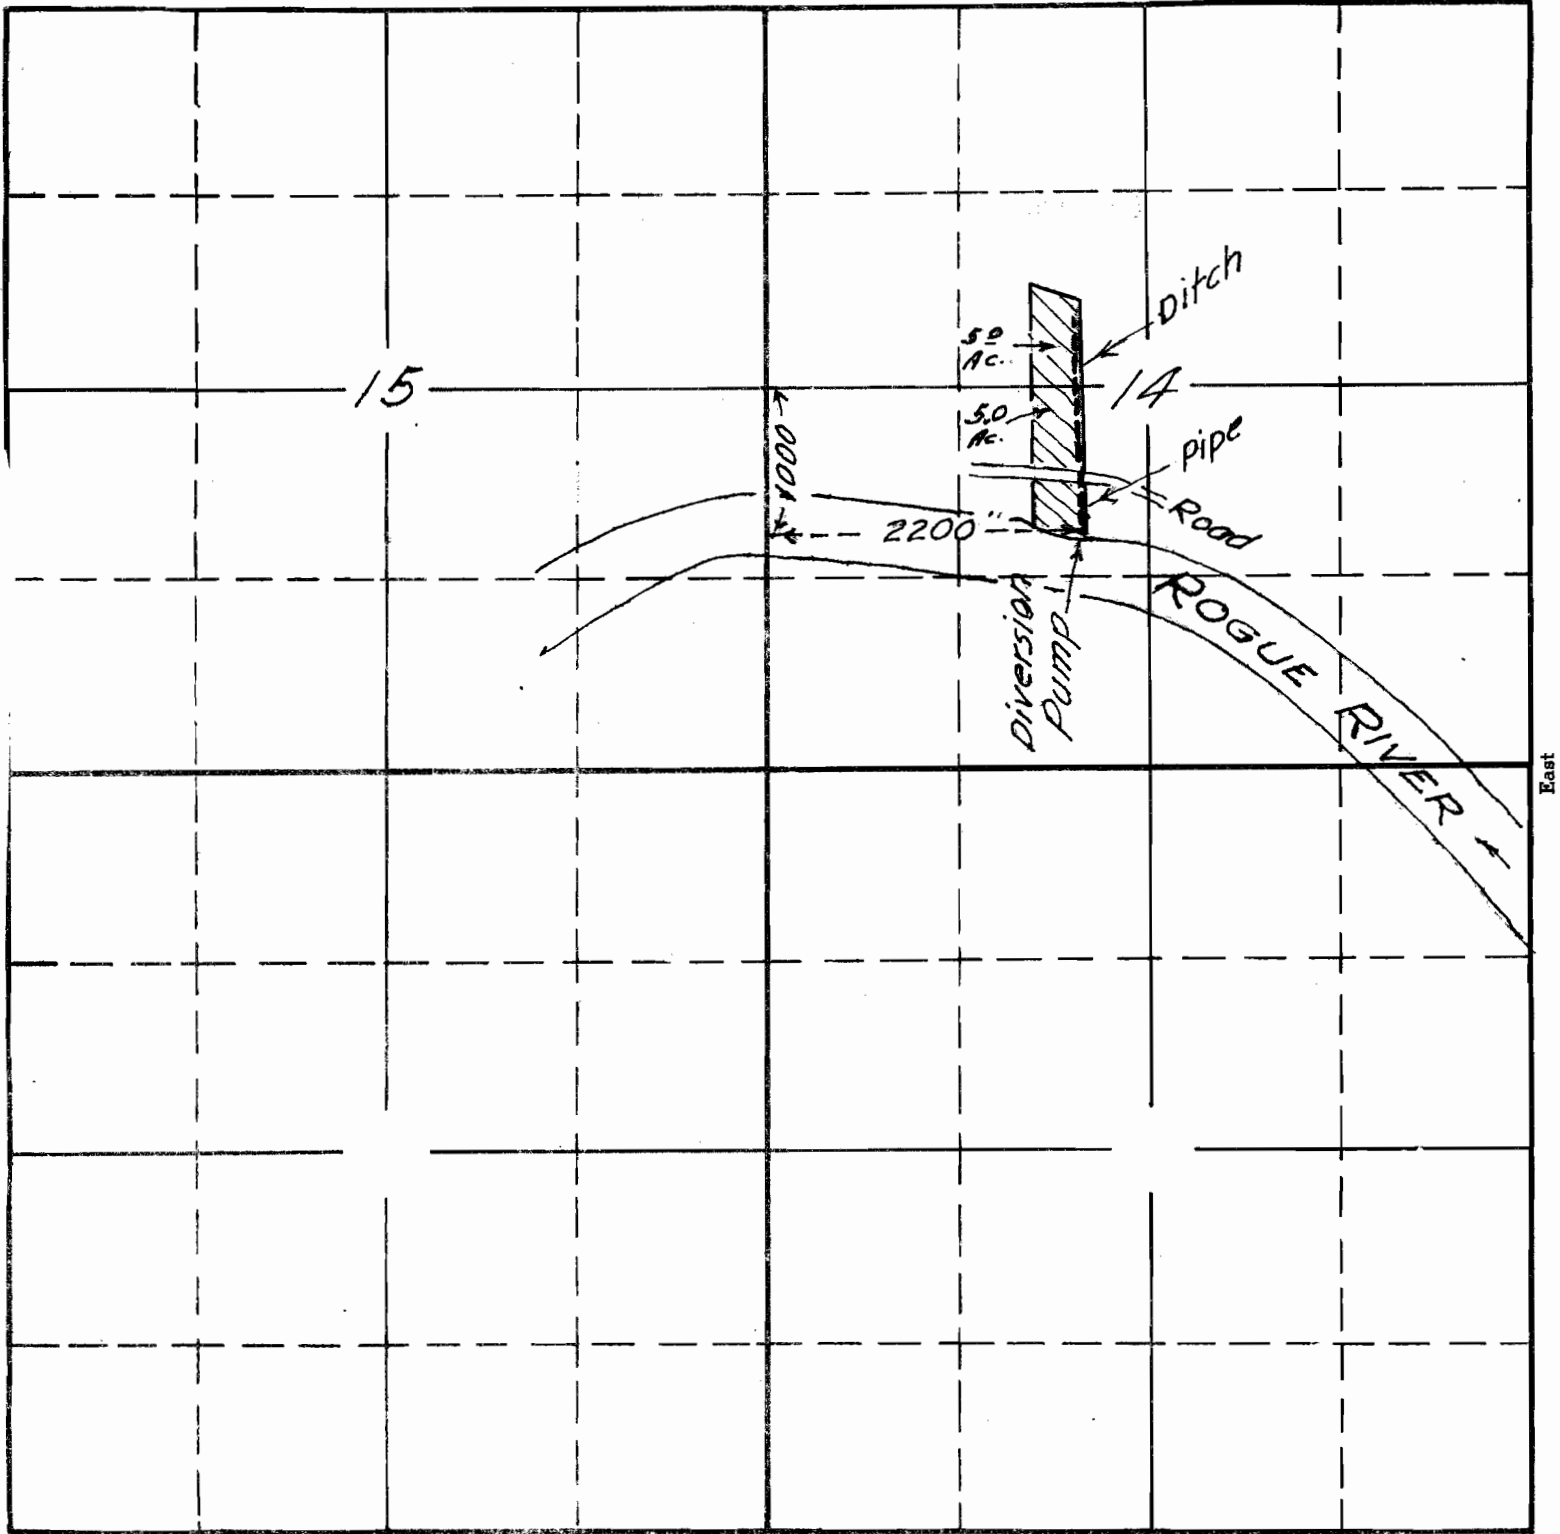

South

James Thomas Hillman
 and Elizabeth Hillman.
 July 1943

10 24 40
 12 20 2
 APPLICATION No. 19994
 PERMIT No. 15558

RE
 STA
 CHIT