


T. 37 S., R. 7 W., W.M.

Center of
Section 1.

E. 1/4 Cor.
Section 1.

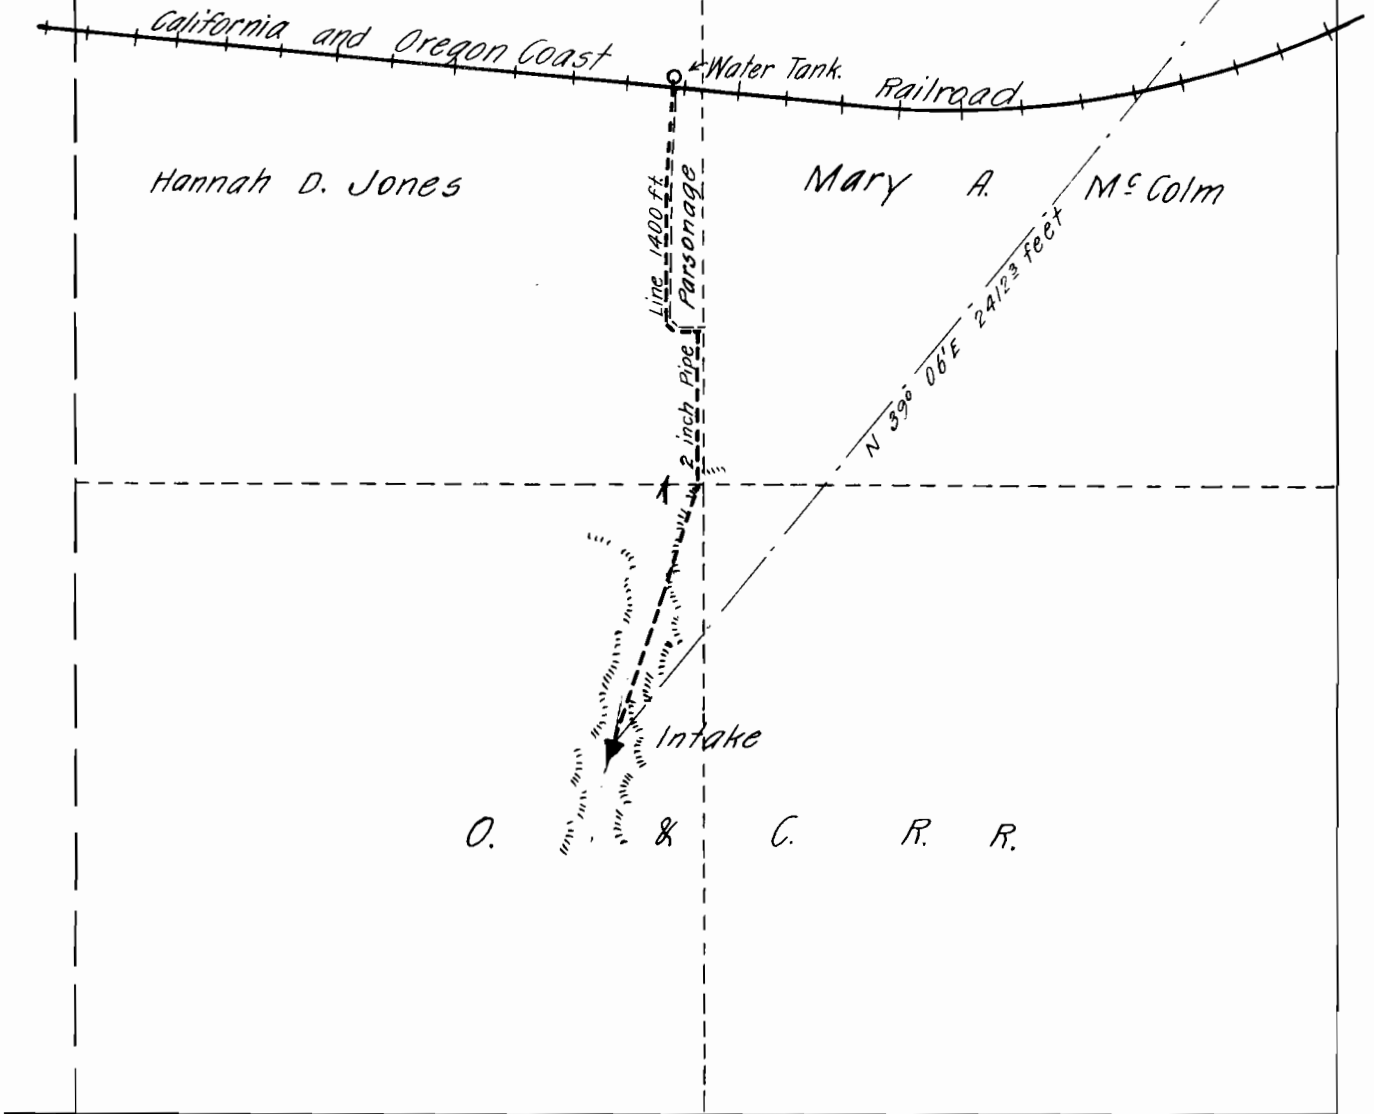

MAP ACCOMPANYING NOTICE OF COMPLETION OF
CONSTRUCTION OF WATER PERMIT NO 1556.
APPLICATION NO 2875.