


TOWNSHIP 40 S., RANGE 8 W., W. M.

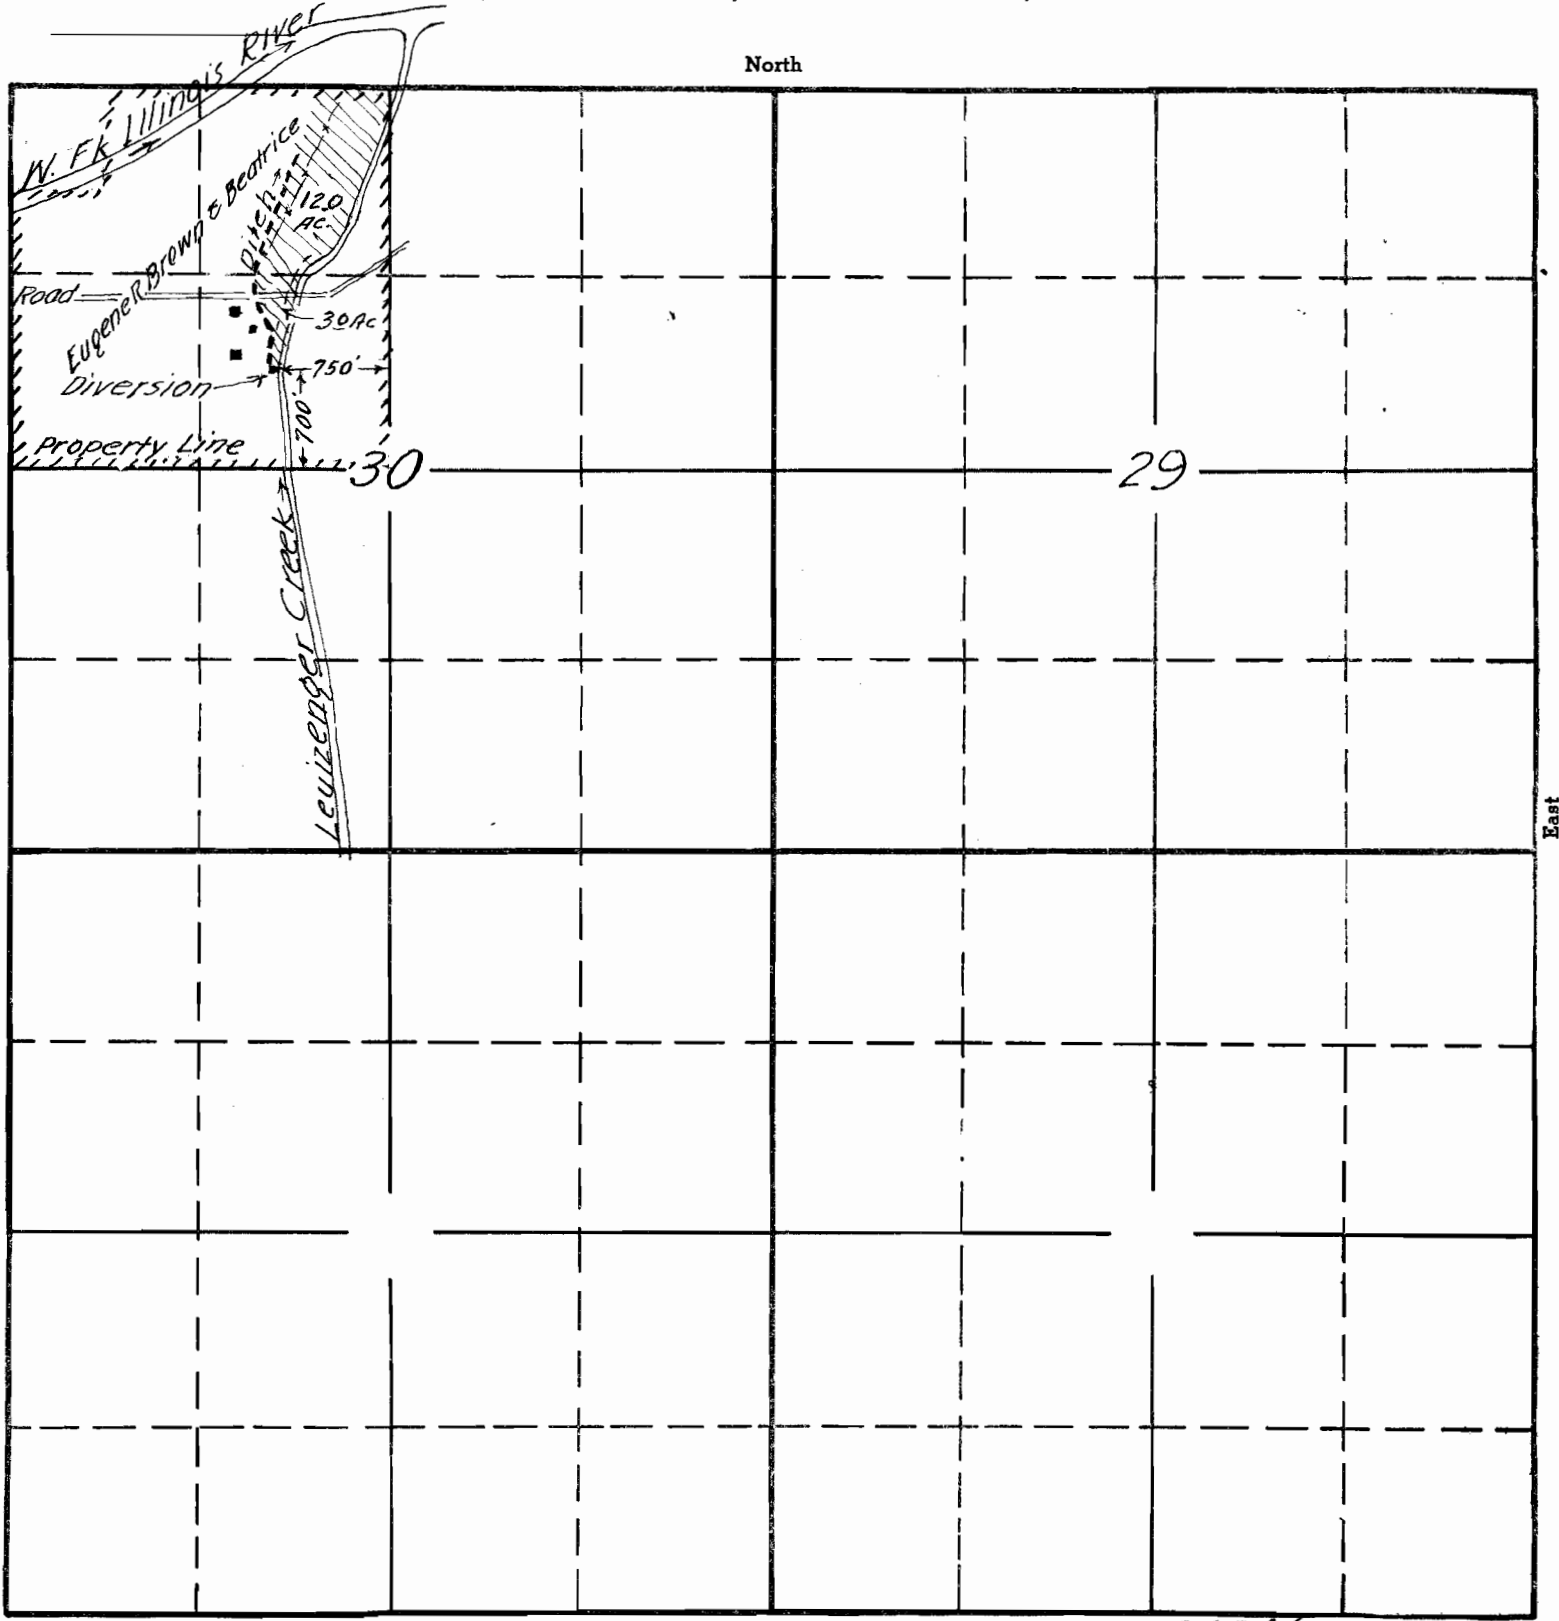

South

Eugene R. Brown  
Aug. 1943.

20006  
15-1-43

APPLICATION No. 20006  
PERMIT No. 15577

REC-111  
 1943  
 AUG 11 1943  
 COUNTY CLERK  
 ILLINOIS