


SECTION

TOWNSHIP 35 S., RANGE 7 W., W. M.

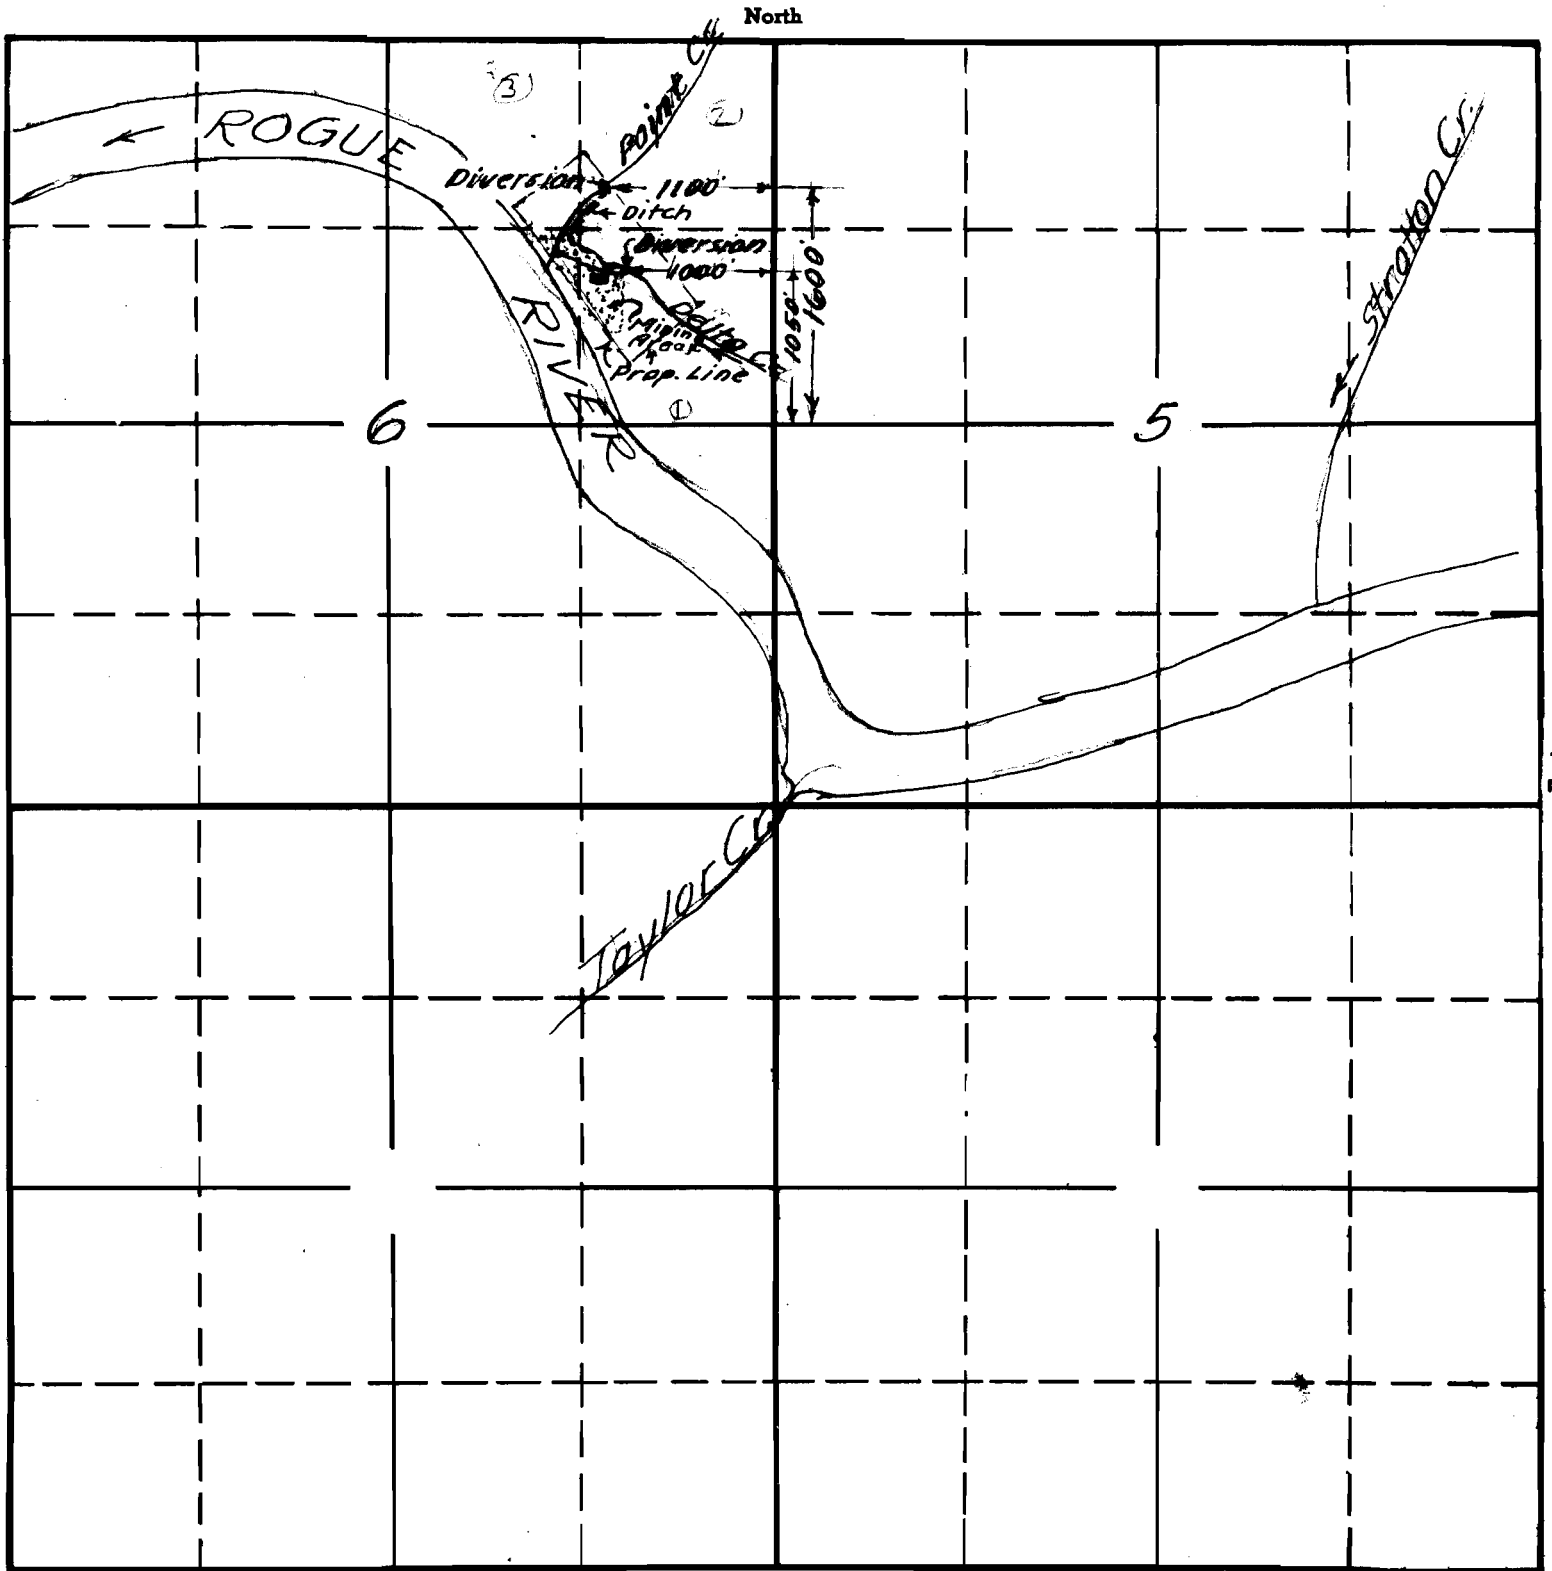

Harold A. Mahnke, Sr.  
Aug. 1943.

20013 OR  
15-78A  
APPLICATION No. 20013  
PERMIT No. 15584