


SECTION  
31

TOWNSHIP 32 S, RANGE 6 W, W. M.

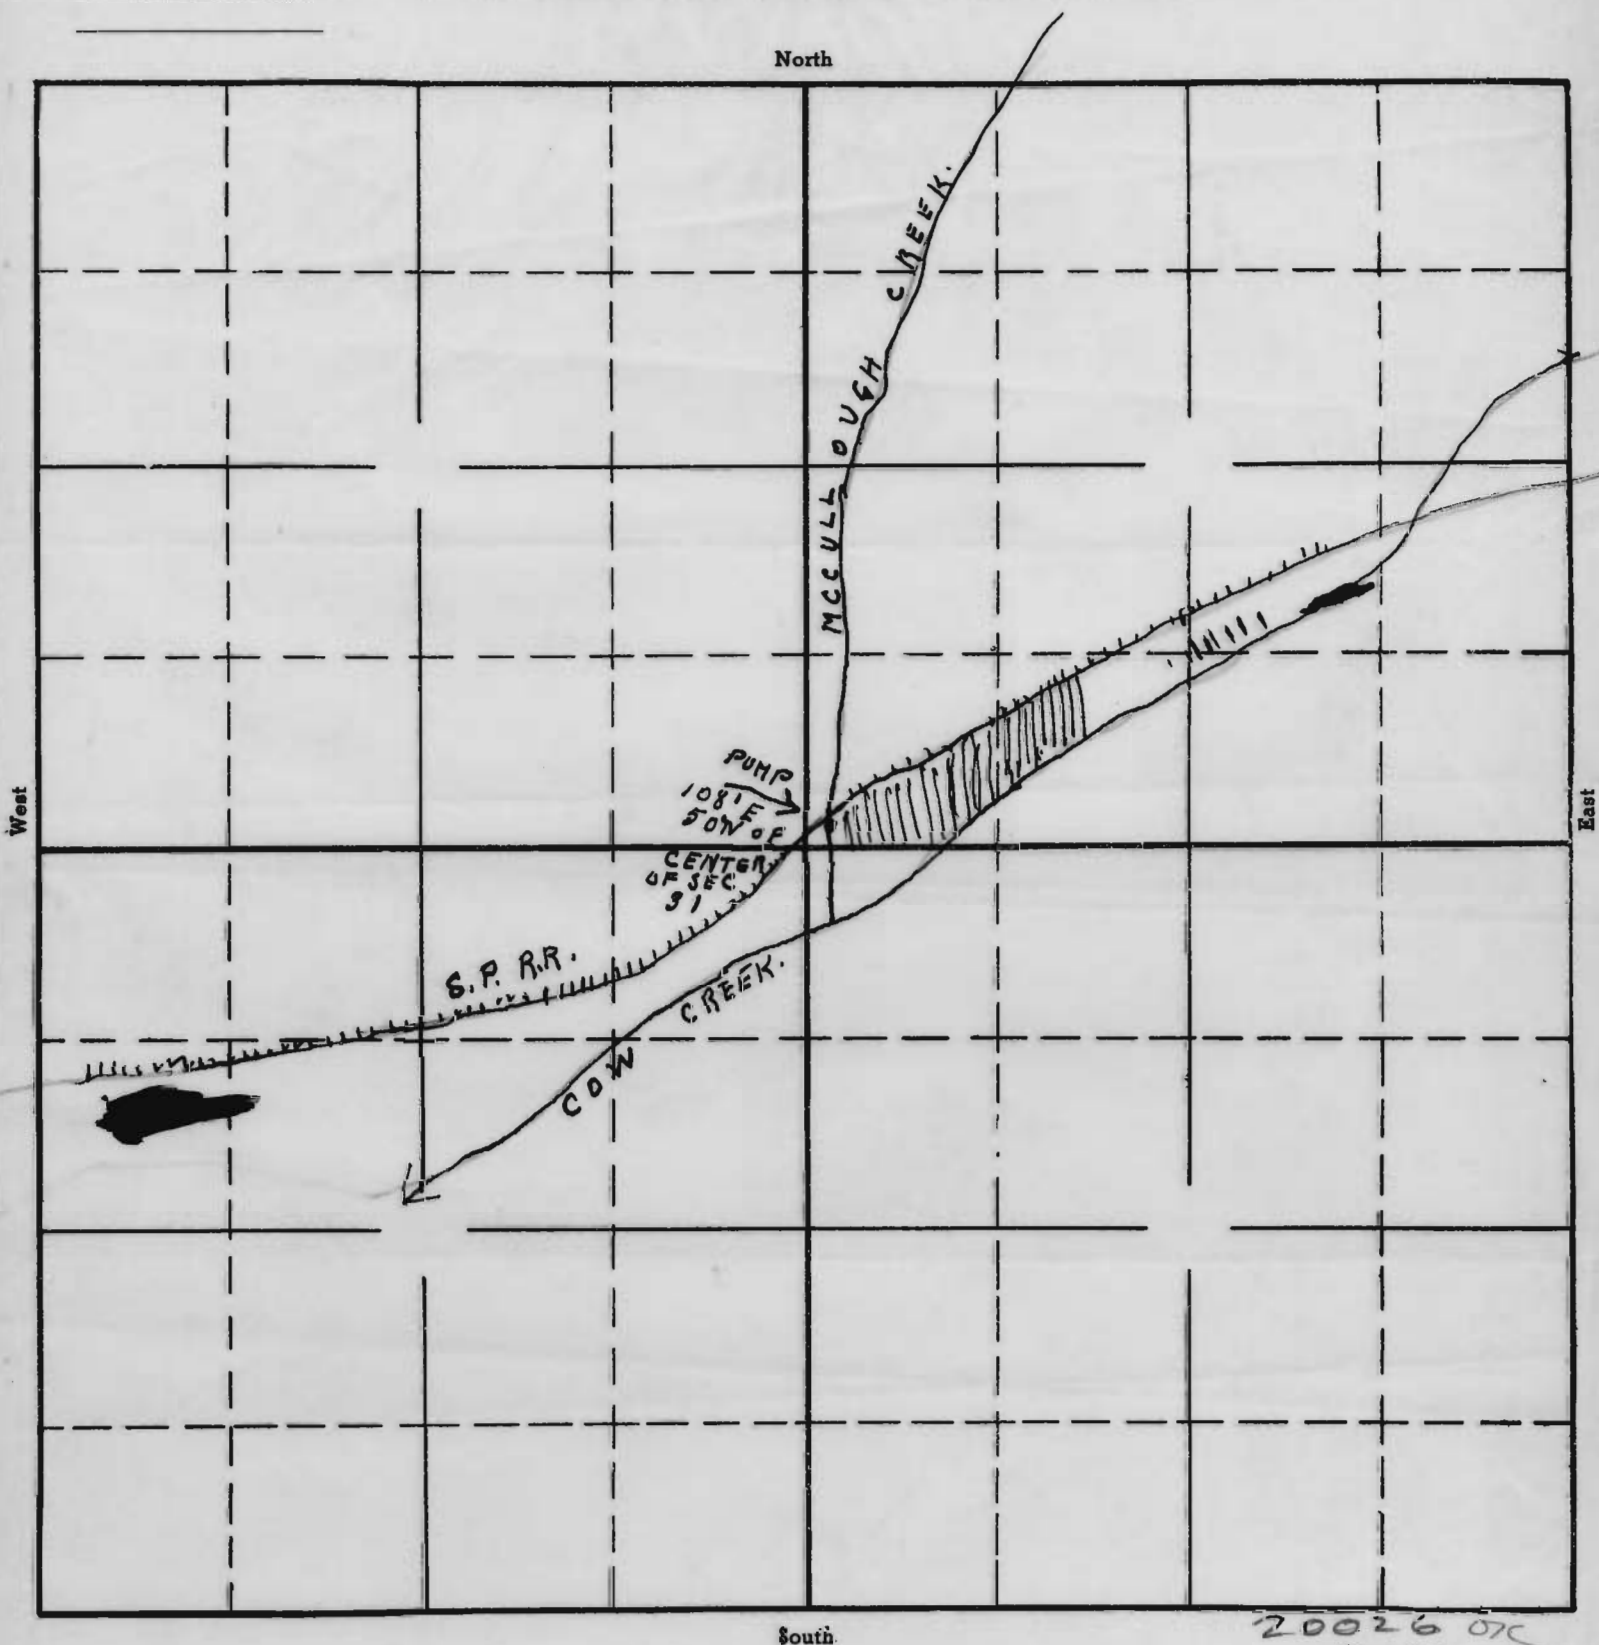

20026 ORC  
16-12  
APPLICATION No. 20026  
PERMIT No. 15597

RECEIVED  
SEP 2 1943