

SECTION


8

TOWNSHIP 35 SOUTH RANGE 7 WEST, W. M.

North

West

East

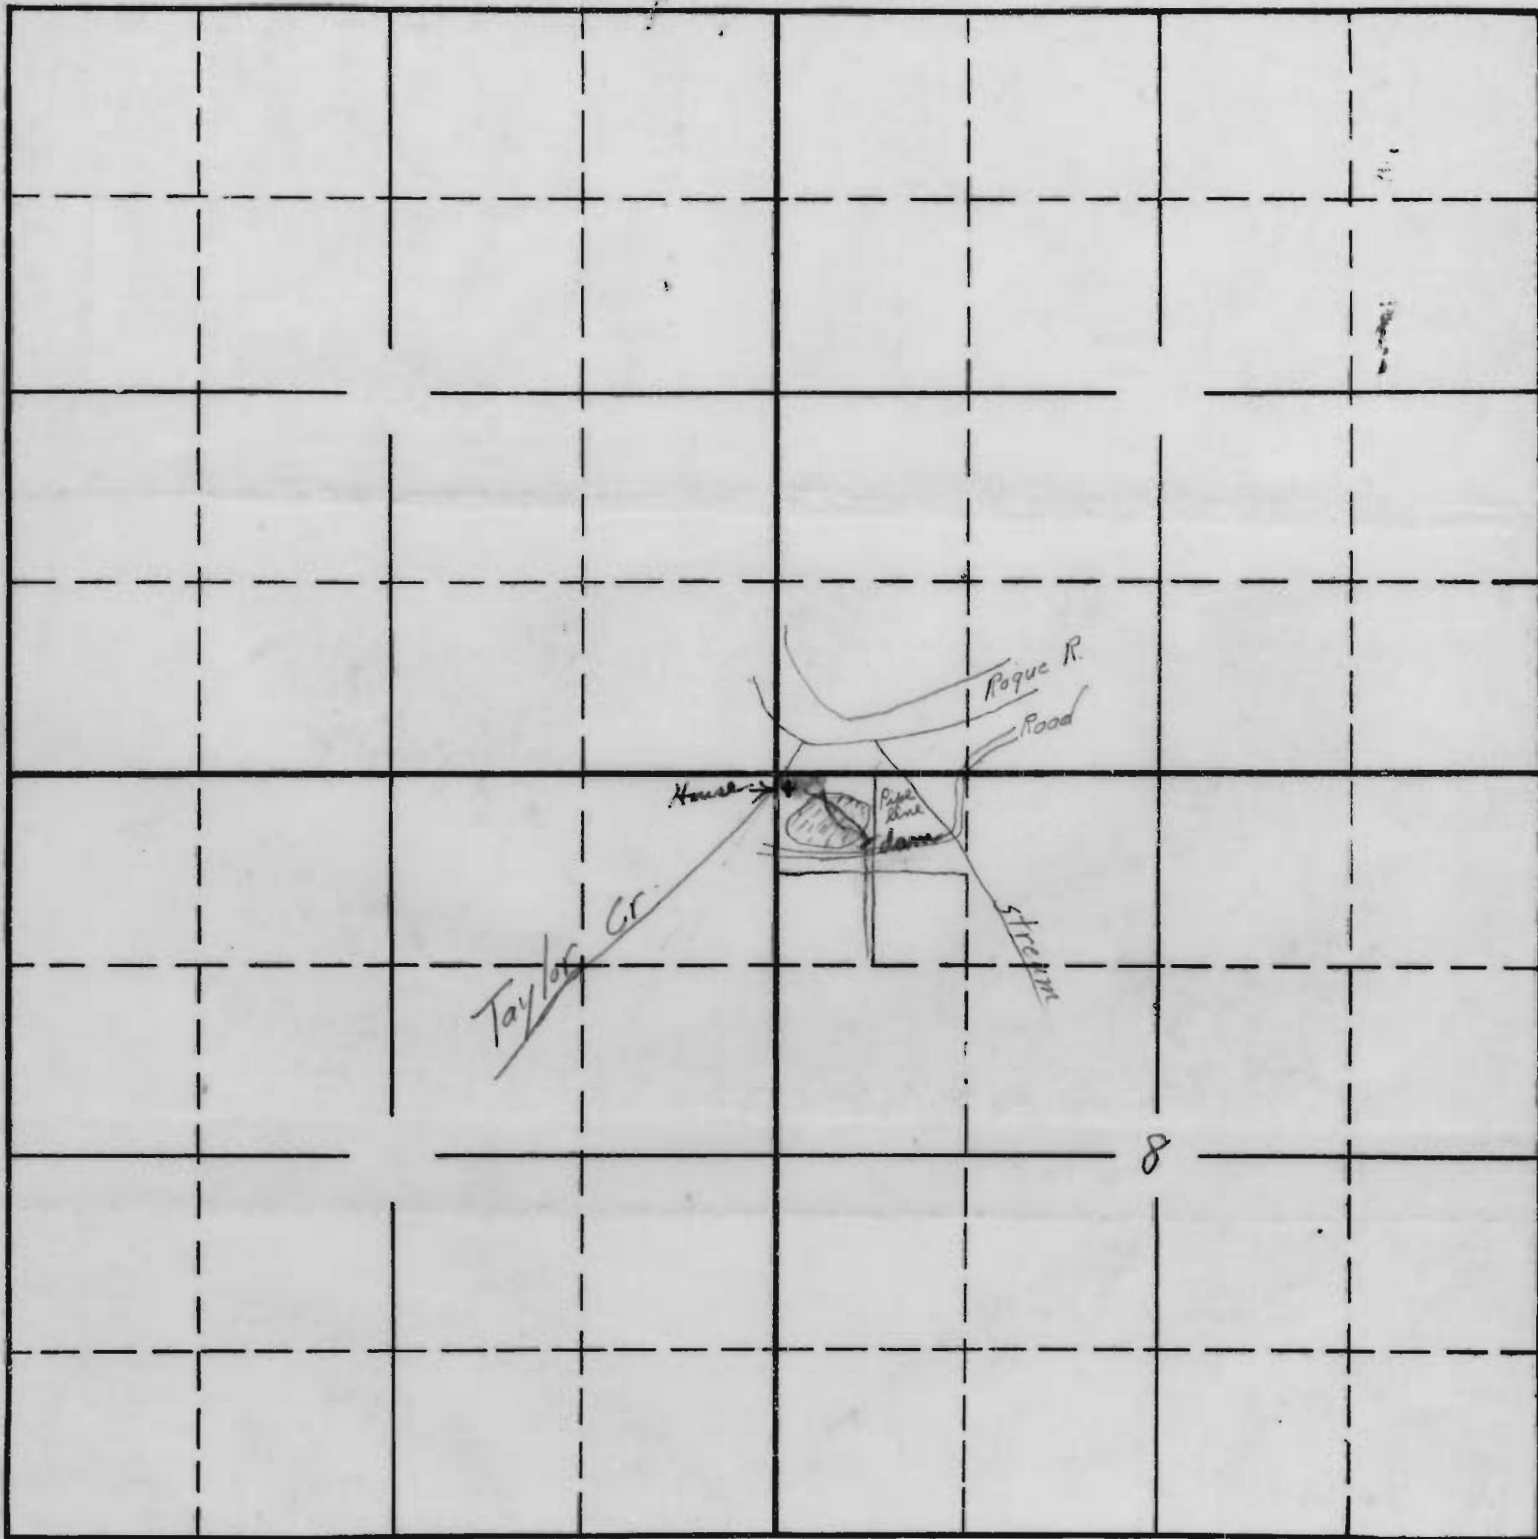

South

8

RECEIVED

SEP 10 1943

STATE ENGINEER  
SALEM, OREGON

20032 OR  
15-78A

APPLICATION No. 20032

PERMIT No. 15602