


Sec.

Tp. 35 S.  
R 5 W.

Permit: S 15652  
Volume: 5  
Strm: UNN STR  
Trib: LOUSE CR  
Priority: 11/08/43

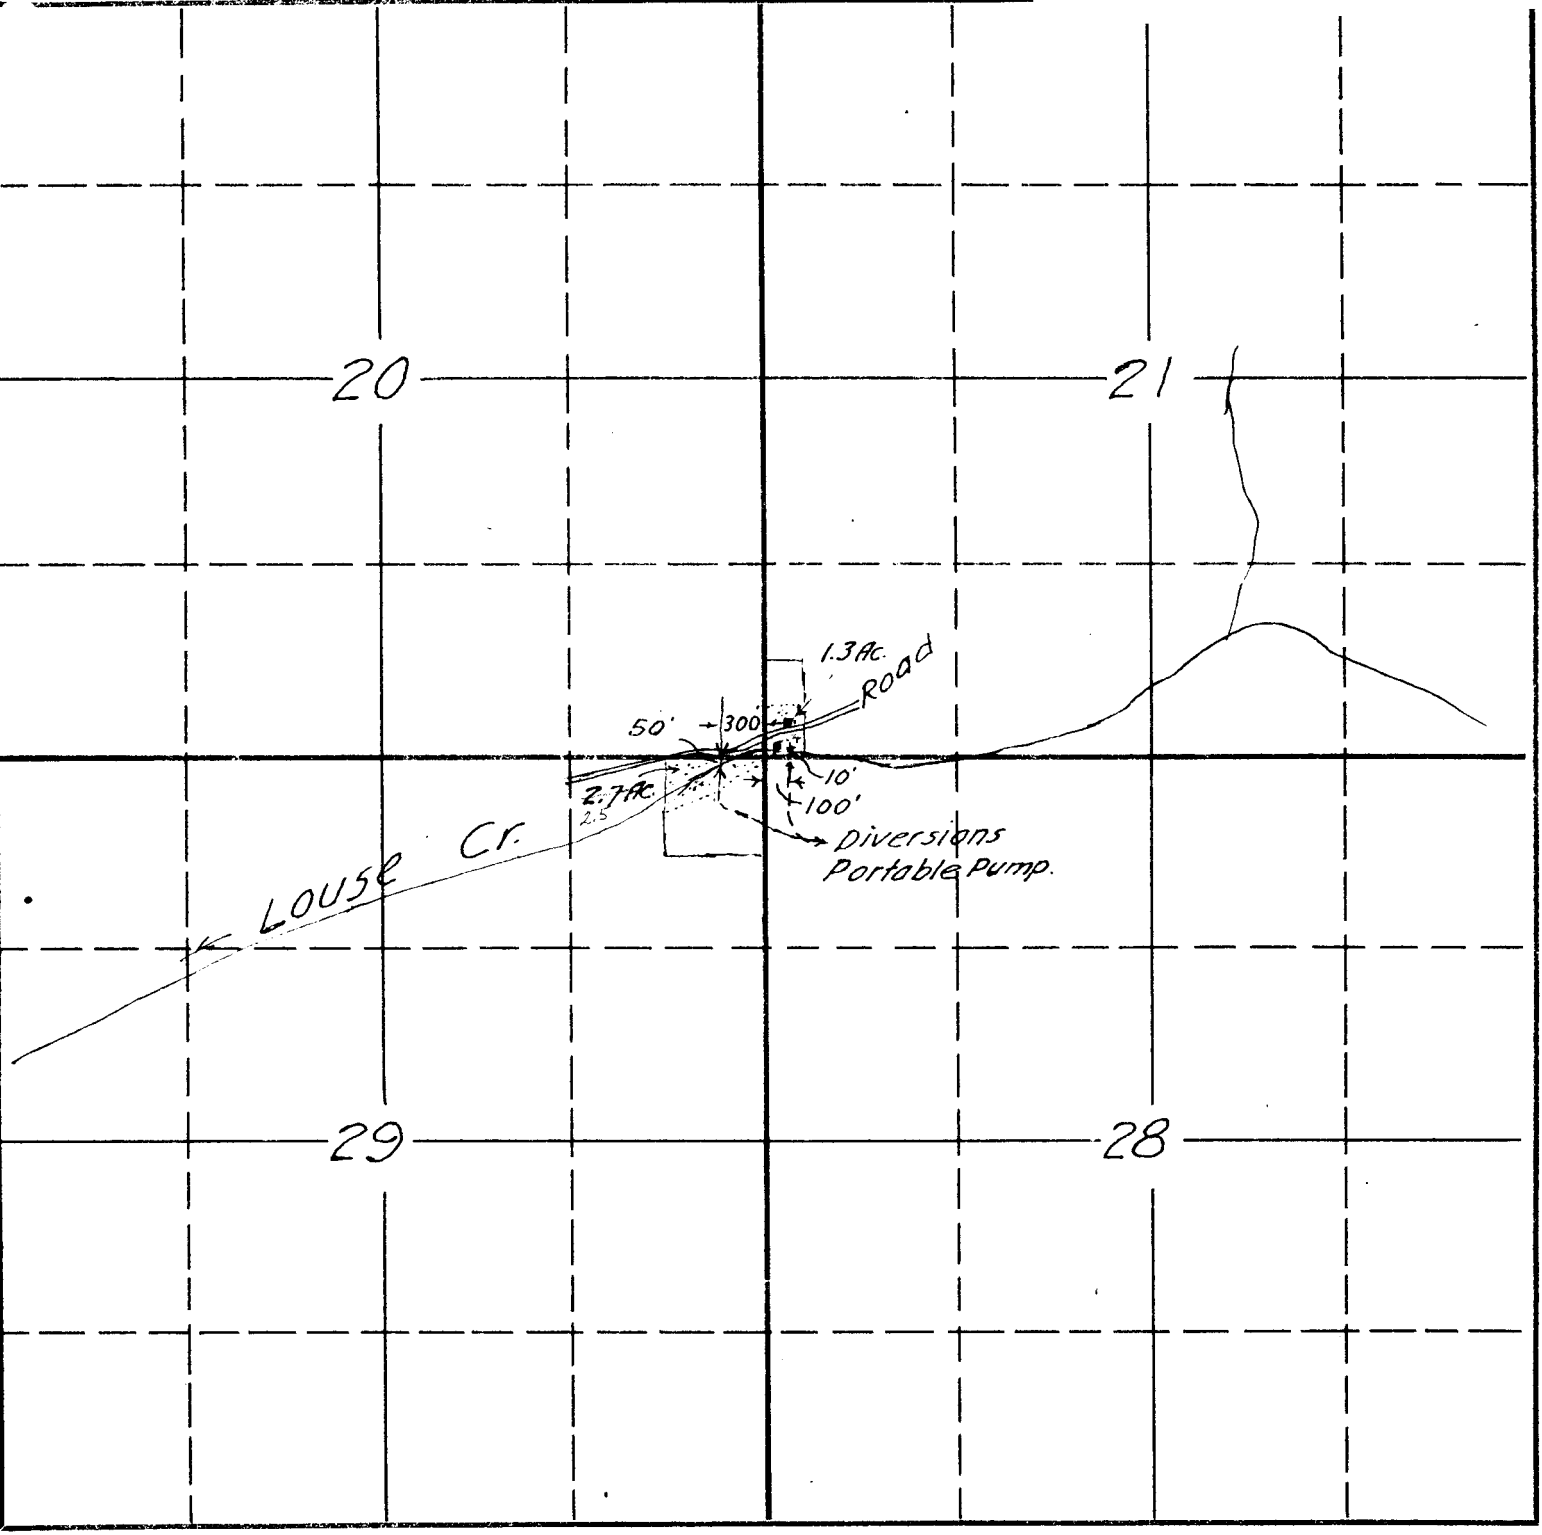

believe that the people in  
see 29 are taking water from  
stream and using it at all  
taking from Louse Creek.

Ludwig M. Akesson  
Nov. 1943

App'n No 20086  
Permit No 15652

Handwritten notes at the bottom right, partially illegible.